



PHOTOVOLTAIC SYSTEM INSTALLATION PLAN  
MADONNA ROAD APARTMENTS, SAN LUIS OBISPO, CALIFORNIA


ARRAY VIEW:

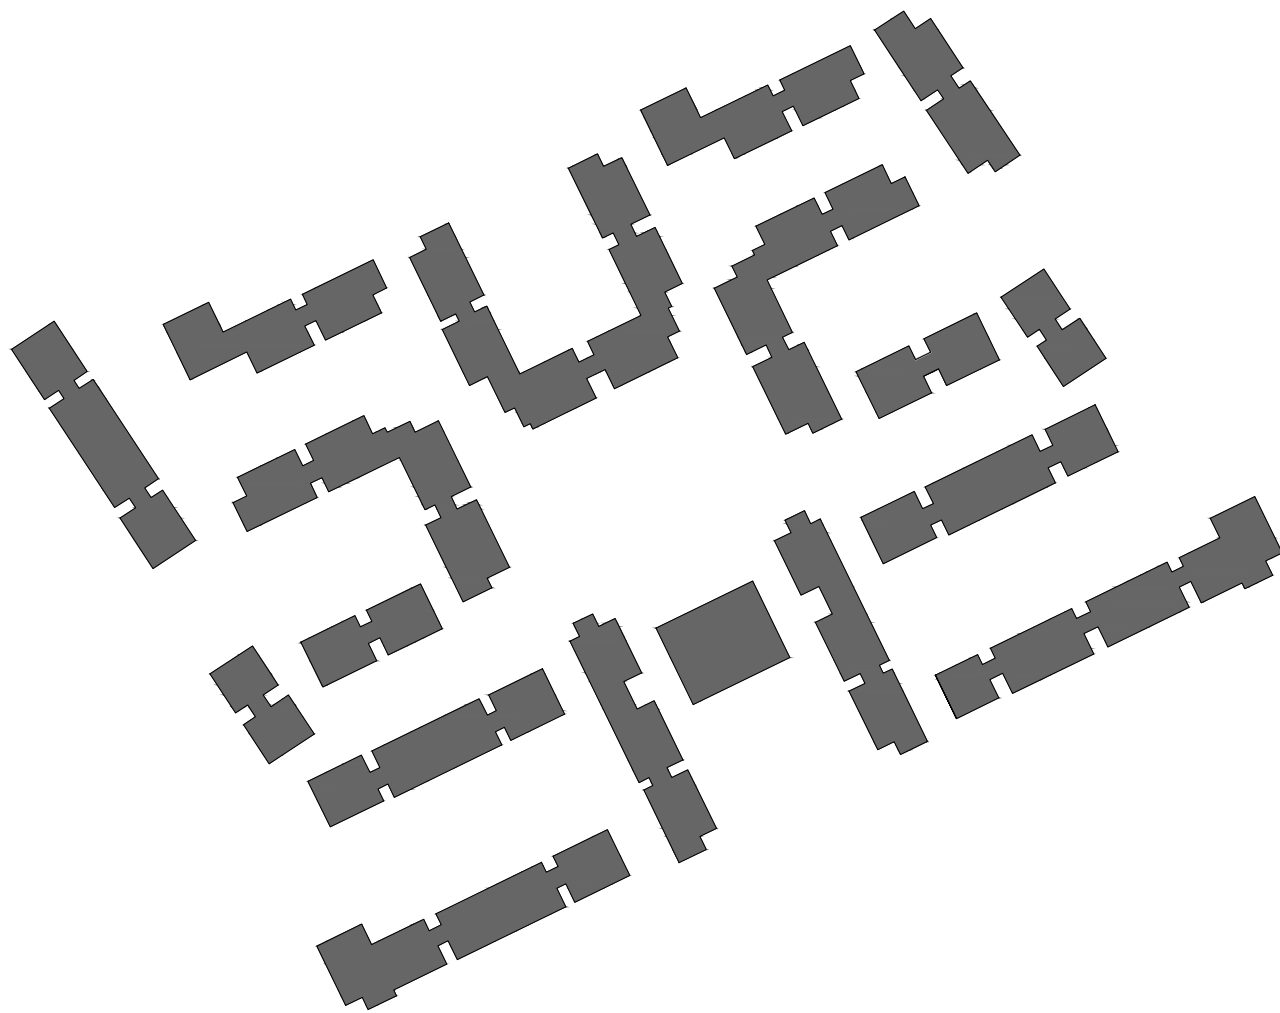

AERIAL VIEW:

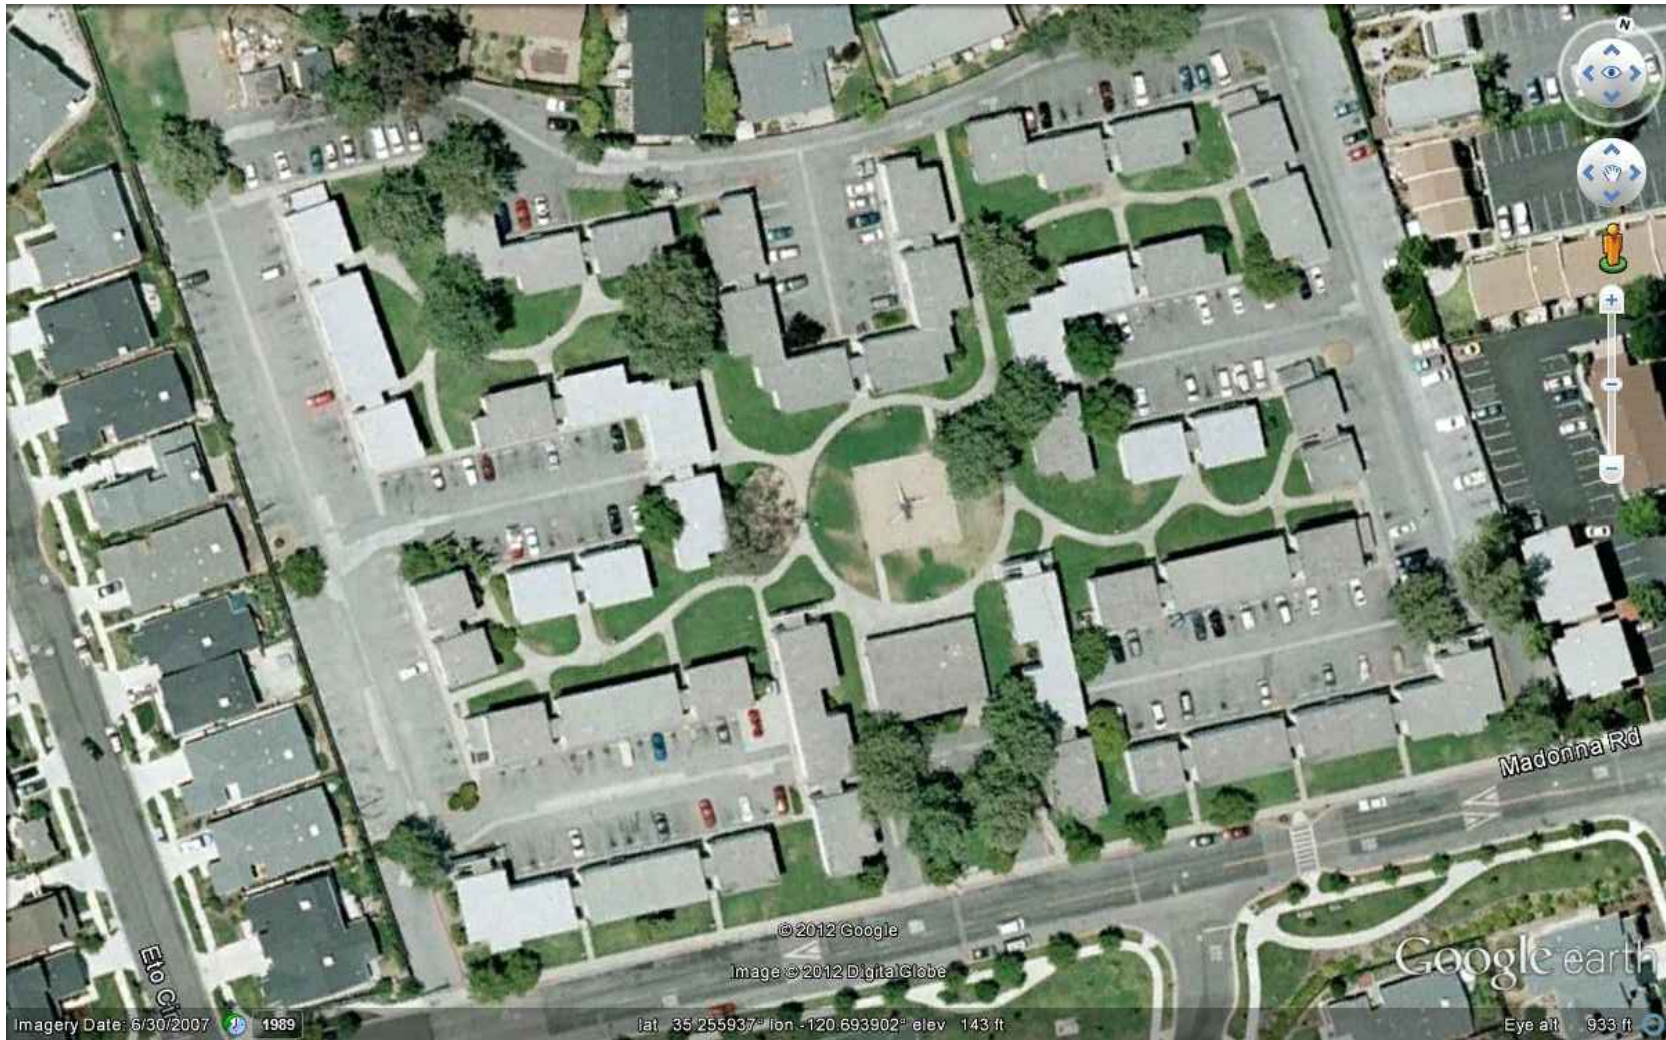

VICINITY MAP:

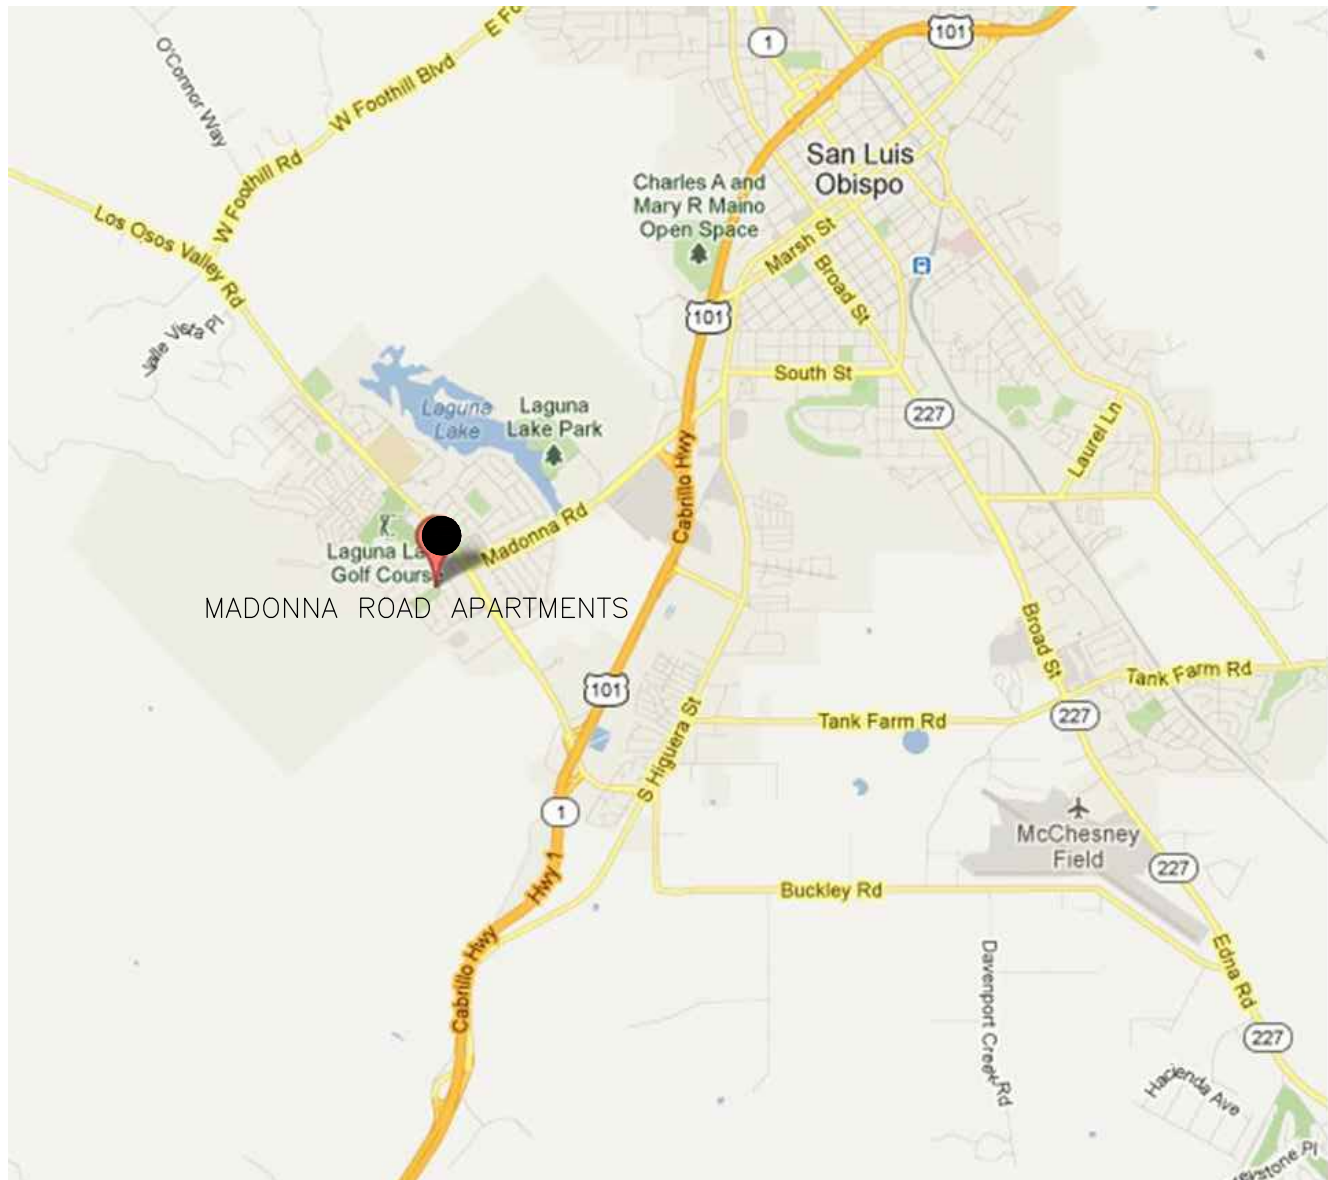

SHEET INDEX:

| SHEET NO. | INDEX NO. | DESCRIPTION                                |
|-----------|-----------|--|
| 1         | T-1.1     | TITLE SHEET                                |
| 2         | O-2.1     | GENERAL ABBREVIATIONS, NOTES & SYMBOLS     |
| 3         | G-2.2     | SITE STAGING AND ACCESS PLAN               |
| 4         | E-3.1     | OVERALL PV SITE PLAN                       |
| 5         | E-3.2     | PV ROOFTOP LAYOUT - BUILDINGS 1, 3, 7      |
| 6         | E-3.3     | PV ROOFTOP LAYOUT - BUILDINGS 4, 5, 14, 15 |
| 7         | E-3.4     | PV ROOFTOP LAYOUT - BUILDINGS 6, 12        |
| 8         | E-3.5     | PV ROOFTOP LAYOUT - BUILDINGS 9, 11, 13    |
| 9         | E-3.6     | PV ROOFTOP LAYOUT - BUILDING 10            |
| 10        | E-3.7     | PV ROOFTOP LAYOUT - BUILDING 19            |
| 11        | E-3.8     | PV ROOFTOP LAYOUT - BUILDINGS 16, 17, 18   |
| 12        | E-3.9     | INVERTER LOCATION PLAN                     |
| 13        | E-4.1     | SINGLE LINE DIAGRAM - BUILDING 1           |
| 14        | E-4.2     | SINGLE LINE DIAGRAM - BUILDINGS 3, & 16    |
| 15        | E-4.3     | SINGLE LINE DIAGRAM - BUILDING 19          |
| 16        | E-4.4     | SINGLE LINE DIAGRAM - BUILDINGS 6, 7, & 12 |
| 17        | E-4.5     | SINGLE LINE DIAGRAM - BUILDINGS 10 & 17    |
| 18        | E-4.6     | SINGLE LINE DIAGRAM - BUILDINGS 2 & 18     |
| 19        | E-4.7     | SINGLE LINE DIAGRAM - BUILDING 5           |
| 20        | E-4.8     | SINGLE LINE DIAGRAM - BUILDINGS 9 & 11     |
| 21        | E-4.9     | SINGLE LINE DIAGRAM - BUILDING 14          |
| 22        | E-4.10    | SINGLE LINE DIAGRAM - BUILDING 13          |
| 23        | E-4.11    | SINGLE LINE DIAGRAM - BUILDINGS 4 & 15     |
| 24        | E-4.12    | DC WIRING DETAILS                          |
| 25        | D-5.1     | PV DATA SHEETS                             |
| 26        | D-5.2     | PV DATA SHEETS                             |
| 27        | P-6.1     | PV IDENTIFICATION PLACARDS                 |
| 28        | P-6.2     | PV IDENTIFICATION PLACARDS                 |
| 29        | P-6.3     | PV IDENTIFICATION PLACARDS                 |
| 30        | P-6.4     | PV IDENTIFICATION PLACARDS                 |

SCOPE OF WORK:

THE FOLLOWING PROJECT CALLS FOR THE INSTALLATION OF (18) ROOFTOP SOLAR PHOTOVOLTAIC POWER SYSTEMS (SPVPS) ON (1) RESIDENTIAL PROPERTY LOCATED AT 1550 MADONNA ROAD, SAN LUIS OBISPO, CALIFORNIA.

THE SPVPS WILL CONSIST OF THE INSTALLATION OF (855) PHOTOVOLTAIC MODULES AND (29) INVERTERS. THE MOUNTING METHOD WILL UTILIZE AN PANEL CLAW PRE-ENGINEERED ROOF MOUNTING SYSTEM THAT WILL BE STRUCTURALLY AND MECHANICALLY FASTENED WITH A 10-DEGREE SLOP TO THE FLAT ROOF. THE SPVPS' WILL BE INSTALLED ON THE EXISTING BUILDING FOOTPRINT AND WILL NOT ENCROACH ON ANY EXISTING SITE BOUNDARIES. PANEL CLAW'S ATTACHMENT SYSTEMS IS DESIGNED TO WITHSTAND WIND AND SEISMIC LOADS ON THE EXISTING ROOF.

PV SYSTEM COMPONENTS:

- (855) 250-WATT PV MODULES
- (1) 11.4-kW INVERTERS W/ INTEGRATED DC DISCONNECT
- (5) 10-kW INVERTERS W/ INTEGRATED DC DISCONNECT
- (8) 7.5-kW INVERTERS W/ INTEGRATED DC DISCONNECT
- (11) 6-kW INVERTER W/ INTEGRATED DC DISCONNECT
- (4) 3-kW INVERTER W/ INTEGRATED DC DISCONNECT
- (19) DATA ACQUISITION SYSTEMS

ARRAY INFORMATION:

- ARRAY TILT: 10°
- ARRAY AZIMUTH: 154°, 237°, 244°
- PV PANEL AREA: 14,535 FT<sup>2</sup>
- STC WATTS: 213,750kW
- PTC WATTS: 194,512kW
- CEC-AC WATTS: 185,759kW
- METER #: (19) MULTIPLE
- UTILITY ACCOUNT #: 2199678306-0

PROJECT CONTACTS:

SYSTEM OWNER:

MADONNA ROAD PARTNERS, LP  
1550 MADONNA ROAD  
SAN LUIS OBISPO, CA 93401

(760) 557-1478

ELECTRICAL CONTRACTOR:

EVERYDAY ENERGY  
5865 AVENIDA ENCINAS, SUITE 142A  
CARLSBAD, CA 92008  
PHONE: (760) 607-7200  
LICENSE # C-10 949535

PROJECT ENGINEERING:

SUSTINEO CORPORATION  
6977 NAVAJO ROAD, SUITE 139  
SAN DIEGO, CA 92119  
ENGINEERING MANAGER: DAVE HANDMAN  
ENGINEER: ROBERTO RIVERA, P.E. (ELECTRICAL)  
PHONE: (858) 270-9333  
ENGINEER: DON ORIE, P.E., S.E. (STRUCTURAL)  
PHONE: (858) 335-7643

PROJECT MANAGEMENT:

EVERYDAY ENERGY  
5865 AVENIDA ENCINAS, SUITE 142A  
CARLSBAD, CA 92008  
PROJECT MANAGER: SKY SEALS  
PHONE: (619) 205-2801

SITE PLAN:



SITE INFORMATION:

APPROX. GROUND AREA: 268,036 FT<sup>2</sup>  
APPROX. ROOF AREA: 64,317 FT<sup>2</sup>  
LATITUDE: 35.255°  
LONGITUDE: -120.693°  
STANDARD MERIDIAN: 120.0  
APN: 153-102-025  
ZONING DESIGNATION: RESIDENTIAL

WEATHER INFORMATION:

RECORD LOW AMBIENT TEMPERATURE: 12° (DECEMBER)  
AVERAGE LOW AMBIENT TEMPERATURE: 43° (DECEMBER)  
EXPECTED DAYTIME LOW TEMPERATURE: 24° (DECEMBER)\*  
RECORD HIGH AMBIENT TEMPERATURE: 112° (SEPTEMBER)  
AVERAGE HIGH AMBIENT TEMPERATURE: 77° (SEPTEMBER)  
SOLAR RESOURCE: 5.742 kWh/m<sup>2</sup>/DAY  
\* USED FOR MAXIMUM SYSTEM VOLTAGE CALCULATION

CODE COMPLIANCE:

ANALYSIS ITEMS

FIRE:  
BUILDING:  
STRUCTURAL:  
PLUMBING:  
ELECTRICAL:

STORIES: 2

CODE REFERENCE:

CALIFORNIA DEPARTMENT OF FORESTRY AND FIRE PROTECTION 2008  
CALIFORNIA BUILDING CODE 2010  
CALIFORNIA BUILDING CODE 2010  
N/A  
CALIFORNIA ELECTRIC CODE 2010

ENGINEER APPROVAL:



ROBERTO RIVERA, P.E. NO. 16743 DATE: 09/10/12

| DESCRIPTION: | 100% CONSTRUCTION DRAWINGS |
|--------------|----------------------------|
| DATE:        | 9/10/12                    |
| REV.         | 1                          |

PREPARED BY:



6977 NAVAJO RD., SUITE 139  
SAN DIEGO, CA 92119  
PHONE: 858.270.9333  
FAX: 858.270.9334

THIS DOCUMENT IS CONSIDERED PROTECTED  
INTELLECTUAL PROPERTY. ANY CONTAINS PROPRIETARY  
INFORMATION UNDER UNITED STATES LAW. NO PORTION OR  
PART OF THIS DOCUMENT MAY BE REPRODUCED FOR ANY  
PURPOSE WITHOUT THE EXPLICIT WRITTEN PERMISSION OF  
SUSTINEO CORP.

OWNER/CLIENT:

MADONNA ROAD APARTMENTS  
1550 MADONNA ROAD  
SAN LUIS OBISPO, CA 93405



EVERYDAY ENERGY  
5865 AVENIDA ENCINAS,  
SUITE 142A  
CARLSBAD, CA, 92008  
P: (760) 607-7200

TITLE SHEET  
PHOTOVOLTAIC SYSTEM  
PROJECT LOCATION:  
1550 MADONNA ROAD  
SAN LUIS OBISPO, CA 93405

| PROJECT NO.: | 038 - 108          |
|--------------|--------------------|
| APN:         | 140-040-003        |
| DATE:        | SEPTEMBER 10, 2012 |
| SHEET NO.:   | T 1.1              |



GENERAL SAFTEY NOTES:

- S1SAFETY IS OUR NUMBER ONE PRIORITY. PLEASE FOLLOW ALL APPLICABLE SAFETY RULES AND REGULATIONS.
- S2TAKE EXTRA CARE WHEN PLACING PV MODULE CRATES ON THE ROOF. PLACE PLYWOOD ON THE SURFACE TO PROTECT THE MEMBRANE.
- S3WHEN LIFTING PV MODULE CRATES ONTO THE ROOF, BE SURE THAT THE ROOF IS CAPABLE OF SUPPORTING THE ADDITIONAL DEAD WEIGHT LOAD OF THESE CRATES AND THAT THE LOAD IS DISTRIBUTED EVENLY.
- S4BE SURE THAT THE CRANE OPERATOR IS IN CONTINUOUS COMMUNICATIONS WITH THE REPRESENTATIVES ON THE ROOF. WHEN PLACING CRATES, DURING THIS OPERATIONS ALL WORKERS MUST BE WEARING OSHA APPROVED HEAD PROTECTION AND STEEL TOED SHOES.
- S5WHEN LANDING CRATES ON THE ROOF, MAKE SURE THAT THE CRATE IS FACING THE RIGHT DIRECTION FOR PANEL REMOVAL.
- S6EACH PV MODULE WEIGHS 43.0 LBS. AS A REMINDER, USE YOUR LEGS WHEN LIFTING.
- S7REMEMBER THAT DURING DAYLIGHT HOURS THE MODULES WILL BE PRODUCING VOLTAGE. IF THE MODULE IS DAMAGED THERE IS A CHANCE THAT YOU COULD BE EXPOSED TO THE FULL VOLTAGE AND CURRENT BEING GENERATED. IF A MODULE IS SHIPPED DAMAGED OR BECOMES DAMAGED AT THE JOBSITE, CAREFULLY HANDLE THE MODULE AND PLACE IT OUT OF THE SUNLIGHT.
- S8EVEN IF THE MODULE IS NOT DAMAGED, KEEP IN MIND THAT WHENEVER THE MODULE OR SYSTEM IS EXPOSED TO SUNLIGHT IT CAN GENERATE UP TO 600VDC AND AS HIGH AS 240VAC. WHEN WORKING WITH THIS EQUIPMENT, MAKE SURE THAT YOU TAKE EVERY PRECAUTION TO AVOID CONTACT WITH ANY ELECTRICAL TERMINAL OR WIRE UNLESS SYSTEM VOLTAGE IS TESTED, LOOKED OUT, AND DEEMED SAFE FOR WORK.
- S9IF YOU HAVE ANY QUESTIONS PERTAINING TO THE INSTALLATION, OPERATION, OR FUNCTION OF ANY COMPONENTS THAT MAKE UP THIS PV SYSTEM, CONTACT THE CONTRACTOR OR PROJECT MANAGER AND THEY WILL ASSIST YOU.
- S10VERIFY SETBACK DISTANCE IS SAFE FOR ROOF WORKERS
- S11WHEN INVERTERS ARE LOCATED IN PUBLIC AREAS AND PERSONNEL CAN COME IN CONTACT WITH EQUIPMENT, PROVIDE A GATE OR SECURED ENCLOSURE TO PREVENT UNAUTHORIZED ACCESS.
- S12WHEN WORKING ON THE ROOF, PERSONNEL SHALL TAKE CARE IN WORKING NEAR SKYLIGHTS. PROPER OSHA WARNING SIGNAGE AND ABATEMENT STRATEGIES SHALL BE UTILIZED AT ALL TIMES.

GENERAL NOTES:

- 1CONTRACTOR SHALL ASSUME FULL RESPONSIBILITY AND LIABILITY FOR COMPLIANCE WITH REGULATIONS PER FEDERAL OSHA, CAL/OSHA, AND LOCAL REGULATIONS PERTAINING TO WORK PRACTICES, PROTECTION, OR WORKERS AND VISITORS TO THE SITE.
- 2CONTRACTOR SHALL VERIFY ALL EXISTING CONDITIONS AND DIMENSIONS AT SITE BEFORE COMMENCING WORK.
- 3CONTRACTOR SHALL VERIFY (E) CONDITIONS AND NOTIFY PRIMARY CONTRACTOR OF DISCREPANCIES REQUIRING FURTHER CLARIFICATION BEFORE PROCEEDING WITH WORK.
- 4WORK REQUIRED UNDER THIS CONTRACT INCLUDES ALL LABOR AND MATERIALS, EQUIPMENT, ETC. NECESSARY AND REASONABLY INCIDENTAL TO COMPLETE THIS PROJECT. ALL MATERIALS SHALL BE IN NEW AND UNUSED CONDITION AND OF HIGH QUALITY IN EVERY ASPECT.
- 5MANUFACTURER'S MATERIAL, EQUIPMENT, ETC. SHALL BE INSTALLED PER MANUFACTURER'S RECOMMENDATIONS AND INSTRUCTIONS.
- 6THE CONTRACTOR SHALL BECOME FAMILIAR WITH ALL UTILITY AS-BUILT PLANS AND THE LOCATIONS OF ALL EXISTING UTILITIES AND STRUCTURES. THE CONTRACTOR SHALL BE RESPONSIBLE FOR ANY DAMAGE TO EXISTING UTILITIES, STRUCTURES, PAVEMENT, OR IMPROVEMENTS.
- 7ALL WORK SHALL BE INSTALLED IN CONFORMANCE WITH ALL APPLICABLE LOCAL CODES AND ORDINANCES BY EXPERIENCED WORKERS AND A LICENSED CONTRACTOR WHO SHALL OBTAIN ALL NECESSARY PERMITS AND PAY ALL LOCAL FEES.
- 8INSTALL ALL ASPECTS OF THIS CONTRACT IN ACCORDANCE WITH THE CALIFORNIA SOLAR INITIATIVE (CSI).
- 9INSTALL ALL ASPECTS OF THIS CONTRACT IN ACCORDANCE WITH OWNERS' PREREQUISITES.
- 10MAINTAIN QUALITY CONTROL AND INSPECT ALL WORK UNDER THE CONTRACT.
- 11FALL HAZARD PROTECTION AND PREVENTION PROGRAM SHALL BE IN PLACE AT ALL TIMES WHEN PERFORMING WORK ABOVE 6 FEET.
- 12COMPLY WITH ALL SAFETY REQUIREMENTS. ALL WORK SHALL BE PERFORMED IN A SAFE MANNER IN ACCORDANCE WITH ALL APPLICABLE SAFETY AND HEALTH REGULATIONS.
- 13WORK HOURS SHALL BE NORMALLY FROM 0700 THROUGH 1700 MONDAY THROUGH FRIDAY.

| MADONNA ROAD HOURLY GENERATION PROFILE (kWh) |        |        |        |        |        |        |        |        |        |        |        |        |         |         |        |        |
|--|--------|--------|--------|--------|--------|--------|--------|--------|--------|--------|--------|--------|---------|---------|--------|--------|
| HOURL  | JAN    | FEB    | MAR    | APR    | MAY    | JUN    | JUL    | AUG    | SEP    | OCT    | NOV    | DEC    | YEAR    | SUMMER  | SPRING | REST   |
| 1:00   |        |        |        |        |        |        |        |        |        |        |        |        |         |         |        |        |
| 2:00   |        |        |        |        |        |        |        |        |        |        |        |        |         |         |        |        |
| 3:00   |        |        |        |        |        |        |        |        |        |        |        |        |         |         |        |        |
| 4:00   |        |        |        |        |        |        |        |        |        |        |        |        |         |         |        |        |
| 5:00   |        |        |        |        |        |        |        |        |        |        |        |        |         |         |        |        |
| 6:00   |        |        |        |        |        |        |        |        |        |        |        |        |         |         |        |        |
| 7:00   |        |        |        |        | 49     | 72     | 43     |        |        |        |        |        | 164     | 116     | 49     |        |
| 8:00   | 7      | 154    | 158    | 245    | 538    | 598    | 472    | 264    | 105    | 19     | 169    | 15     | 2,746   | 1,440   | 941    | 364    |
| 9:00   | 714    | 826    | 742    | 1,199  | 1,521  | 1,516  | 1,264  | 1,095  | 925    | 562    | 965    | 789    | 12,120  | 4,800   | 3,463  | 3,857  |
| 10:00  | 1,507  | 1,622  | 1,587  | 2,276  | 2,639  | 2,576  | 2,414  | 2,247  | 2,069  | 1,440  | 1,877  | 1,693  | 23,947  | 9,306   | 6,502  | 8,139  |
| 11:00  | 2,244  | 2,202  | 2,193  | 3,396  | 3,692  | 3,407  | 3,583  | 3,350  | 3,013  | 2,334  | 2,451  | 2,362  | 34,228  | 13,354  | 9,282  | 11,593 |
| 12:00  | 2,611  | 2,448  | 2,601  | 4,447  | 4,402  | 4,318  | 4,371  | 4,269  | 3,817  | 2,917  | 2,862  | 2,879  | 41,943  | 16,775  | 11,451 | 13,717 |
| 13:00  | 2,867  | 2,422  | 3,047  | 4,834  | 5,045  | 4,881  | 4,946  | 4,746  | 4,172  | 3,314  | 2,826  | 3,096  | 46,197  | 18,745  | 12,926 | 14,525 |
| 14:00  | 2,692  | 2,382  | 3,170  | 5,095  | 5,160  | 5,064  | 5,207  | 4,925  | 4,443  | 3,687  | 2,789  | 2,891  | 47,506  | 19,639  | 13,425 | 14,441 |
| 15:00  | 2,439  | 2,135  | 2,799  | 4,861  | 4,793  | 5,019  | 5,159  | 4,771  | 4,298  | 3,408  | 2,330  | 2,378  | 44,389  | 19,247  | 12,453 | 12,690 |
| 16:00  | 1,896  | 1,475  | 2,481  | 4,321  | 4,332  | 4,547  | 4,680  | 4,315  | 3,670  | 2,756  | 1,681  | 1,681  | 37,835  | 17,212  | 11,134 | 9,489  |
| 17:00  | 364    | 788    | 1,686  | 3,429  | 3,635  | 3,882  | 4,030  | 3,640  | 2,947  | 2,091  | 487    | 250    | 27,230  | 14,499  | 8,750  | 3,981  |
| 18:00  |        | 100    | 987    | 2,461  | 2,533  | 2,849  | 2,930  | 2,590  | 1,879  | 843    |        |        | 17,172  | 10,248  | 5,981  | 943    |
| 19:00  |        |        | 333    | 1,233  | 1,417  | 1,681  | 1,652  | 1,432  | 312    | 10     |        |        | 8,072   | 5,078   | 2,984  | 10     |
| 20:00  |        |        |        | 11     | 63     | 222    | 127    | 68     |        |        |        |        | 493     | 418     | 75     |        |
| 21:00  |        |        |        |        |        |        |        |        |        |        |        |        |         |         |        |        |
| 22:00  |        |        |        |        |        |        |        |        |        |        |        |        |         |         |        |        |
| 23:00  |        |        |        |        |        |        |        |        |        |        |        |        |         |         |        |        |
| 0:00   |        |        |        |        |        |        |        |        |        |        |        |        |         |         |        |        |
| TOTALS                                       | 17,341 | 16,554 | 21,784 | 37,808 | 39,819 | 40,632 | 40,878 | 37,712 | 31,650 | 23,381 | 18,437 | 18,034 | 344,042 | 150,877 | 99,416 | 93,749 |

DESIGN BASIS (10 PANEL STRINGS):

MAXIMUM PV SYSTEM VOLTAGE:

V<sub>max</sub> = STRING SIZE X (V<sub>oc</sub> + (T<sub>coeff</sub> X (25-T<sub>exp</sub>)))  
V<sub>max</sub> = 10 X (37.4V + (0.11968 X (25--4.4)))  
V<sub>max</sub> = 10 X (37.4V + 3.524V)  
V<sub>max</sub> = 10 X 40.92V  
V<sub>max</sub> = 409.2V

DESIGN BASIS (11 PANEL STRINGS):

MAXIMUM PV SYSTEM VOLTAGE:

V<sub>max</sub> = STRING SIZE X (V<sub>oc</sub> + (T<sub>coeff</sub> X (25-T<sub>exp</sub>)))  
V<sub>max</sub> = 11 X (37.4V + (0.11968 X (25--4.4)))  
V<sub>max</sub> = 11 X (37.4V + 3.524V)  
V<sub>max</sub> = 11 X 40.92V  
V<sub>max</sub> = 450.2V

DESIGN BASIS (12 PANEL STRINGS):

MAXIMUM PV SYSTEM VOLTAGE:

V<sub>max</sub> = STRING SIZE X (V<sub>oc</sub> + (T<sub>coeff</sub> X (25-T<sub>exp</sub>)))  
V<sub>max</sub> = 12 X (37.4V + (0.11968 X (25--4.4)))  
V<sub>max</sub> = 12 X (37.4V + 3.524V)  
V<sub>max</sub> = 12 X 40.92V  
V<sub>max</sub> = 491.1V

DESIGN BASIS (13 PANEL STRINGS):

MAXIMUM PV SYSTEM VOLTAGE:

V<sub>max</sub> = STRING SIZE X (V<sub>oc</sub> + (T<sub>coeff</sub> X (25-T<sub>exp</sub>)))  
V<sub>max</sub> = 13 X (37.4V + (0.11968 X (25--4.4)))  
V<sub>max</sub> = 13 X (37.4V + 3.524V)  
V<sub>max</sub> = 13 X 40.92V  
V<sub>max</sub> = 532.0V

DESIGN BASIS (14 PANEL STRINGS):

MAXIMUM PV SYSTEM VOLTAGE:


V<sub>max</sub> = STRING SIZE X (V<sub>oc</sub> + (T<sub>coeff</sub> X (25-T<sub>exp</sub>)))  
V<sub>max</sub> = 14 X (37.4V + (0.11968 X (25--4.4)))  
V<sub>max</sub> = 14 X (37.4V + 3.524V)  
V<sub>max</sub> = 14 X 40.92V  
V<sub>max</sub> = 572.9V

ELECTRICAL NOTES:

- E1REFER TO THE ONE-LINE AND DC WIRING DETAILS SCHEMATIC FOR CONDUCTOR SIZE BETWEEN MAJOR POWER COMPONENTS OF THE ELECTRICAL SYSTEM.
- E2NEW CONDUIT ROUTING SHOWN IS ESSENTIALLY DIAGRAMMATIC. SUBCONTRACTOR SHALL LAY OUT RUNS TO SUIT FIELD CONDITIONS AND THE COORDINATION REQUIREMENTS OF OTHER TRADES.
- E3ALL CONDUIT CROSSING EXPANDING AND SEISMIC SEPARATION JOINTS SHALL BE PROVIDED WITH EXPANSION/DEFLECTION FITTINGS. PROVIDE FITTINGS AND SEAL TIGHT FLEXIBLE METAL CONDUIT RACEWAYS AS REQUIRED TO ACCOMMODATE BUILDING MOVEMENT.
- E4ALL SEAL TIGHT FLEXIBLE METAL CONDUIT (OR EQUIV.) TO BE BONDED TO GROUND AT COUPLINGS ON BOTH ENDS.
- E5ALL CONDUIT BEND RADII TO CONFORM TO NEC MINIMUM BEND RADII STANDARDS.
- E6ALL CONDUIT RUNS SHALL BE SECURELY FASTENED AT INTERVALS OF 10 FT. MIN. AND 3 FT. MIN FROM EQUIPMENT OR STRUCTURE PENETRATIONS PER NEC ARTICLE 358.30.
- E7MINIMUM CLEARANCE BETWEEN ALL NEW EQUIPMENT TO BE INSTALLED AND ANY NEW EXISTING ADJACENT EQUIPMENT SHALL BE 48" FACE TO FACE ON ALL EQUIPMENT PANELS INTENDED FOR MAINTENANCE ACCESS.
- E8CONDUIT ENTRY/CONNECTION TO ELECTRICAL ENCLOSURES SHALL BE SUITABLE FOR GROUNDING AND SHALL BE SEALED AGAINST ENVIRONMENT.
- E9ALL EMT OR RIGID COUPLINGS TO BE LISTED AS "RAIN TIGHT".
- E10ALL CONDUCTORS SHALL BE COPPER WITH 90°C INSULATION.
- E11VERIFY ON-SITE UTILITIES AND HAVE THEM MARKED OUT BY UTILITY LOCATOR SERVICE PRIOR TO THE START OF CONSTRUCTION.
- E12FOLLOW ELECTRICAL SAFETY CRITERIA SPECIFIED IN NFPA 70E AND NEC DURING THE CONDUCT OF OF ALL WORK.
- E13THE SPVPS WILL SUPPLY RATED AC POWER OUTPUT AS SPECIFIED BY THE MANUFACTURER AND THE CSI PROGRAM.
- E14ALL CONDUIT RUNS EXPOSED IN ELECTRICAL ROOMS, MECHANICAL ROOMS, SHELTERS, PARKING LOT AREAS, AND OUTDOOR INSTALLATION SHALL BE ELECTRICAL METAL TUBING.
- E15ALL FLEX AND SEAL TYPE CONDUIT SHALL HAVE A GROUND CONDUCTOR.
- E16PROVIDE GROUND WIRE IN ALL CIRCUITS AND AS REQUIRED EVEN THOUGH NOT SHOWN ON DRAWINGS. FIELD VERIFY EXACT LOCATIONS.

CONTRACTOR SHALL MAINTAIN AS-BUILT SETS OF DRAWINGS REFLECTING ALL CHANGES MADE DURING CONSTRUCTION. THIS SET OF DRAWINGS SHALL BE KEPT ON THE JOB SITE AND SHALL BE USED AS A RECORD SET ONLY. ALL CHANGES AS NOTED ON THE RECORD SET SHALL BE INCORPORATED INTO A REPRODUCIBLE CONTRACT DRAWING. ALL CHANGES SHALL BE INDICATED IN RED INK IN A NEAT, LEGIBLE, PROFESSIONAL AND UNDERSTANDABLE MANNER.

VOLTAGE LOSS DIAGRAM

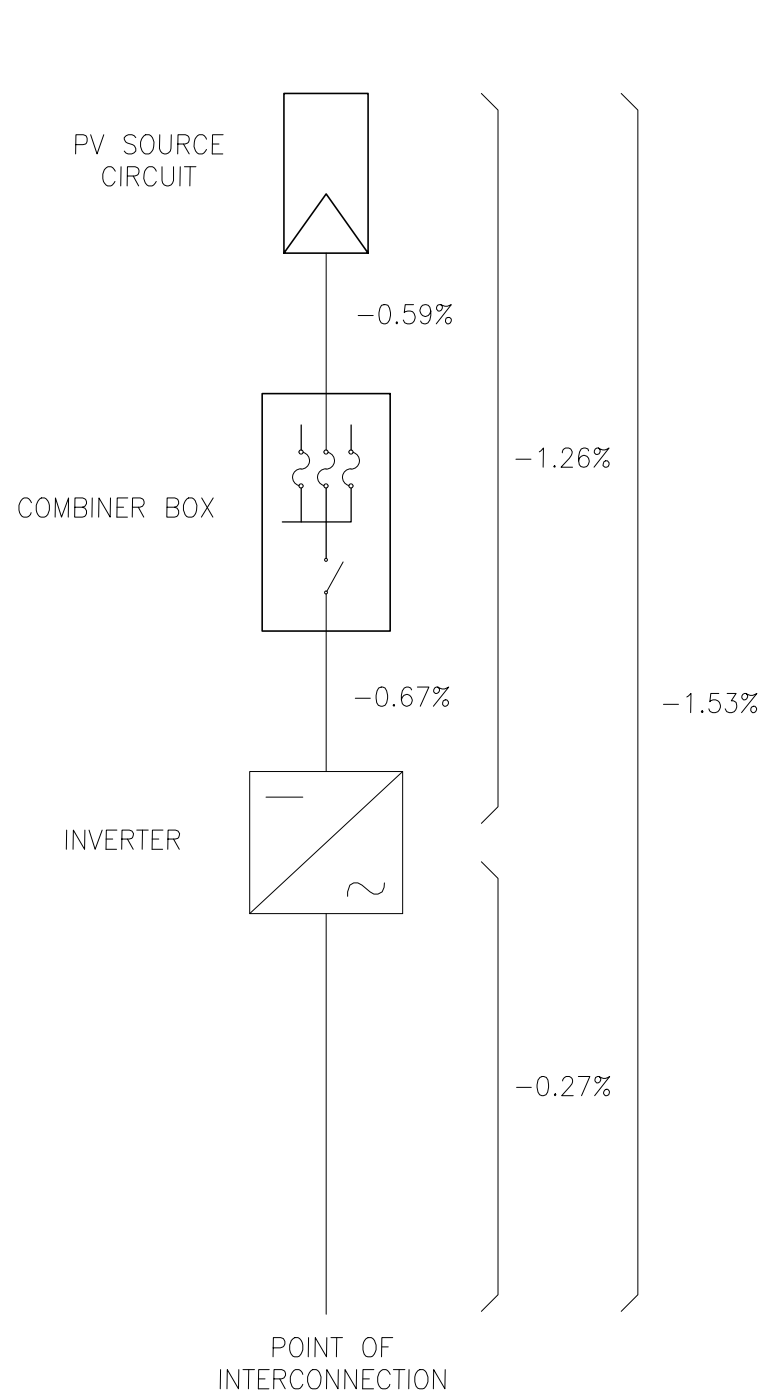

ABBREVIATIONS

|       |                                      |        |                                 |
|-------|--------------------------------------|--------|---------------------------------|
| A     | AMPERE                               | MCC    | MOTOR CONTROL CENTER            |
| AC    | ALTERNATING CURRENT                  | MLO    | MAIN LUGS ONLY                  |
| AF    | AMP (FRAMED)                         | MCM    | THOUSAND CIRCULAR MIL(S)        |
| AIR   | AIR HANDLING UNIT                    | MSDS   | MATERIAL SAFETY DATA SHEET      |
| AL    | ALUMINUM                             | N      | NEUTRAL                         |
| ARRA  | AMERICAN RECOVERY & REINVESTMENT ACT | (N)    | NEW                             |
| AWG   | AMERICAN WIRE GAUGE                  | NAWS   | NAVAL AIR WEAPONS STATION       |
| BKBD  | BACKBOARD                            | NC     | NORMALLY CLOSED                 |
| CB    | CIRCUIT BREAKER                      | NEC    | NATIONAL ELECTRIC CODE          |
| CKT   | CIRCUIT                              | NF     | NON FUSED                       |
| COND  | CONDUCTOR                            | NO     | NORMALLY OPEN                   |
| COR   | CONTRACTING OFFICER REPRESENTATIVE   | OCF    | OVER CURRENT PROTECTION         |
| COM   | CONTRACTOR QUALITY MANAGEMENT        | PB     | PANEL BOARD                     |
| CSI   | CALIFORNIA SOLAR INITIATIVE          | PH     | PHASE                           |
| CT    | CURRENT TRANSFORMER                  | P.O.C. | POINT OF CONNECTION             |
| CU    | COPPER                               | P.O.D. | POINT OF DISCONNECTION          |
| DAS   | DATA ACQUISITION SYSTEM              | PRI    | PRIMARY                         |
| DC    | DIRECT CURRENT                       | PV     | PHOTOVOLTAIC                    |
| DOR   | DESIGNER OF RECORD                   | PVC    | POLYVINYL CHLORIDE              |
| DSC   | DISCONNECT SWITCH                    | QA     | QUALITY ASSURANCE               |
| DN    | DOWN                                 | QC     | QUALITY CONTROL                 |
| DP    | DOUBLE POLE                          | (R)    | EXISTING RELOCATED              |
| (E)   | EXISTING                             | RECPT  | RECEPTACLE                      |
| EC    | ELECTRICAL CONTRACTOR                | RGS    | RIGID GALVANIZED STEEL          |
| EM    | EMERGENCY                            | RMC    | RIGID METAL CONDUIT             |
| EMT   | ELECTRICAL METALLIC TUBING           | SL     | SKY LIGHT                       |
| ER    | EXISTING TO BE REMOVED               | SN     | SOLID NEUTRAL                   |
| G/GND | GROUND                               | SPVPS  | SOLAR PHOTOVOLTAIC POWER SYSTEM |
| FS    | FUSIBLE SWITCH                       | SW     | SWITCH                          |
| FU    | FUSE                                 | SWBD   | SWITCH BOARD                    |
| GFI   | GROUND FAULT INTERRUPTER             | T      | TELEPHONE                       |
| GS    | GROUND SHOT (ELEVATION)              | TB     | TERMINAL BLOCK                  |
| HZ    | FREQUENCY (CYCLES PER SECOND)        | TEFC   | TOTALLY ENCLOSED FAN COOLED     |
| JB    | JUNCTION BOX                         | TRANS  | TRANSFORMER                     |
| K     | KEY OPERATED                         | TYP    | TYPICAL                         |
| KO    | CONTRACTING OFFICER                  | V      | VOLT(S)                         |
| KVA   | KILOVOLT AMPHERE                     | VA     | VOLT AMPHERE(S)                 |
| KW    | KILOWATT(S)                          | VTA    | VENT TO ATMOSPHERE              |
| KWH   | KILOWATT HOUR                        | W      | WATT                            |
| mA    | MILLIAMPERE                          | WA     | WATT HOUR                       |
| MCB   | MAIN CIRCUIT BREAKER                 | WP     | WEATHERPROOF                    |

BILL OF MATERIALS - ELECTRICAL

| Item | Quantity | Description   | Manufacturer | Model #            |
|------|----------|---|--------------|--------------------|
| 1    | 855      | PV Module 250 Watts Trina   | Trina        | TSM-PA05           |
| 2    | 25       | Compact Combiner Box, 4 Ckt, 15 Amp Fused                                       | SolarBos     | CCS-04-15-4XP      |
| 3    | 2        | Junction Box, NEMA-3R   | TBD          | TBD                |
| 4    | 4        | Inverter, 240V, Grid Connected with DC Connecting Distributor                   | Fronius      | IG Plus V 3.0-240  |
| 5    | 11       | Inverter, 240V, Grid Connected with DC Connecting Distributor                   | Fronius      | IG Plus V 6.0-240  |
| 6    | 8        | Inverter, 240V, Grid Connected with DC Connecting Distributor                   | Fronius      | IG Plus V 7.5-240  |
| 7    | 5        | Inverter, 240V, Grid Connected with DC Connecting Distributor                   | Fronius      | IG Plus V 10.0-240 |
| 8    | 1        | Inverter, 240V, Grid Connected with DC Connecting Distributor                   | Fronius      | IG Plus V 11.4-240 |
| 9    | 9        | AC Sub-Panel, 100A, 240V, 1 Phase, 3 wire                                       | TBD          | TBD                |
| 10   | 2        | AC Sub-Panel, 150A, 240V, 1 Phase, 3 wire                                       | TBD          | TBD                |
| 11   | 18       | AC DISCONNECT SWITCH, FUSED, 100/200A, 240VAC, 2 POLE, VISIBLE BLADE DISCONNECT | TBD          | TBD                |
| 12   | 2        | AC DISCONNECT FUSE, 20 AMP  |              |                    |
| 13   | 2        | AC DISCONNECT FUSE, 35 AMP  |              |                    |
| 14   | 3        | AC DISCONNECT FUSE, 40 AMP  |              |                    |
| 15   | 2        | AC DISCONNECT FUSE, 50 AMP  |              |                    |
| 17   | 3        | AC DISCONNECT FUSE, 70 AMP  |              |                    |
| 18   | 2        | AC DISCONNECT FUSE, 80 AMP  |              |                    |
| 19   | 2        | AC DISCONNECT FUSE, 100 AMP   |              |                    |
| 20   | 2        | AC DISCONNECT FUSE, 110 AMP   |              |                    |

REBATE INFORMATION

SITE SPECIFICATIONS:

PROJECT NAME: MADONNA ROAD  
ZIP CODE: 93405  
UTILITY: PG&E  
CUSTOMER TYPE: RESIDENTIAL  
INCENTIVE TYPE: EPBB

ENGINEER APPROVAL:



Roberto Rivera  
09/10/12  
ROBERTO RIVERA, P.E. NO. 16743  
DATE:

DESCRIPTION: 100% CONSTRUCTION DRAWINGS  
DATE: 9/10/12  
REV: 1

PREPARED BY:



6977 NAVAJO RD., SUITE 139  
SAN DIEGO, CA 92119  
PHONE: 858.270.9333  
FAX: 858.270.9334

THIS DOCUMENT IS CONSIDERED PROTECTED INTELLECTUAL PROPERTY, AND CONTAINS PROPRIETARY INFORMATION. UNDER UNITED STATES LAW, NO PORTION OR PART OF THIS DOCUMENT MAY BE REPRODUCED FOR ANY PURPOSE WITHOUT THE EXPRESS WRITTEN PERMISSION OF SUSTINEO CORP.

OWNER/CLIENT:

MADONNA ROAD APARTMENTS  
1550 MADONNA ROAD  
SAN LUIS OBISPO, CA 93405



EVERYDAY ENERGY  
5865 AVENIDA ENCINAS,  
SUITE 142A  
CARLSBAD, CA 92008  
P: (760) 607-7200

GENERAL ABBREVIATIONS,  
NOTES & SYMBOLS  
PHOTOVOLTAIC SYSTEM

1550 MADONNA ROAD  
SAN LUIS OBISPO, CA 93405

TITLE:

PROJECT NO.:

038 - 108

APN:

140-040-003

DATE:


SEPTEMBER 10, 2012

SHEET NO.:

G2.1


2 OF 30

DIG ALERT

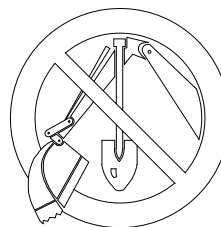

CALL BEFORE YOU DIG.  
(800) 227-2600



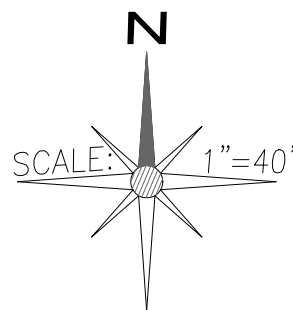

SCALE: 1"=40'



1. TAKE EXTRA CARE WHEN PLACING PV MODULE CRATES ON THE ROOF. PLACE PLYWOOD ON THE SURFACE TO PROTECT THE MEMBRANE.
2. WHEN LIFTING PV MODULE CRATES ONTO THE ROOF, BE SURE THAT THE ROOF IS CAPABLE OF SUPPORTING THE ADDITIONAL DEAD WEIGHT LOAD OF THESE CRATES AND THAT THE LOAD IS DISTRIBUTED EVENLY.
3. PLEASE SEE PANEL CLAW STRUCTURAL SHEETS AND STRUCTURAL CALCULATIONS FOR ADDITIONAL NOTES ON ROOF DEAD LOADS AND STAGING MATERIALS.
4. BE SURE THAT THE CRANE OPERATOR IS IN CONTINUOUS COMMUNICATIONS WITH THE REPRESENTATIVES ON THE ROOF WHEN PLACING CRATES. DURING THIS OPERATION, ALL WORKERS MUST BE WEARING OSHA APPROVED HEAD PROTECTION AND STEEL TOED SHOES.
5. WHEN LANDING CRATES ON THE ROOF, MAKE SURE THAT THE CRATE IS FACING THE CORRECT DIRECTION FOR PANEL REMOVAL.
6. WHEN ROOF SLOPES ARE GREATER THAN 20°, TAKE NECESSARY PRECAUTIONS WHEN STAGING ROOFTOP EQUIPMENT IN LANDING AREA LOCATIONS.
7. COORDINATE CRANE LIFT LOCATIONS WITH FACILITIES MANAGER AND VERIFY THAT THESE LOCATIONS ARE SAFE.

09/10/12

ROBERTO RIVERA, P.E. NO. 16743

|      |   |
|------|---|
| REV. | 1 |
|------|---|

EVERYDAY ENERGY  
5865 AVENIDA ENCINAS  
SUITE 142A  
CARLSBAD, CA, 92008  
P: (760) 607-7200

1550 MADONNA ROAD  
SAN LUIS OBISPO, CA 93405

038 - 108

140-040-003


SEPTEMBER 10, 2012

# G2.2

3 OF 30

# 100% CONSTRUCTION DRAWINGS



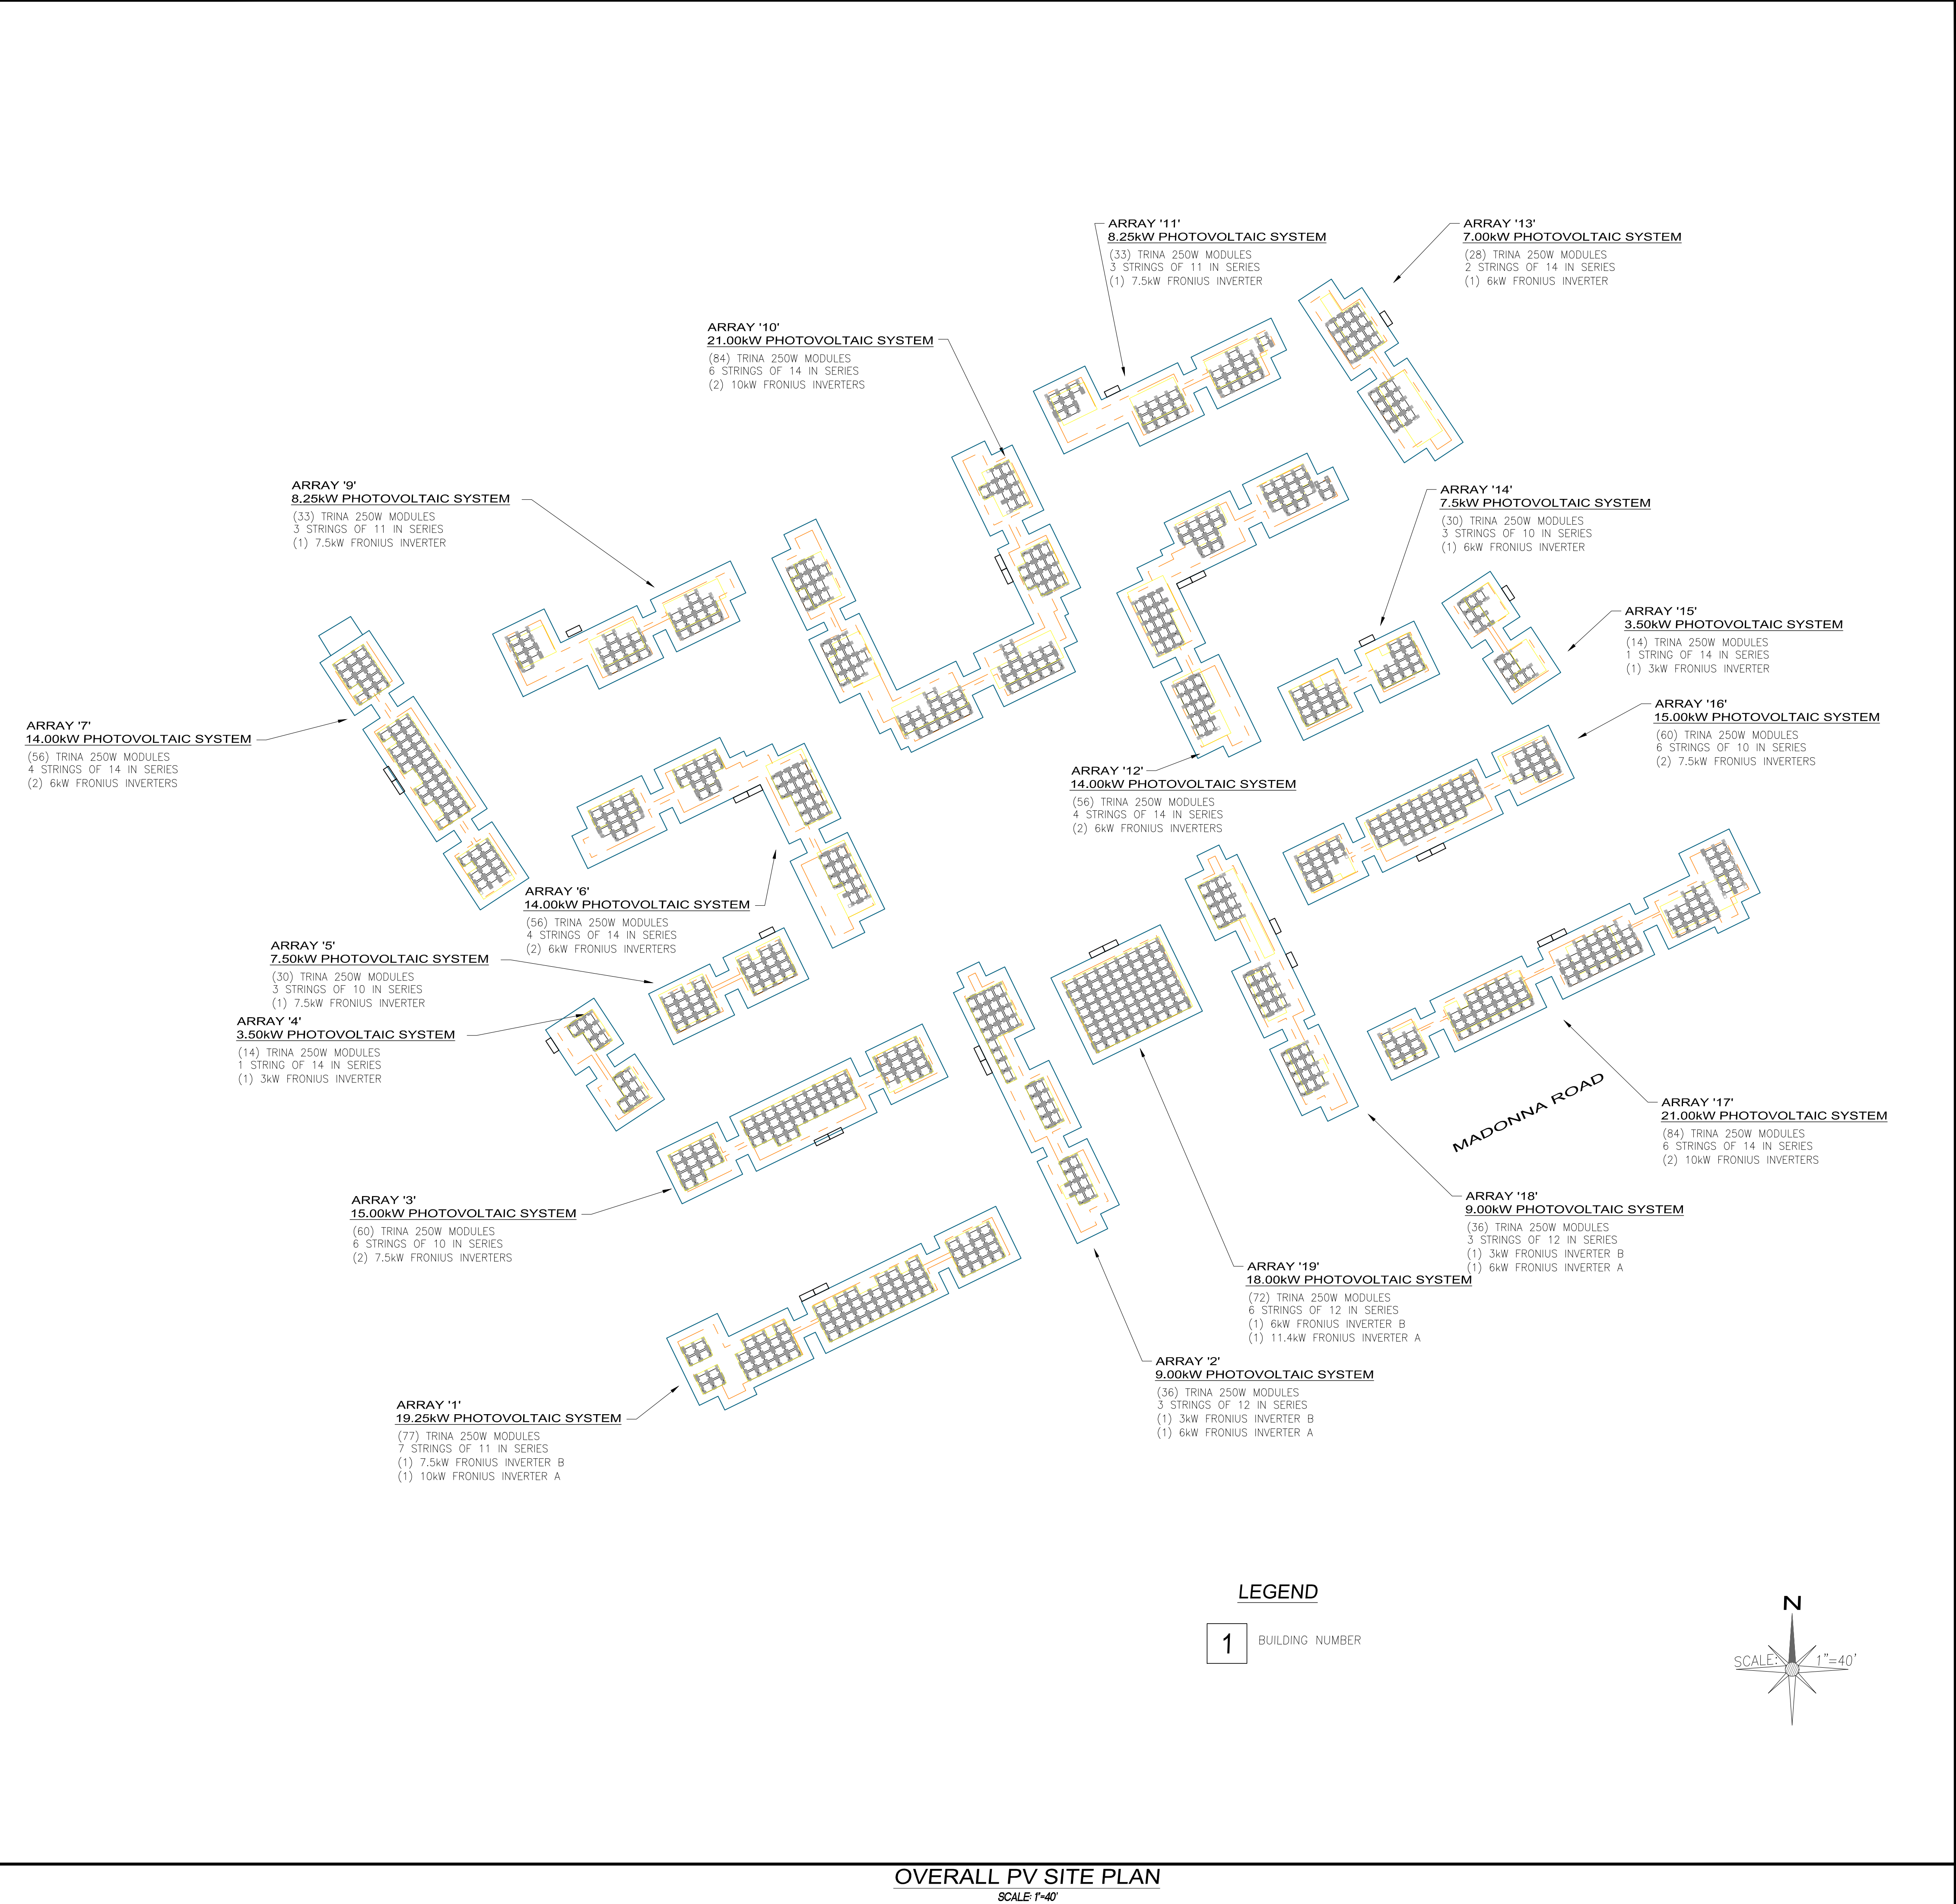

AERIAL VIEW  
NOT TO SCALE

ARRAY MOUNTING NOTES:

1. THE INSTALLATION CONTRACTOR SHALL ADHERE TO ALL REQUIREMENTS TO MAINTAIN THE ROOF WARRANTY AS SPECIFIED BY CURRENT ROOFING MATERIAL MANUFACTURER. ALL ROOFTOP PENETRATIONS SHALL BE OF AN APPROVED METHOD.
2. WHEN LOADING THE ROOF WITH CONSTRUCTION MATERIALS, THE INSTALLATION CONTRACTOR WILL BE RESPONSIBLE FOR PLACING AN APPROVED MEANS OF PROTECTION BELOW EACH PALLET OF MATERIALS TO PREVENT DAMAGE AND/OR INADVERTENT PENETRATIONS. ANY DAMAGE THAT OCCURS FROM IMPROPERLY PROTECTED MATERIALS WILL BE THE RESPONSIBILITY OF THE INSTALLATION CONTRACTOR TO REPAIR.
3. THE INSTALLATION CONTRACTOR WILL BE RESPONSIBLE FOR FOLLOWING ALL PROVIDED ROOFING LOADING DIAGRAMS. THE CONTRACTOR MUST VERIFY WITH CONSTRUCTION MANAGER FOR ALL LOCATIONS WHERE MATERIALS ARE TO BE STORED.
4. WHEN WORKING ON THE ROOF, CONTRACTOR WILL BE RESPONSIBLE FOR PROVIDING A MEANS OF FALL PROTECTION WHEN WORKING IN AREAS WITHIN 6' OF THE ROOFS EDGES OR A 3' CHANGE IN ELEVATION. THIS FALL PROTECTION EQUIPMENT MUST MEET OR EXCEED THE REQUIREMENTS OF OSHA AND CONSTELLATION AS SPECIFIED IN THEIR FALL PROTECTION REGULATIONS.

GENERAL NOTES:

1. THE GENERAL LAYOUT OF ROOFTOP PV EQUIPMENT SHOWN MAY BE SLIGHTLY ADJUSTED TO SUIT EXISTING CONDITIONS.
2. VARIABLE ROOF SLOPES AND EXISTING DRAINAGE AREAS WILL REQUIRE FIELD VERIFICATION OF IRONRIDGE RACKING ROOF PENETRATION LOCATIONS PRIOR TO INSTALLATION OF PHOTOVOLTAIC SYSTEM.
3. EXISTING ROOFTOP AREA WHERE PHOTOVOLTAIC SYSTEM WILL BE INSTALLED IS APPROXIMATELY (64,317) FT<sup>2</sup>.
4. CONTRACTOR TO COVER EXISTING SKYLIGHTS WITH MATCHING CORRUGATED ROOFING MATERIAL.

ENGINEER APPROVAL:



ROBERTO RIVERA, P.E. NO. 16743

09/10/12

DATE:

DESCRIPTION:

DATE:

REV:

PREPARED BY:



6977 NAVAJO RD., SUITE 139  
SAN DIEGO, CA 92119  
PHONE: 858.270.9333  
FAX: 858.270.9334

THIS DOCUMENT IS CONSIDERED PROTECTED  
INTELLECTUAL PROPERTY AND CONTAINS PROPRIETARY  
INFORMATION UNDER UNITED STATES LAW. NO PORTION OF  
PART OF THIS DOCUMENT MAY BE REPRODUCED FOR ANY  
PURPOSE WITHOUT THE EXPRESS WRITTEN PERMISSION OF  
SUSTINEO CORP.

OWNER/CLIENT:

MADONNA ROAD APARTMENTS  
1550 MADONNA ROAD  
SAN LUIS OBISPO, CA 93405



EVERYDAY ENERGY  
5865 AVENIDA ENCINAS,  
SUITE 142A  
CARLSBAD, CA, 92008  
P: (760) 607-7200

OVERALL PV SITE PLAN

PHOTOVOLTAIC SYSTEM

1550 MADONNA ROAD  
SAN LUIS OBISPO, CA 93405

TITLE:

PROJECT NO.:

038 - 108

APN:

140-040-003

DATE:

SEPTEMBER 10, 2012





SHEET NO.:

E3.1

4 OF 30

100% CONSTRUCTION DRAWINGS



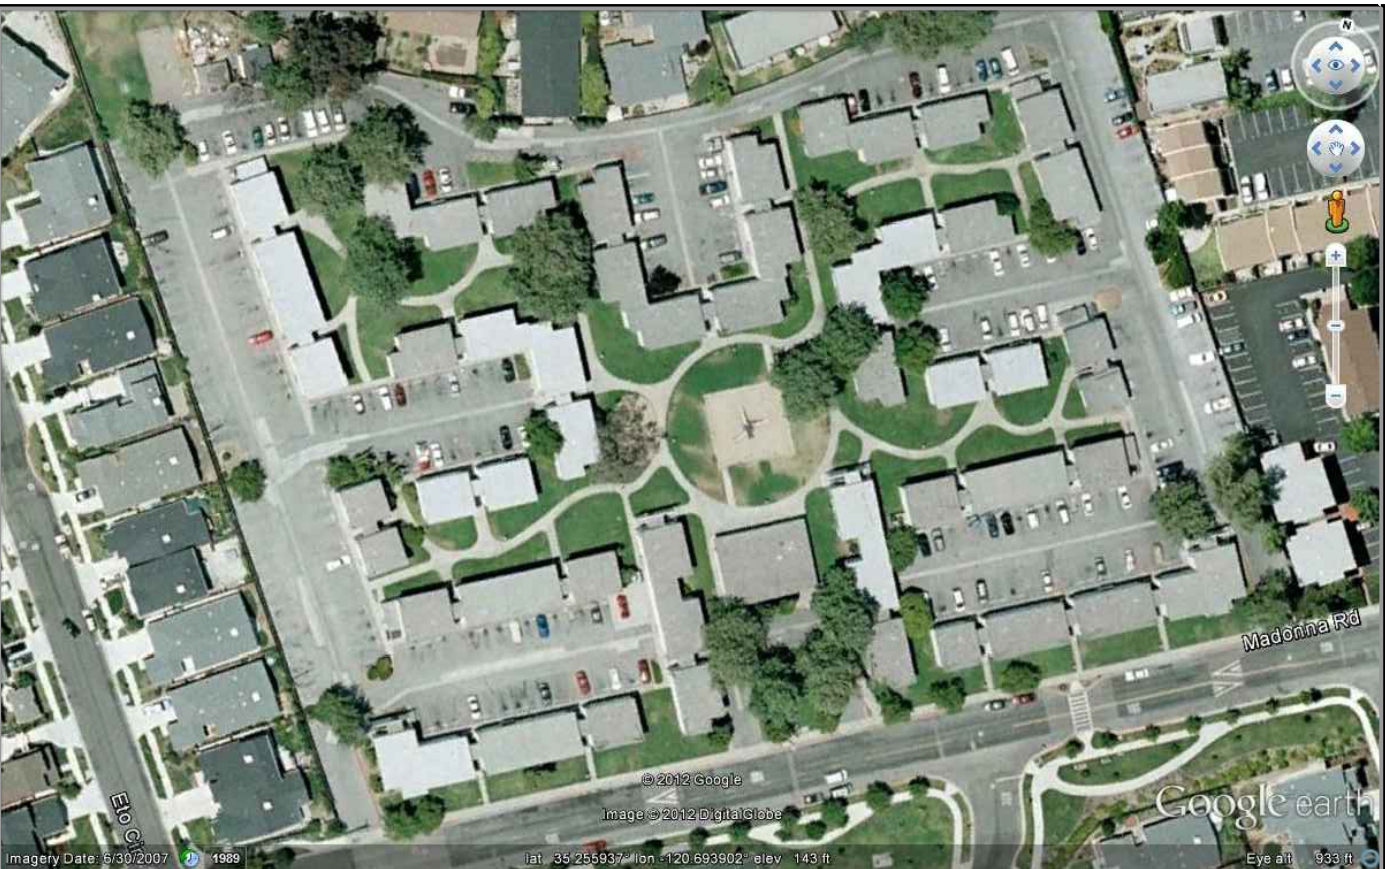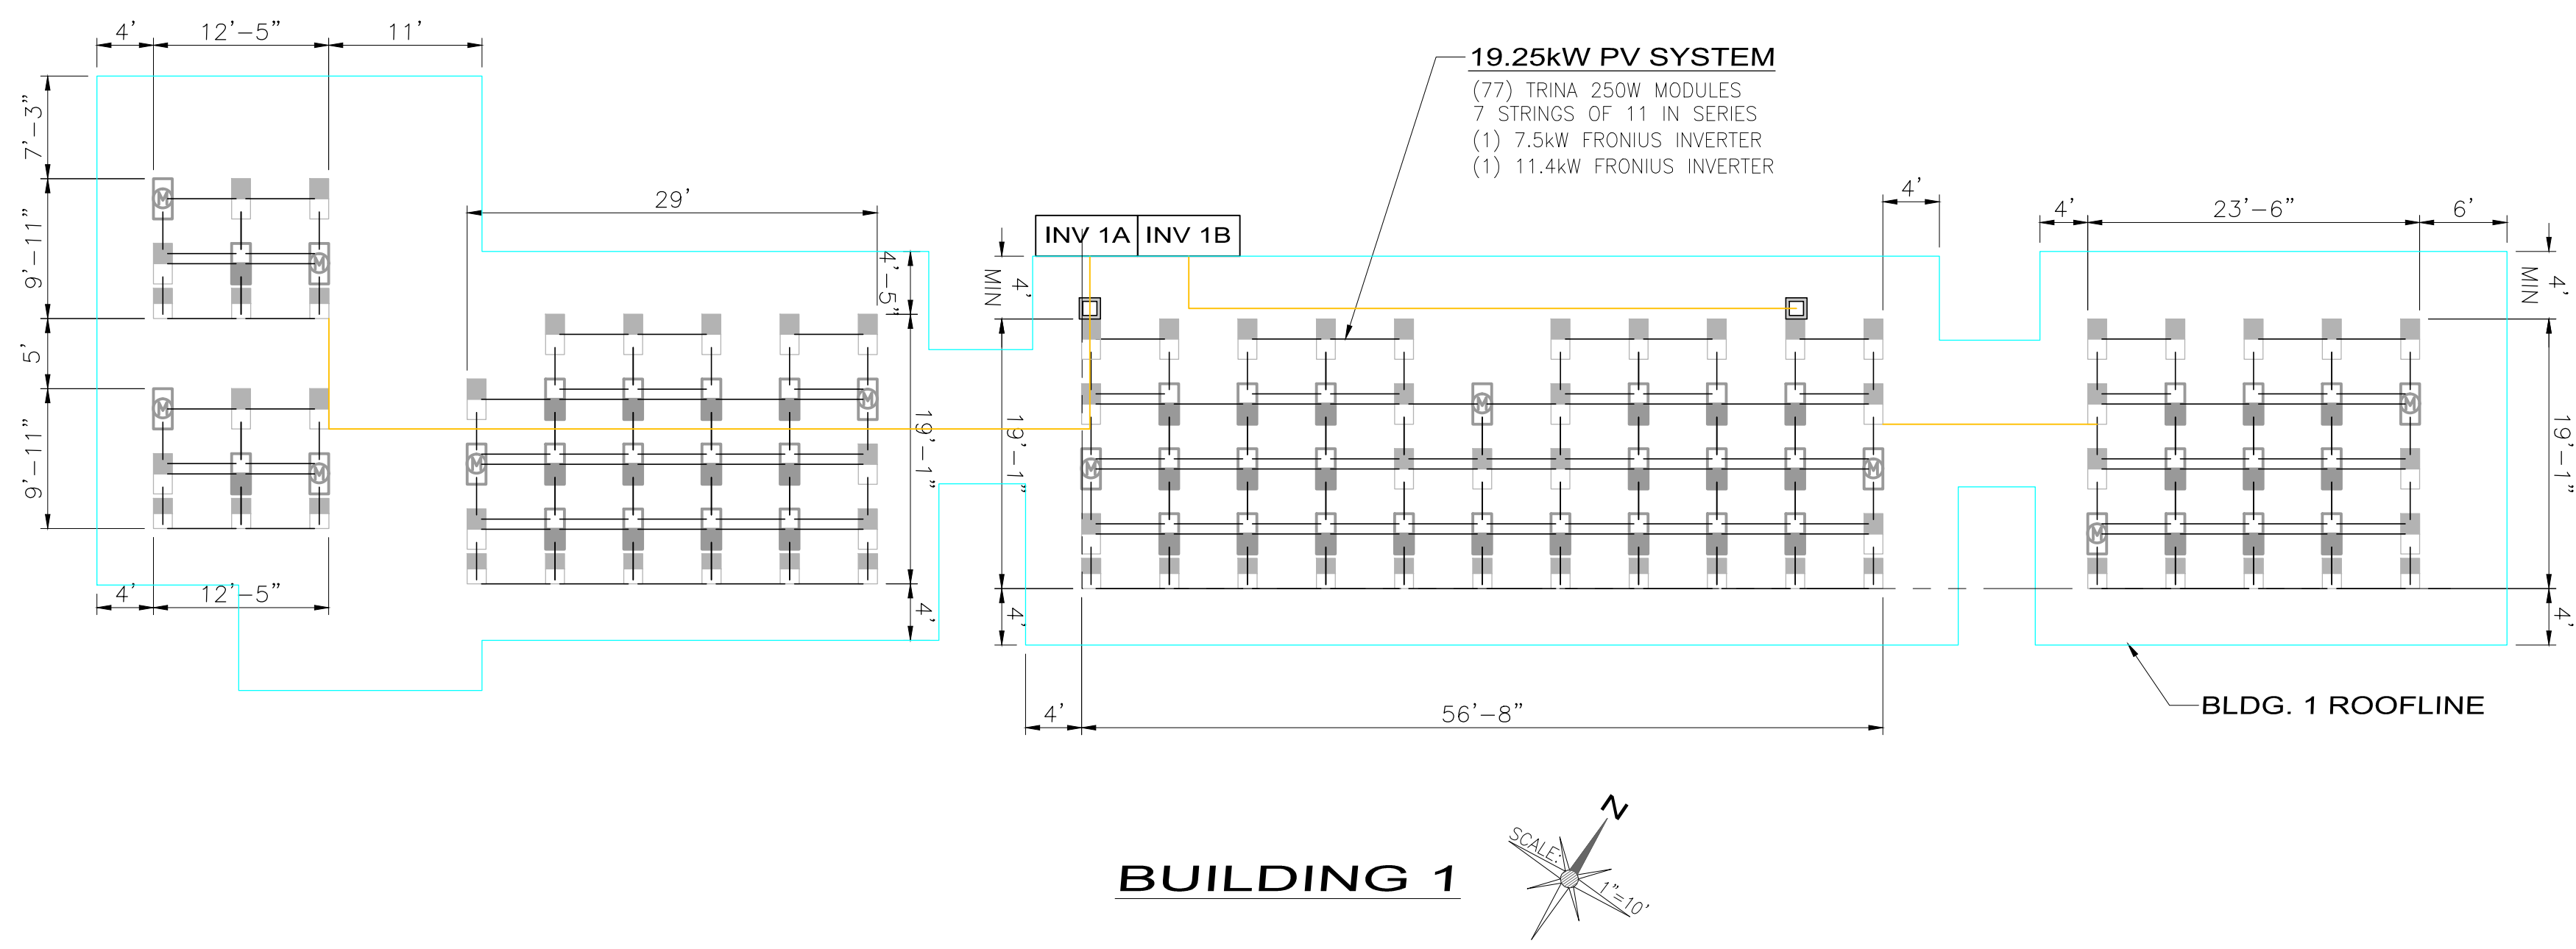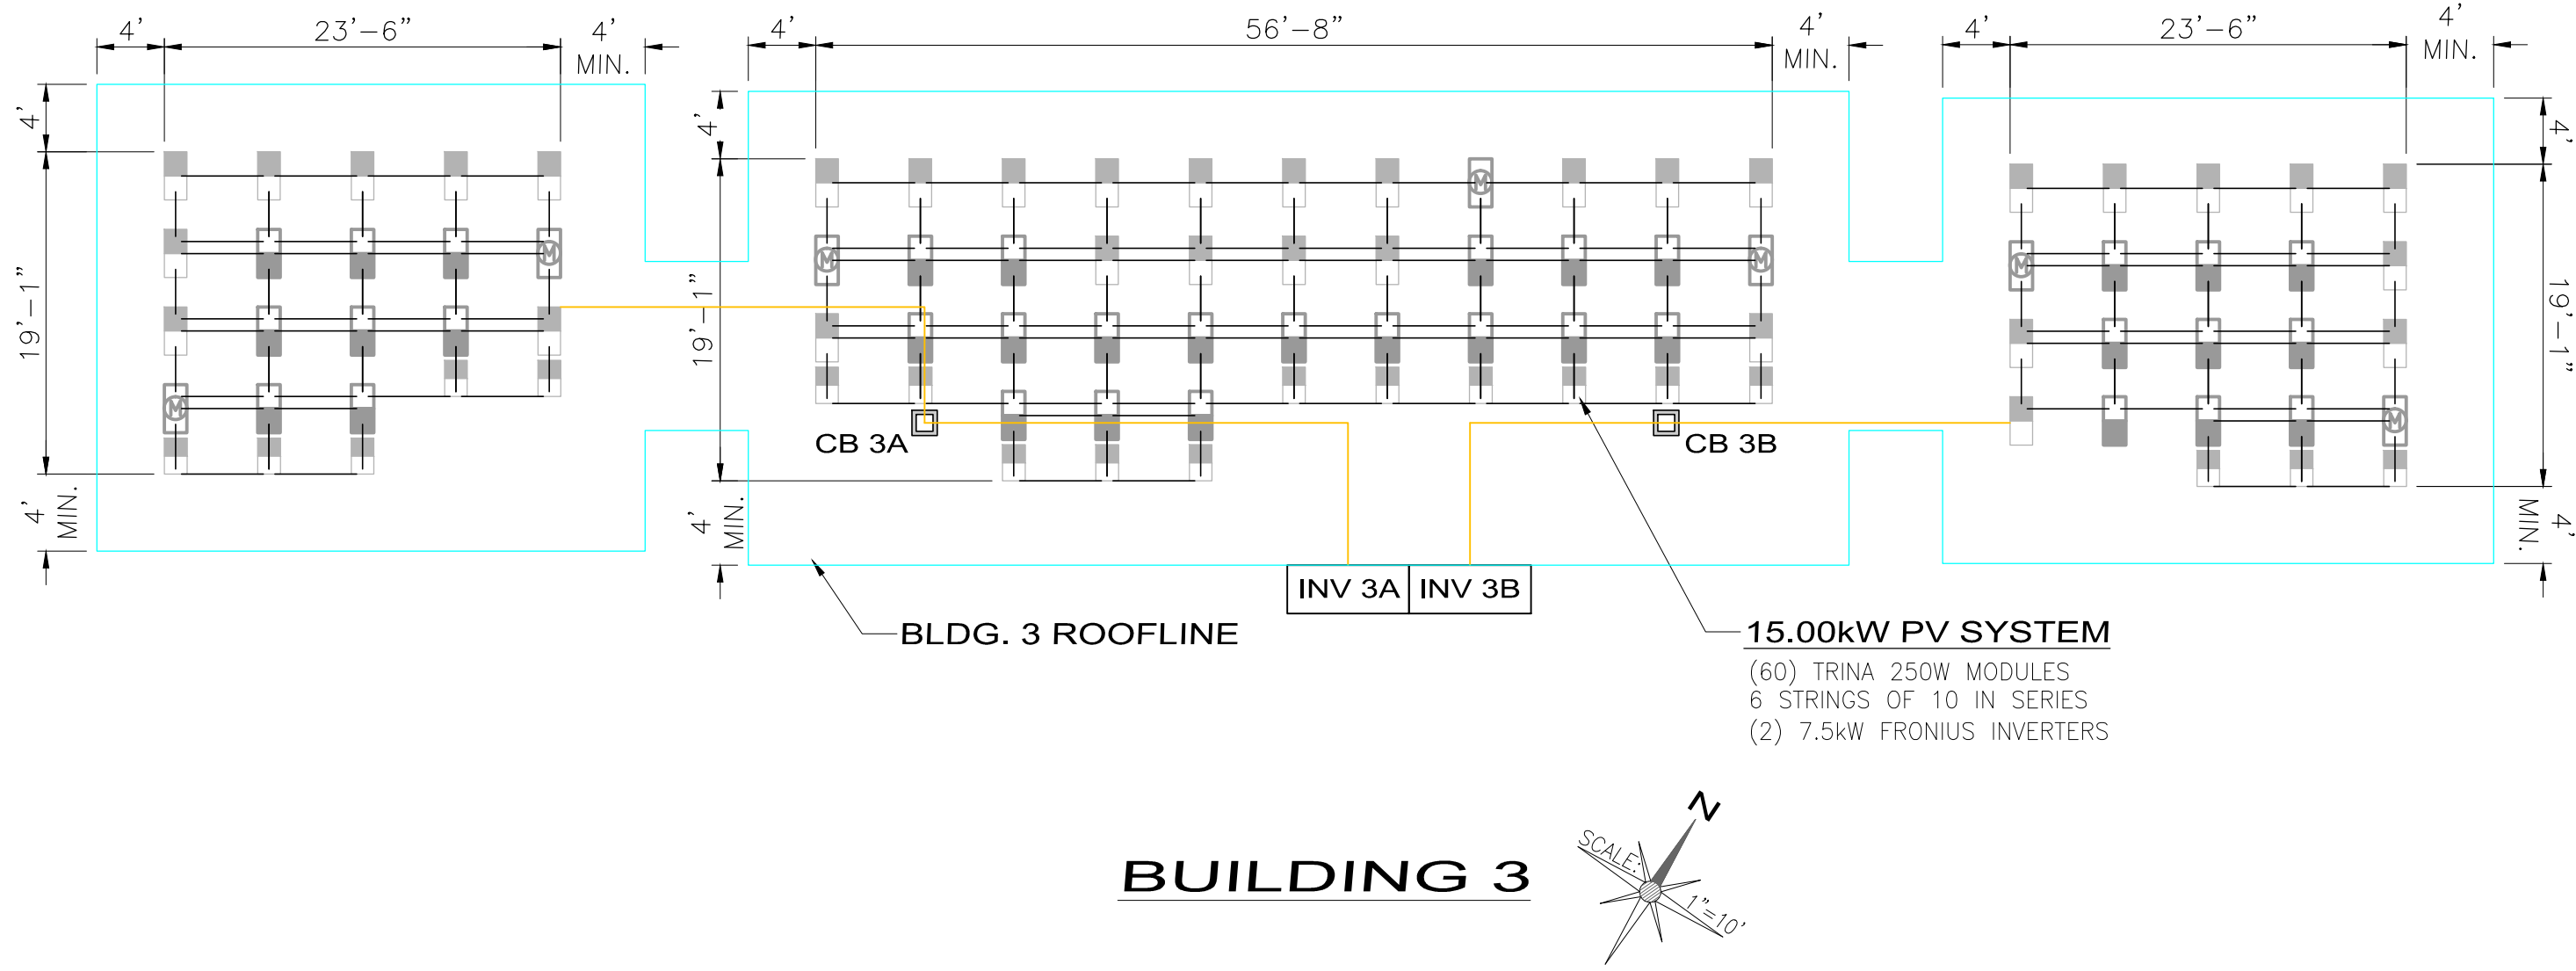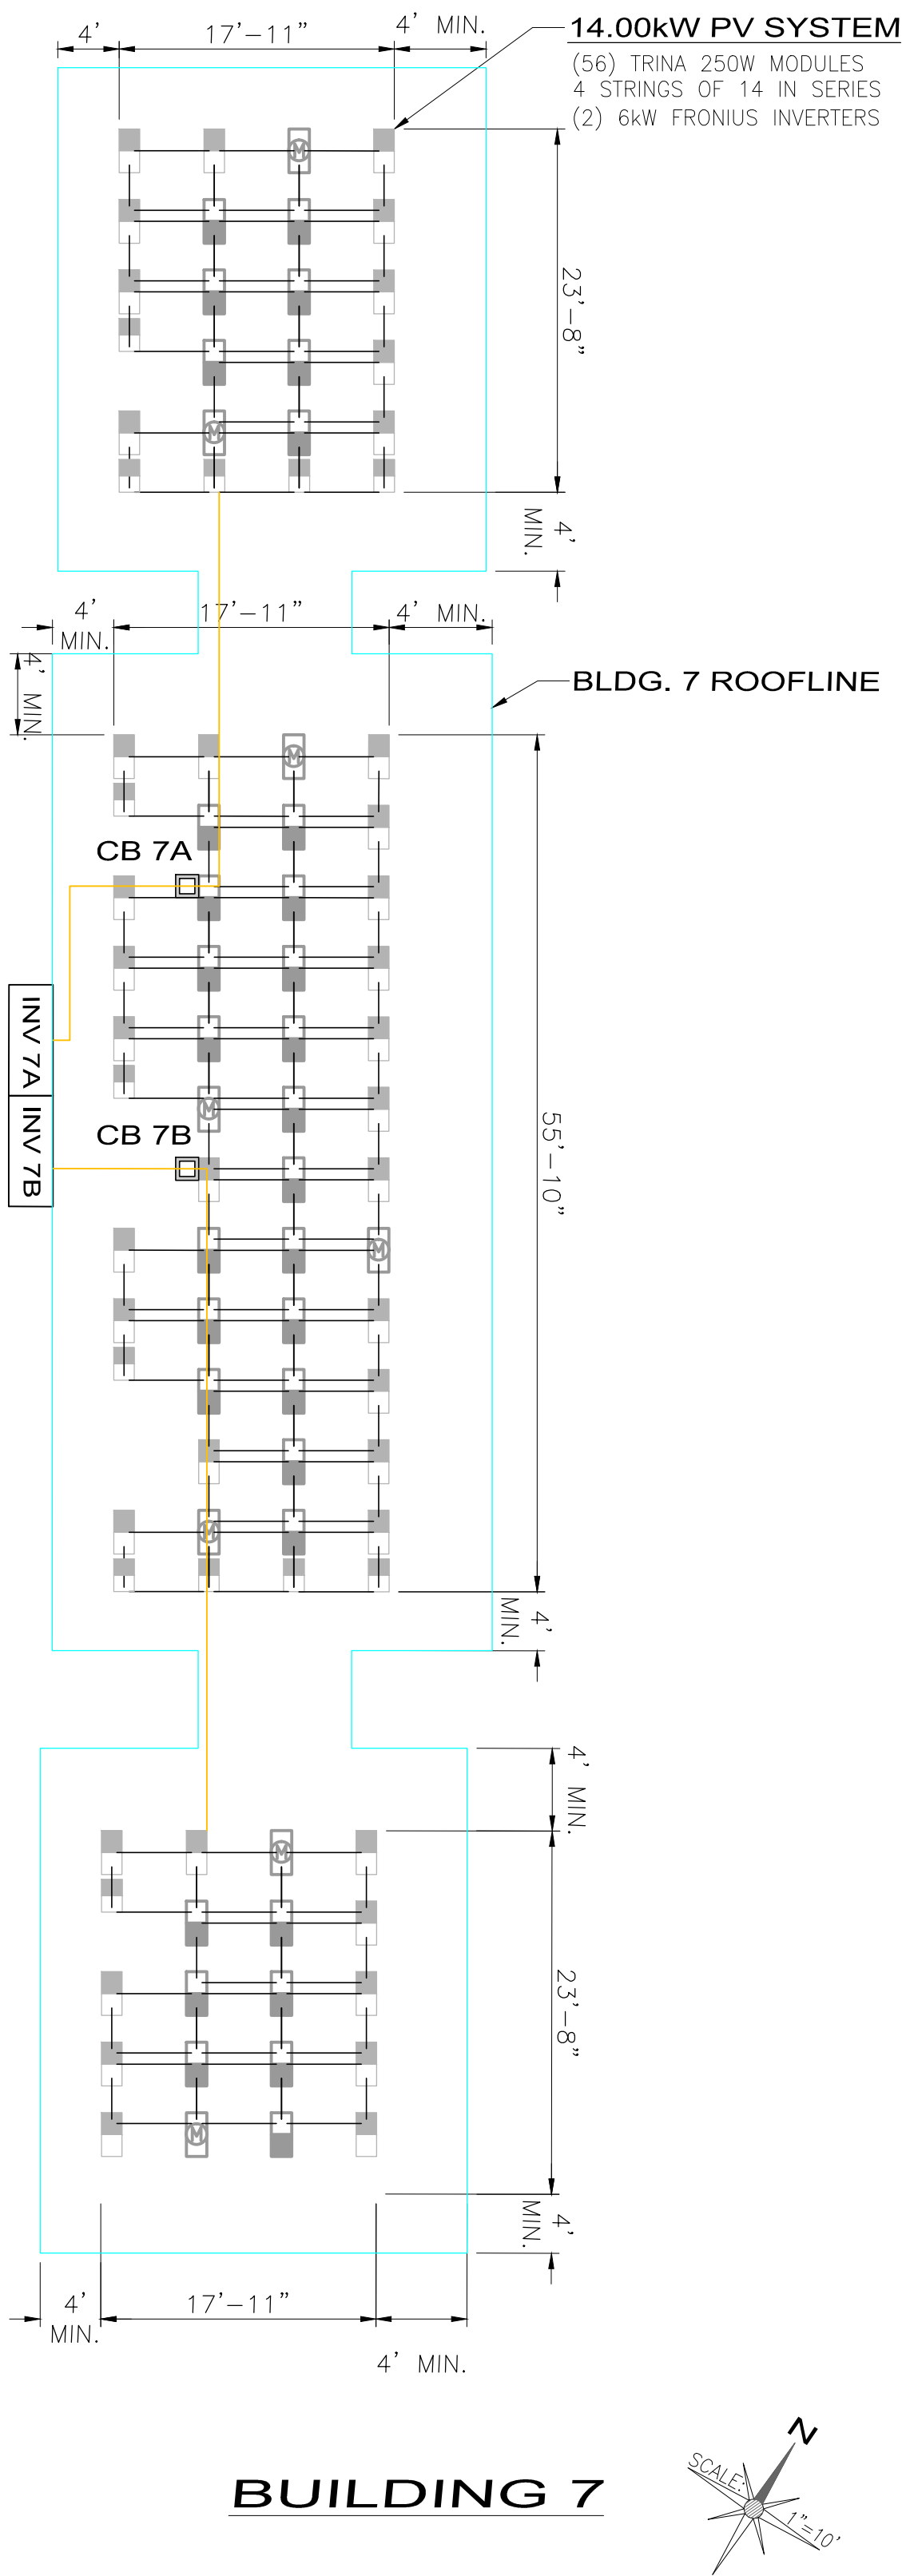

AERIAL VIEW  
NOT TO SCALE

ARRAY MOUNTING NOTES:

1. THE INSTALLATION CONTRACTOR SHALL ADHERE TO ALL REQUIREMENTS TO MAINTAIN THE ROOF WARRANTY AS SPECIFIED BY CURRENT ROOFING MATERIAL MANUFACTURER. ALL ROOFTOP PENETRATIONS SHALL BE OF AN APPROVED METHOD.
2. WHEN LOADING THE ROOF WITH CONSTRUCTION MATERIALS, THE INSTALLATION CONTRACTOR WILL BE RESPONSIBLE FOR PLACING AN APPROVED MEANS OF PROTECTION BELOW EACH PALLET OF MATERIALS TO PREVENT DAMAGE AND/OR INADVERTENT PENETRATIONS. ANY DAMAGE THAT OCCURS FROM IMPROPERLY PROTECTED MATERIALS WILL BE THE RESPONSIBILITY OF THE INSTALLATION CONTRACTOR TO REPAIR.
3. THE INSTALLATION CONTRACTOR WILL BE RESPONSIBLE FOR FOLLOWING ALL PROVIDED ROOFING LOADING DIAGRAMS. THE CONTRACTOR MUST VERIFY WITH CONSTRUCTION MANAGER FOR ALL LOCATIONS WHERE MATERIALS ARE TO BE STORED.
4. WHEN WORKING ON THE ROOF, CONTRACTOR WILL BE RESPONSIBLE FOR PROVIDING A MEANS OF FALL PROTECTION WHEN WORKING IN AREAS WITHIN 6' OF THE ROOF'S EDGES OR A 3' CHANGE IN ELEVATION. THIS FALL PROTECTION EQUIPMENT MUST MEET OR EXCEED THE REQUIREMENTS OF OSHA AND CONSTELLATION AS SPECIFIED IN THEIR FALL PROTECTION REGULATIONS.

GENERAL NOTES:

1. THE GENERAL LAYOUT OF ROOFTOP PV EQUIPMENT SHOWN MAY BE SLIGHTLY ADJUSTED TO SUIT EXISTING CONDITIONS.
2. VARIABLE ROOF SLOPES AND EXISTING DRAINAGE AREAS WILL REQUIRE FIELD VERIFICATION OF PANEL CLAW RACKING ROOF PENETRATION LOCATIONS PRIOR TO INSTALLATION OF PHOTOVOLTAIC SYSTEM.
3. EXISTING ROOFTOP AREA WHERE PHOTOVOLTAIC SYSTEM WILL BE INSTALLED IS APPROXIMATELY (64,317) FT<sup>2</sup>.

ENGINEER APPROVAL:



Roberto Rivera  
ROBERTO RIVERA, P.E. NO. 16743 DATE: 09/10/12

DESCRIPTION: 100% CONSTRUCTION DRAWINGS

DATE: 9/10/12  
REV: 1

PREPARED BY:



6977 NAVAJO RD., SUITE 139  
SAN DIEGO, CA 92119  
PHONE: 858.270.9333  
FAX: 858.270.9334

THIS DOCUMENT IS CONSIDERED PROTECTED INTELLECTUAL PROPERTY AND CONTAINS PROPRIETARY INFORMATION UNDER UNITED STATES LAW. NO PORTION OF THIS DOCUMENT MAY BE REPRODUCED FOR ANY PURPOSE WITHOUT THE EXPRESS WRITTEN PERMISSION OF SUSTINEO CORP.

OWNER/CLIENT:

MADONNA ROAD APARTMENTS  
1550 MADONNA ROAD  
SAN LUIS OBISPO, CA 93405



EVERYDAY ENERGY  
5865 AVENIDA ENCINAS,  
SUITE 142A  
CARLSBAD, CA, 92008  
P: (760) 607-7200

PV ROOFTOP LAYOUT

PHOTOVOLTAIC SYSTEM

1550 MADONNA ROAD  
SAN LUIS OBISPO, CA 93405

TITLE:

PROJECT NO.:

038 - 108

APN:

140-040-003

DATE:


SEPTEMBER 10, 2012

SHEET NO.:


E3.2

5 OF 30




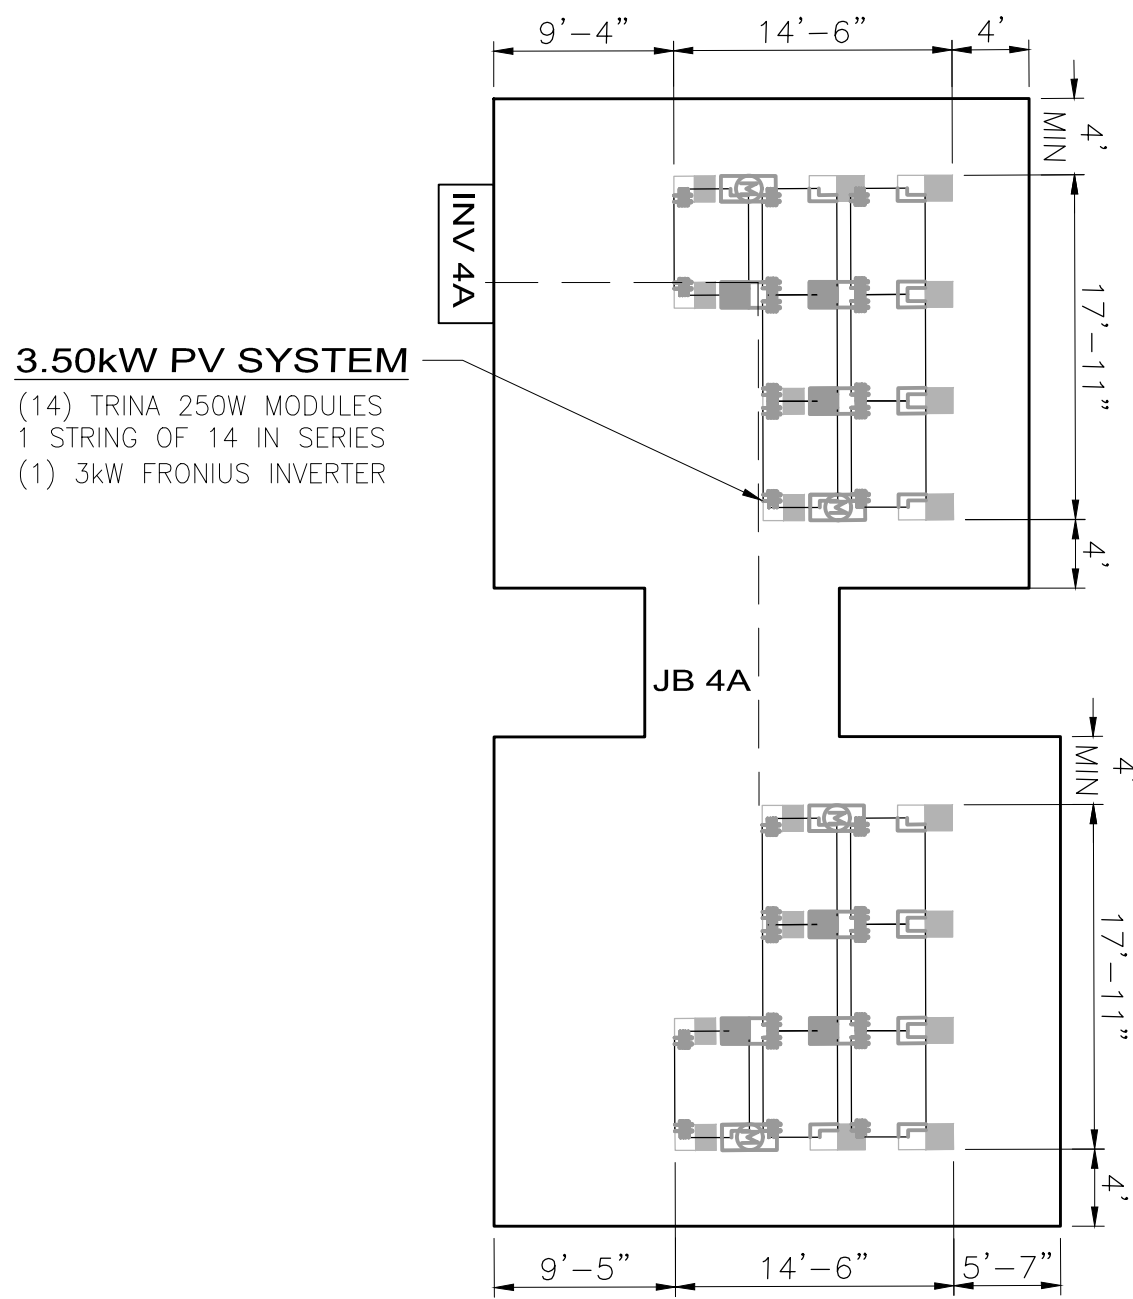


BUILDING 4

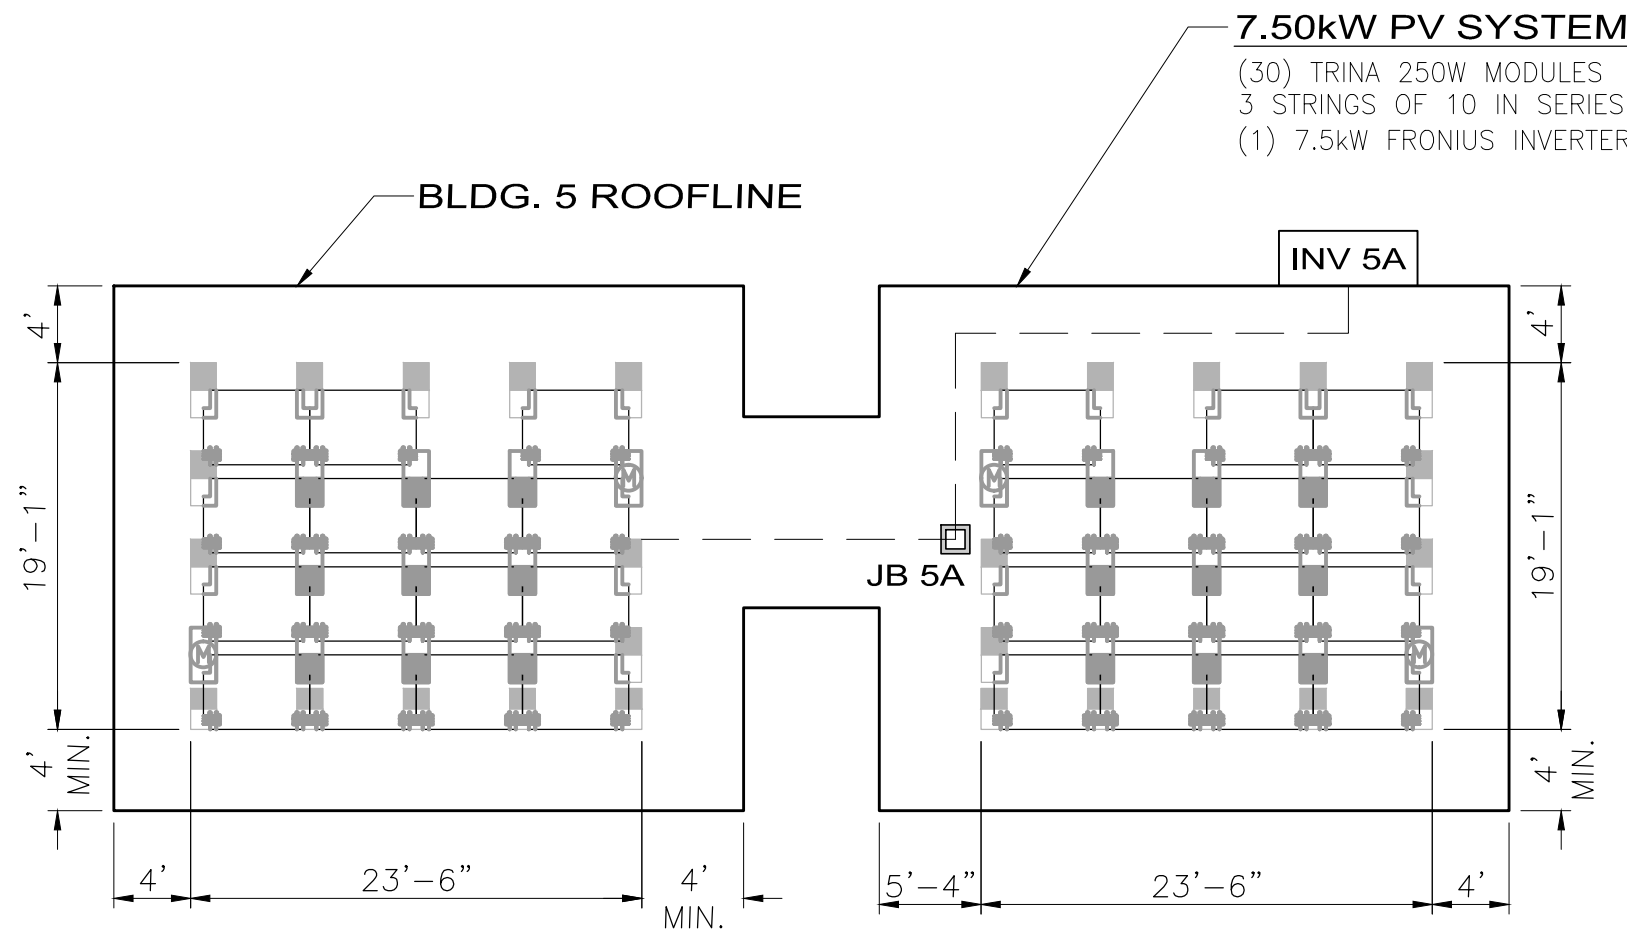

BUILDING 5

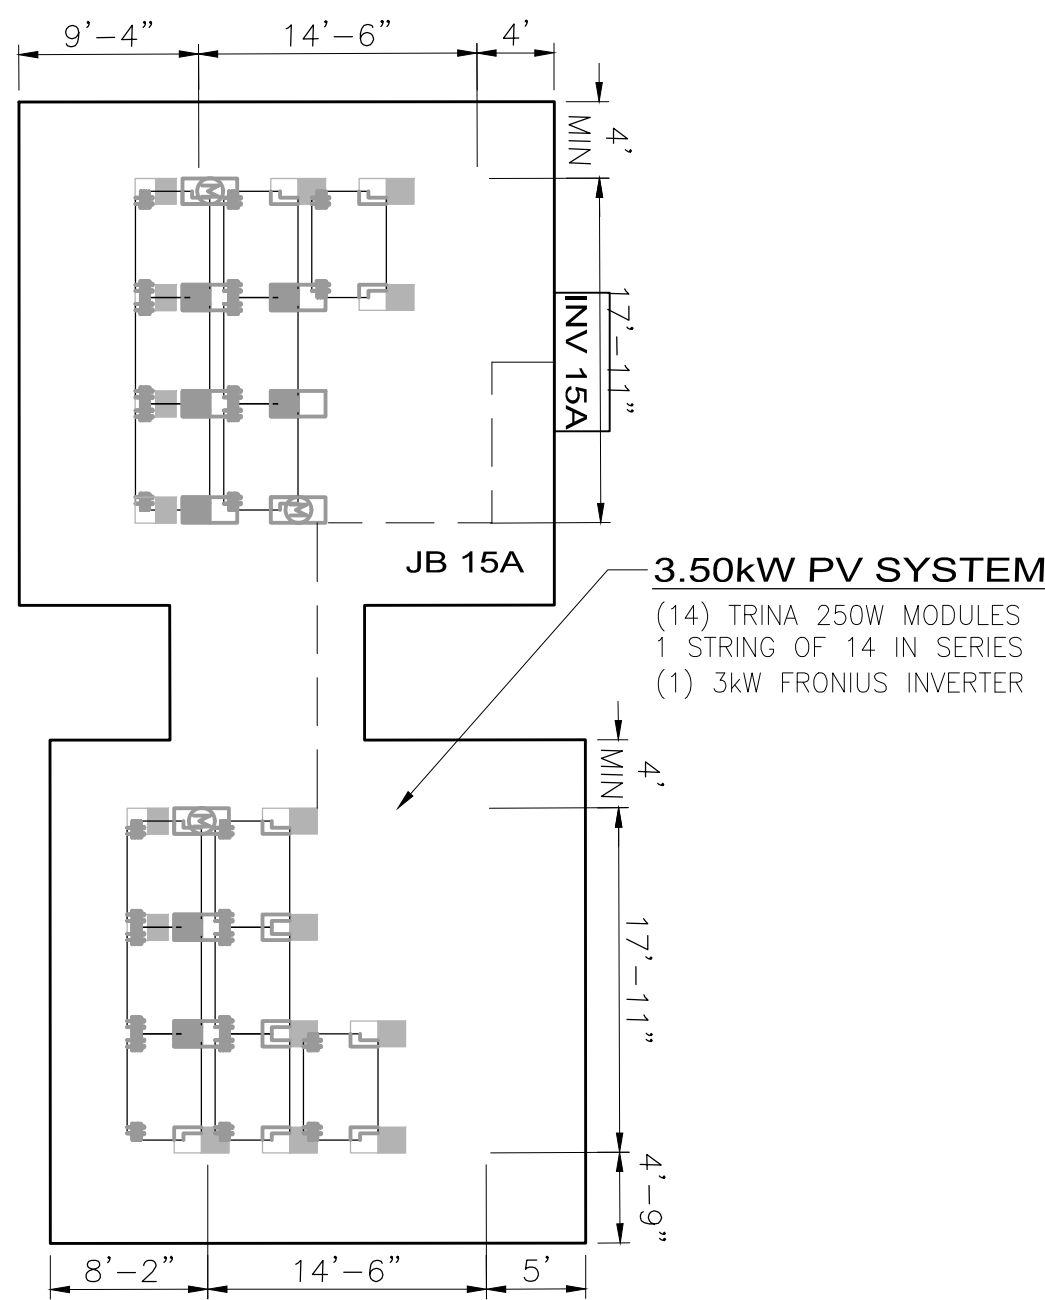

BUILDING 15

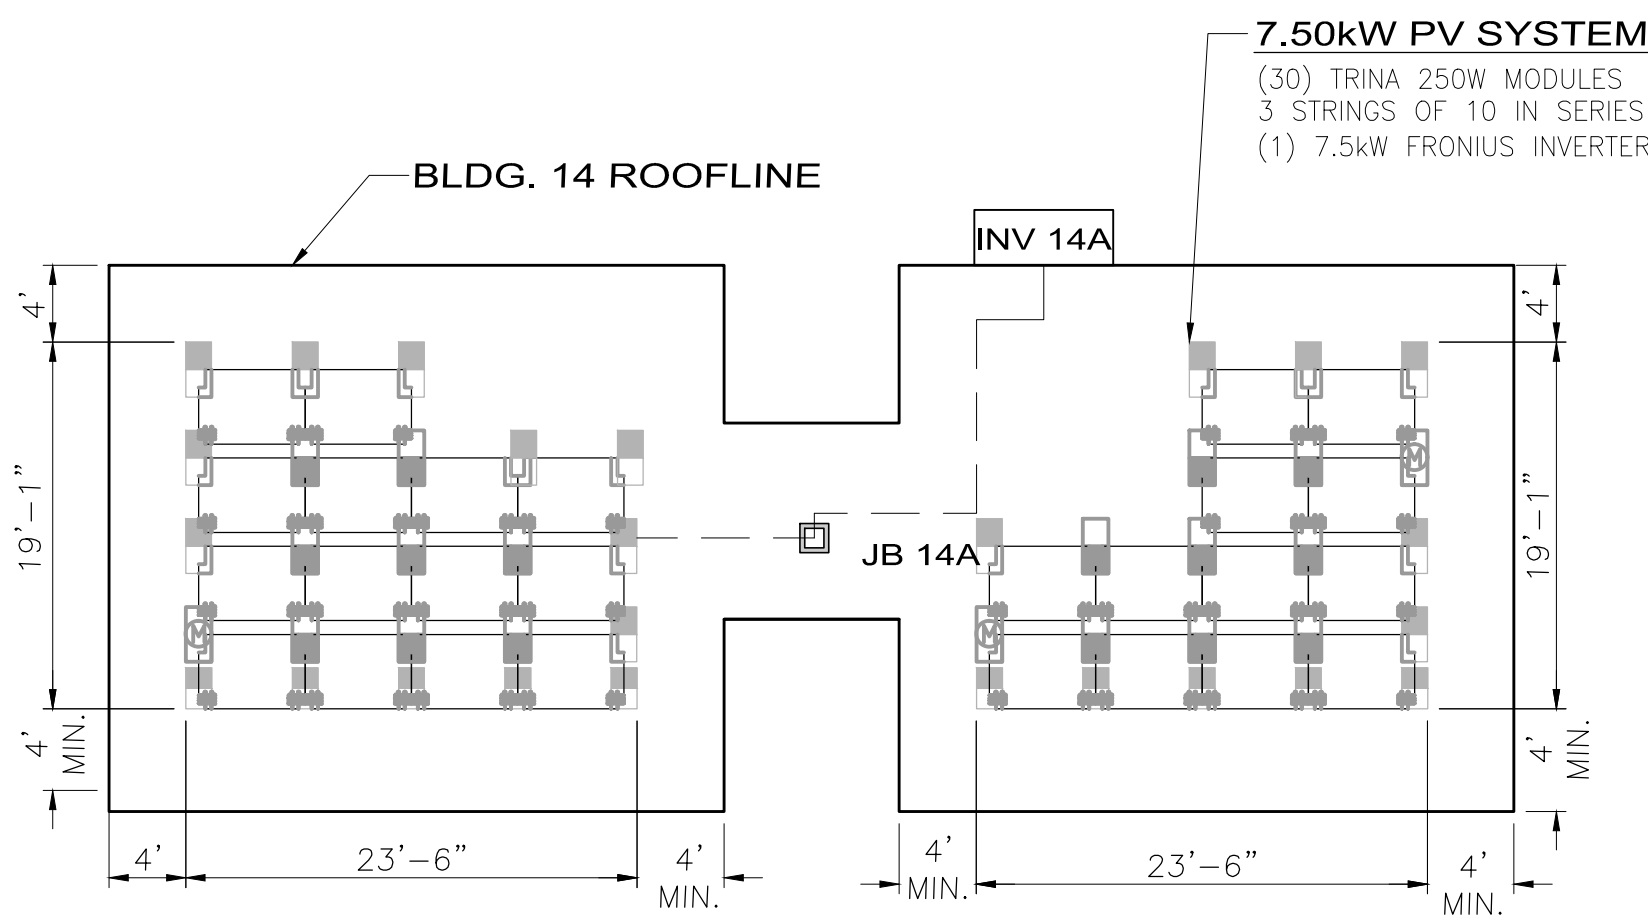

BUILDING 14



ARRAY MOUNTING NOTES:

1. THE INSTALLATION CONTRACTOR SHALL ADHERE TO ALL REQUIREMENTS TO MAINTAIN THE ROOF WARRANTY AS SPECIFIED BY CURRENT ROOFING MATERIAL MANUFACTURER. ALL ROOFTOP PENETRATIONS SHALL BE OF AN APPROVED METHOD.
2. WHEN LOADING THE ROOF WITH CONSTRUCTION MATERIALS, THE INSTALLATION CONTRACTOR WILL BE RESPONSIBLE FOR PLACING AN APPROVED MEANS OF PROTECTION BELOW EACH PALLET OF MATERIALS TO PREVENT DAMAGE AND/OR INADVERTENT PENETRATIONS. ANY DAMAGE THAT OCCURS FROM IMPROPERLY PROTECTED MATERIALS WILL BE THE RESPONSIBILITY OF THE INSTALLATION CONTRACTOR TO REPAIR.
3. THE INSTALLATION CONTRACTOR WILL BE RESPONSIBLE FOR FOLLOWING ALL PROVIDED ROOFING LOADING DIAGRAMS. THE CONTRACTOR MUST VERIFY WITH CONSTRUCTION MANAGER FOR ALL LOCATIONS WHERE MATERIALS ARE TO BE STORED.
4. WHEN WORKING ON THE ROOF, CONTRACTOR WILL BE RESPONSIBLE FOR PROVIDING A MEANS OF FALL PROTECTION WHEN WORKING IN AREAS WITHIN 6' OF THE ROOFS EDGES OR A 3' CHANGE IN ELEVATION. THIS FALL PROTECTION EQUIPMENT MUST MEET OR EXCEED THE REQUIREMENTS OF OSHA AND CONSTELLATION AS SPECIFIED IN THEIR FALL PROTECTION REGULATIONS.

GENERAL NOTES:

1. THE GENERAL LAYOUT OF ROOFTOP PV EQUIPMENT SHOWN MAY BE SLIGHTLY ADJUSTED TO SUIT EXISTING CONDITIONS.
2. VARIABLE ROOF SLOPES AND EXISTING DRAINAGE AREAS WILL REQUIRE FIELD VERIFICATION OF PANEL CLAW RACKING ROOF PENETRATION LOCATIONS PRIOR TO INSTALLATION OF PHOTOVOLTAIC SYSTEM.
3. EXISTING ROOFTOP AREA WHERE PHOTOVOLTAIC SYSTEM WILL BE INSTALLED IS APPROXIMATELY (64,317) FT<sup>2</sup>.

ENGINEER APPROVAL:



Roberto Rivera

ROBERTO RIVERA, P.E. NO. 16743

09/10/12

DATE:

DESCRIPTION:

100% CONSTRUCTION DRAWINGS

DATE:

9/10/12

REV:

1

PREPARED BY:



6977 NAVAJO RD., SUITE 139  
SAN DIEGO, CA 92119  
PHONE: 858.270.9333  
FAX: 858.270.9334

THIS DOCUMENT IS CONSIDERED PROTECTED  
INTELLECTUAL PROPERTY AND CONTAINS PROPRIETARY  
INFORMATION UNDER UNITED STATES LAW. NO PORTION OF  
PART OF THIS DOCUMENT MAY BE REPRODUCED FOR ANY  
PURPOSE WITHOUT THE EXPRESS WRITTEN PERMISSION OF  
SUSTINEO CORP.

OWNER/CLIENT:

MADONNA ROAD APARTMENTS  
1550 MADONNA ROAD  
SAN LUIS OBISPO, CA 93405



EVERYDAY ENERGY  
5865 AVENIDA ENCINAS,  
SUITE 142A  
CARLSBAD, CA, 92008  
P: (760) 607-7200

PV ROOFTOP LAYOUT

PHOTOVOLTAIC SYSTEM

1550 MADONNA ROAD  
SAN LUIS OBISPO, CA 93405

TITLE:

PROJECT NO.:

038 - 108

APN:

140-040-003

DATE:


SEPTEMBER 10, 2012

SHEET NO.:


E3.3

6 OF 30



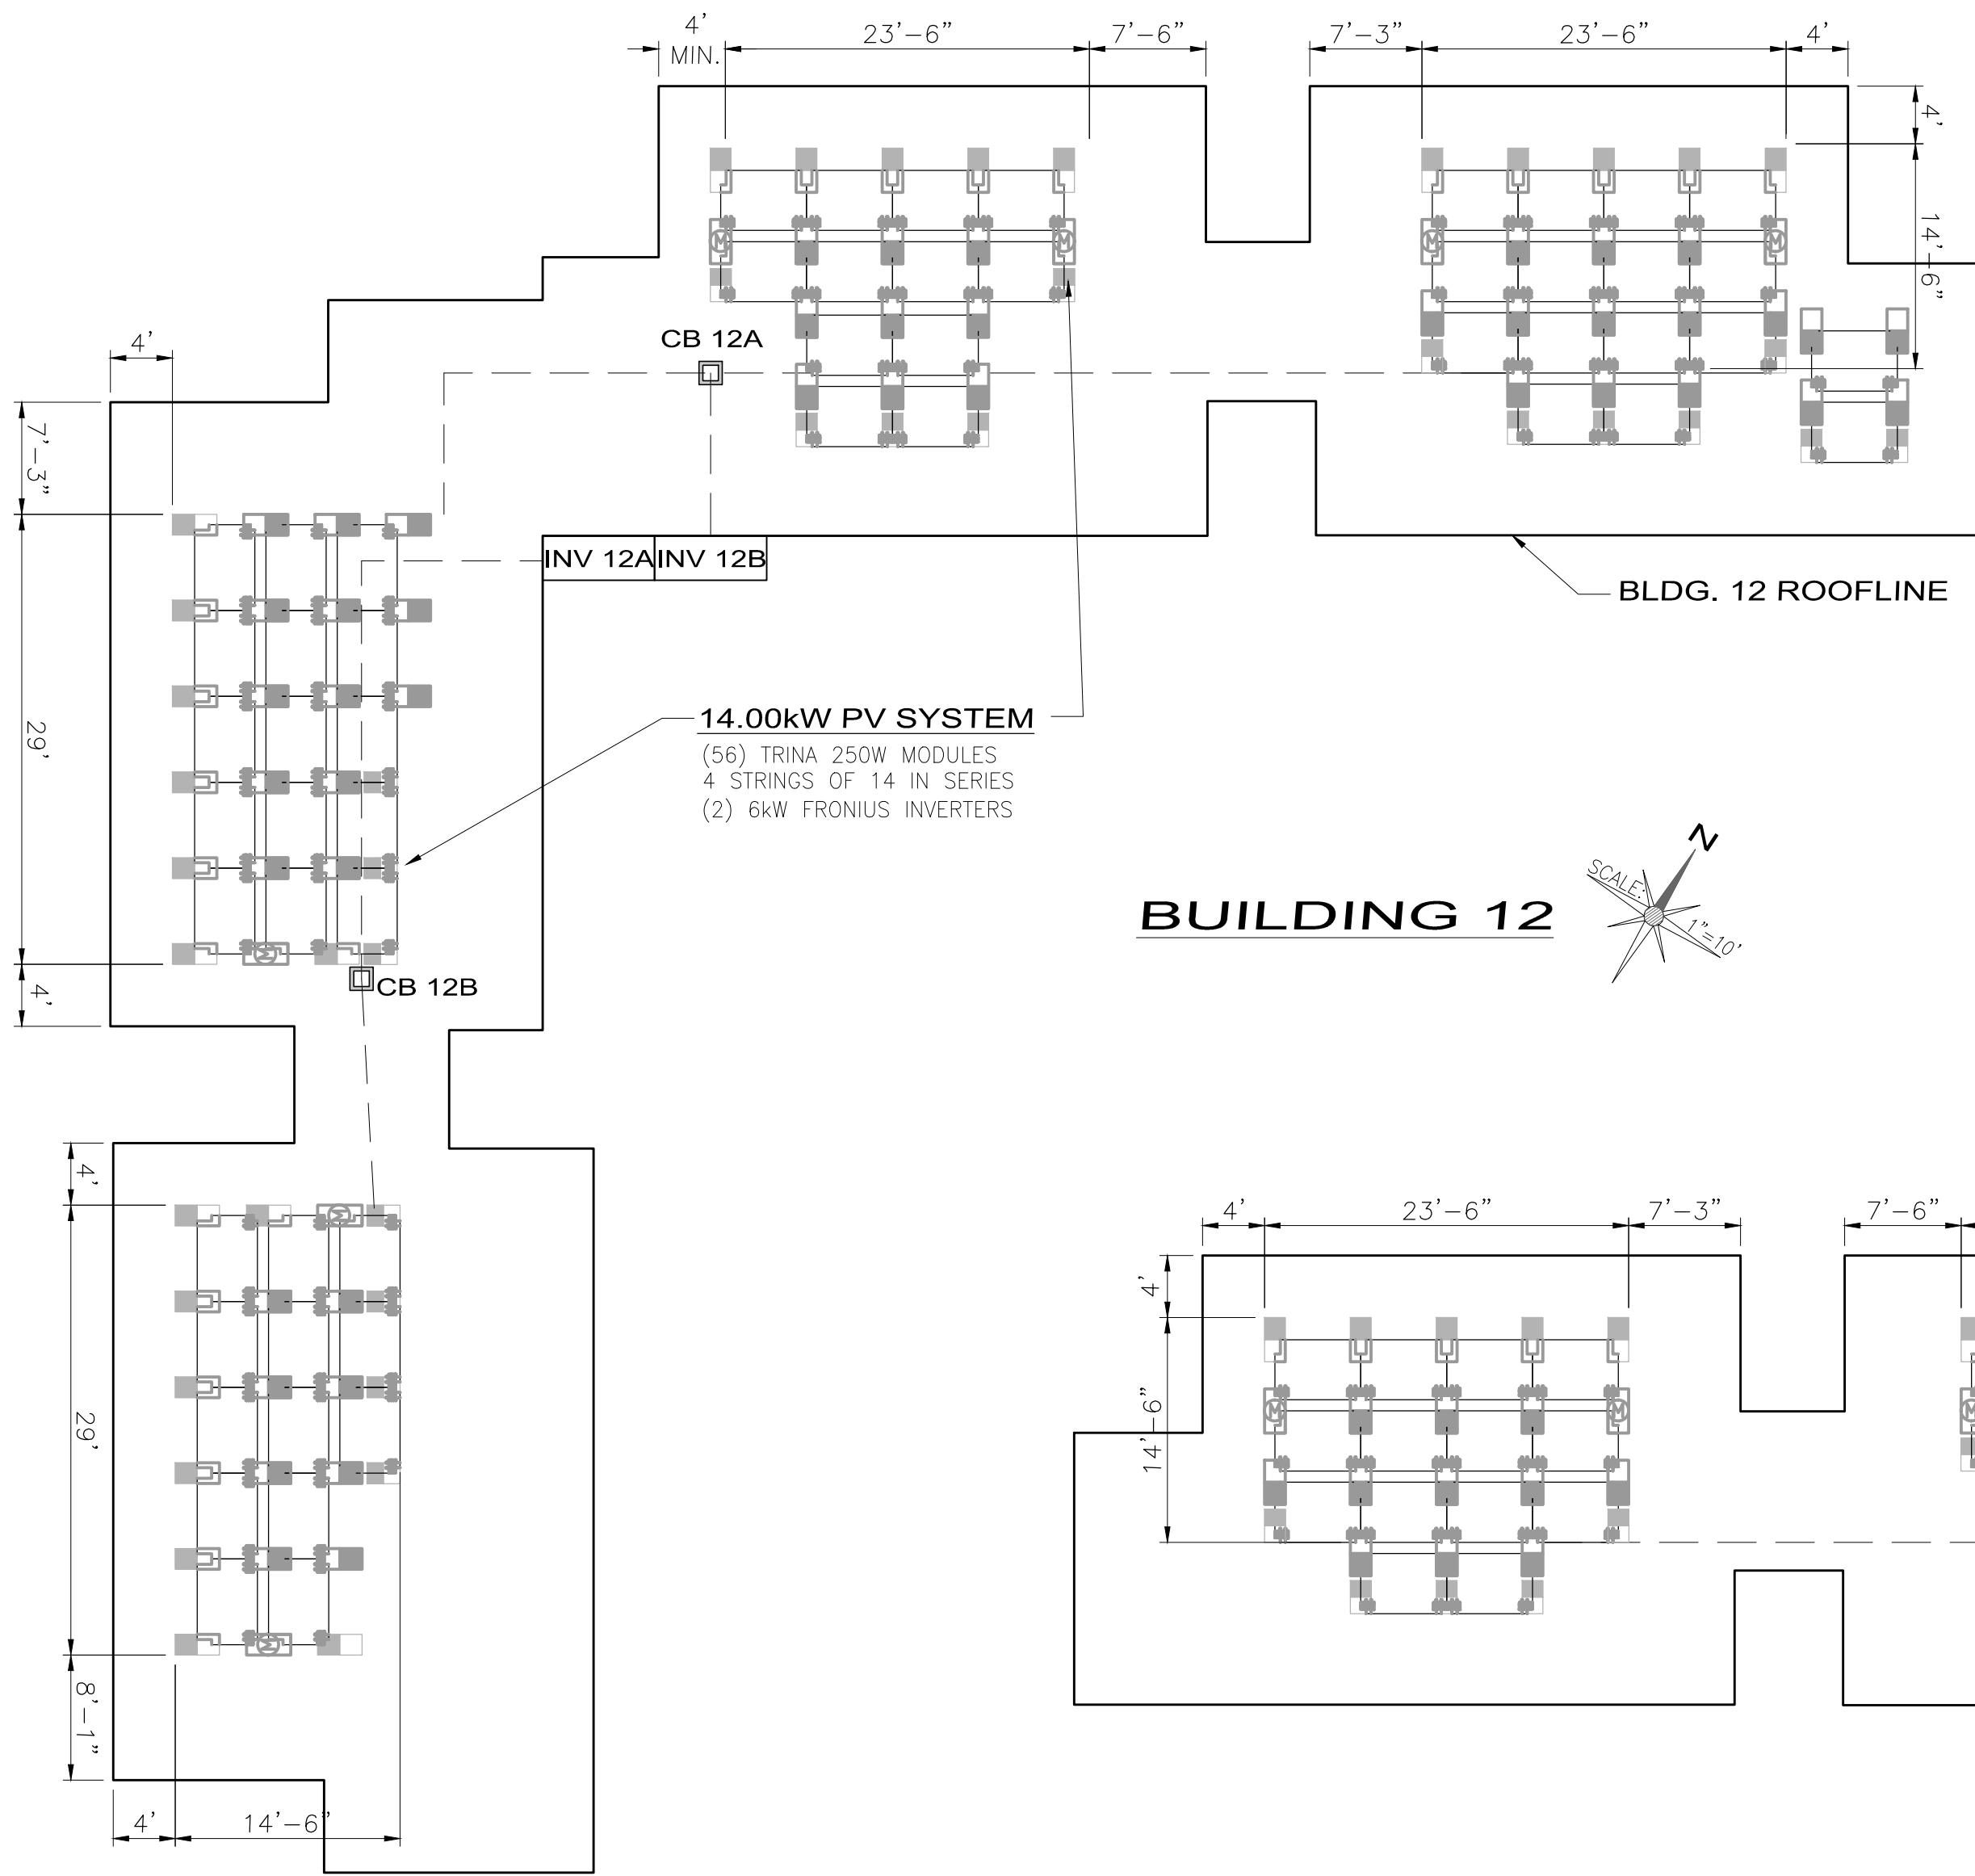

BUILDING 12

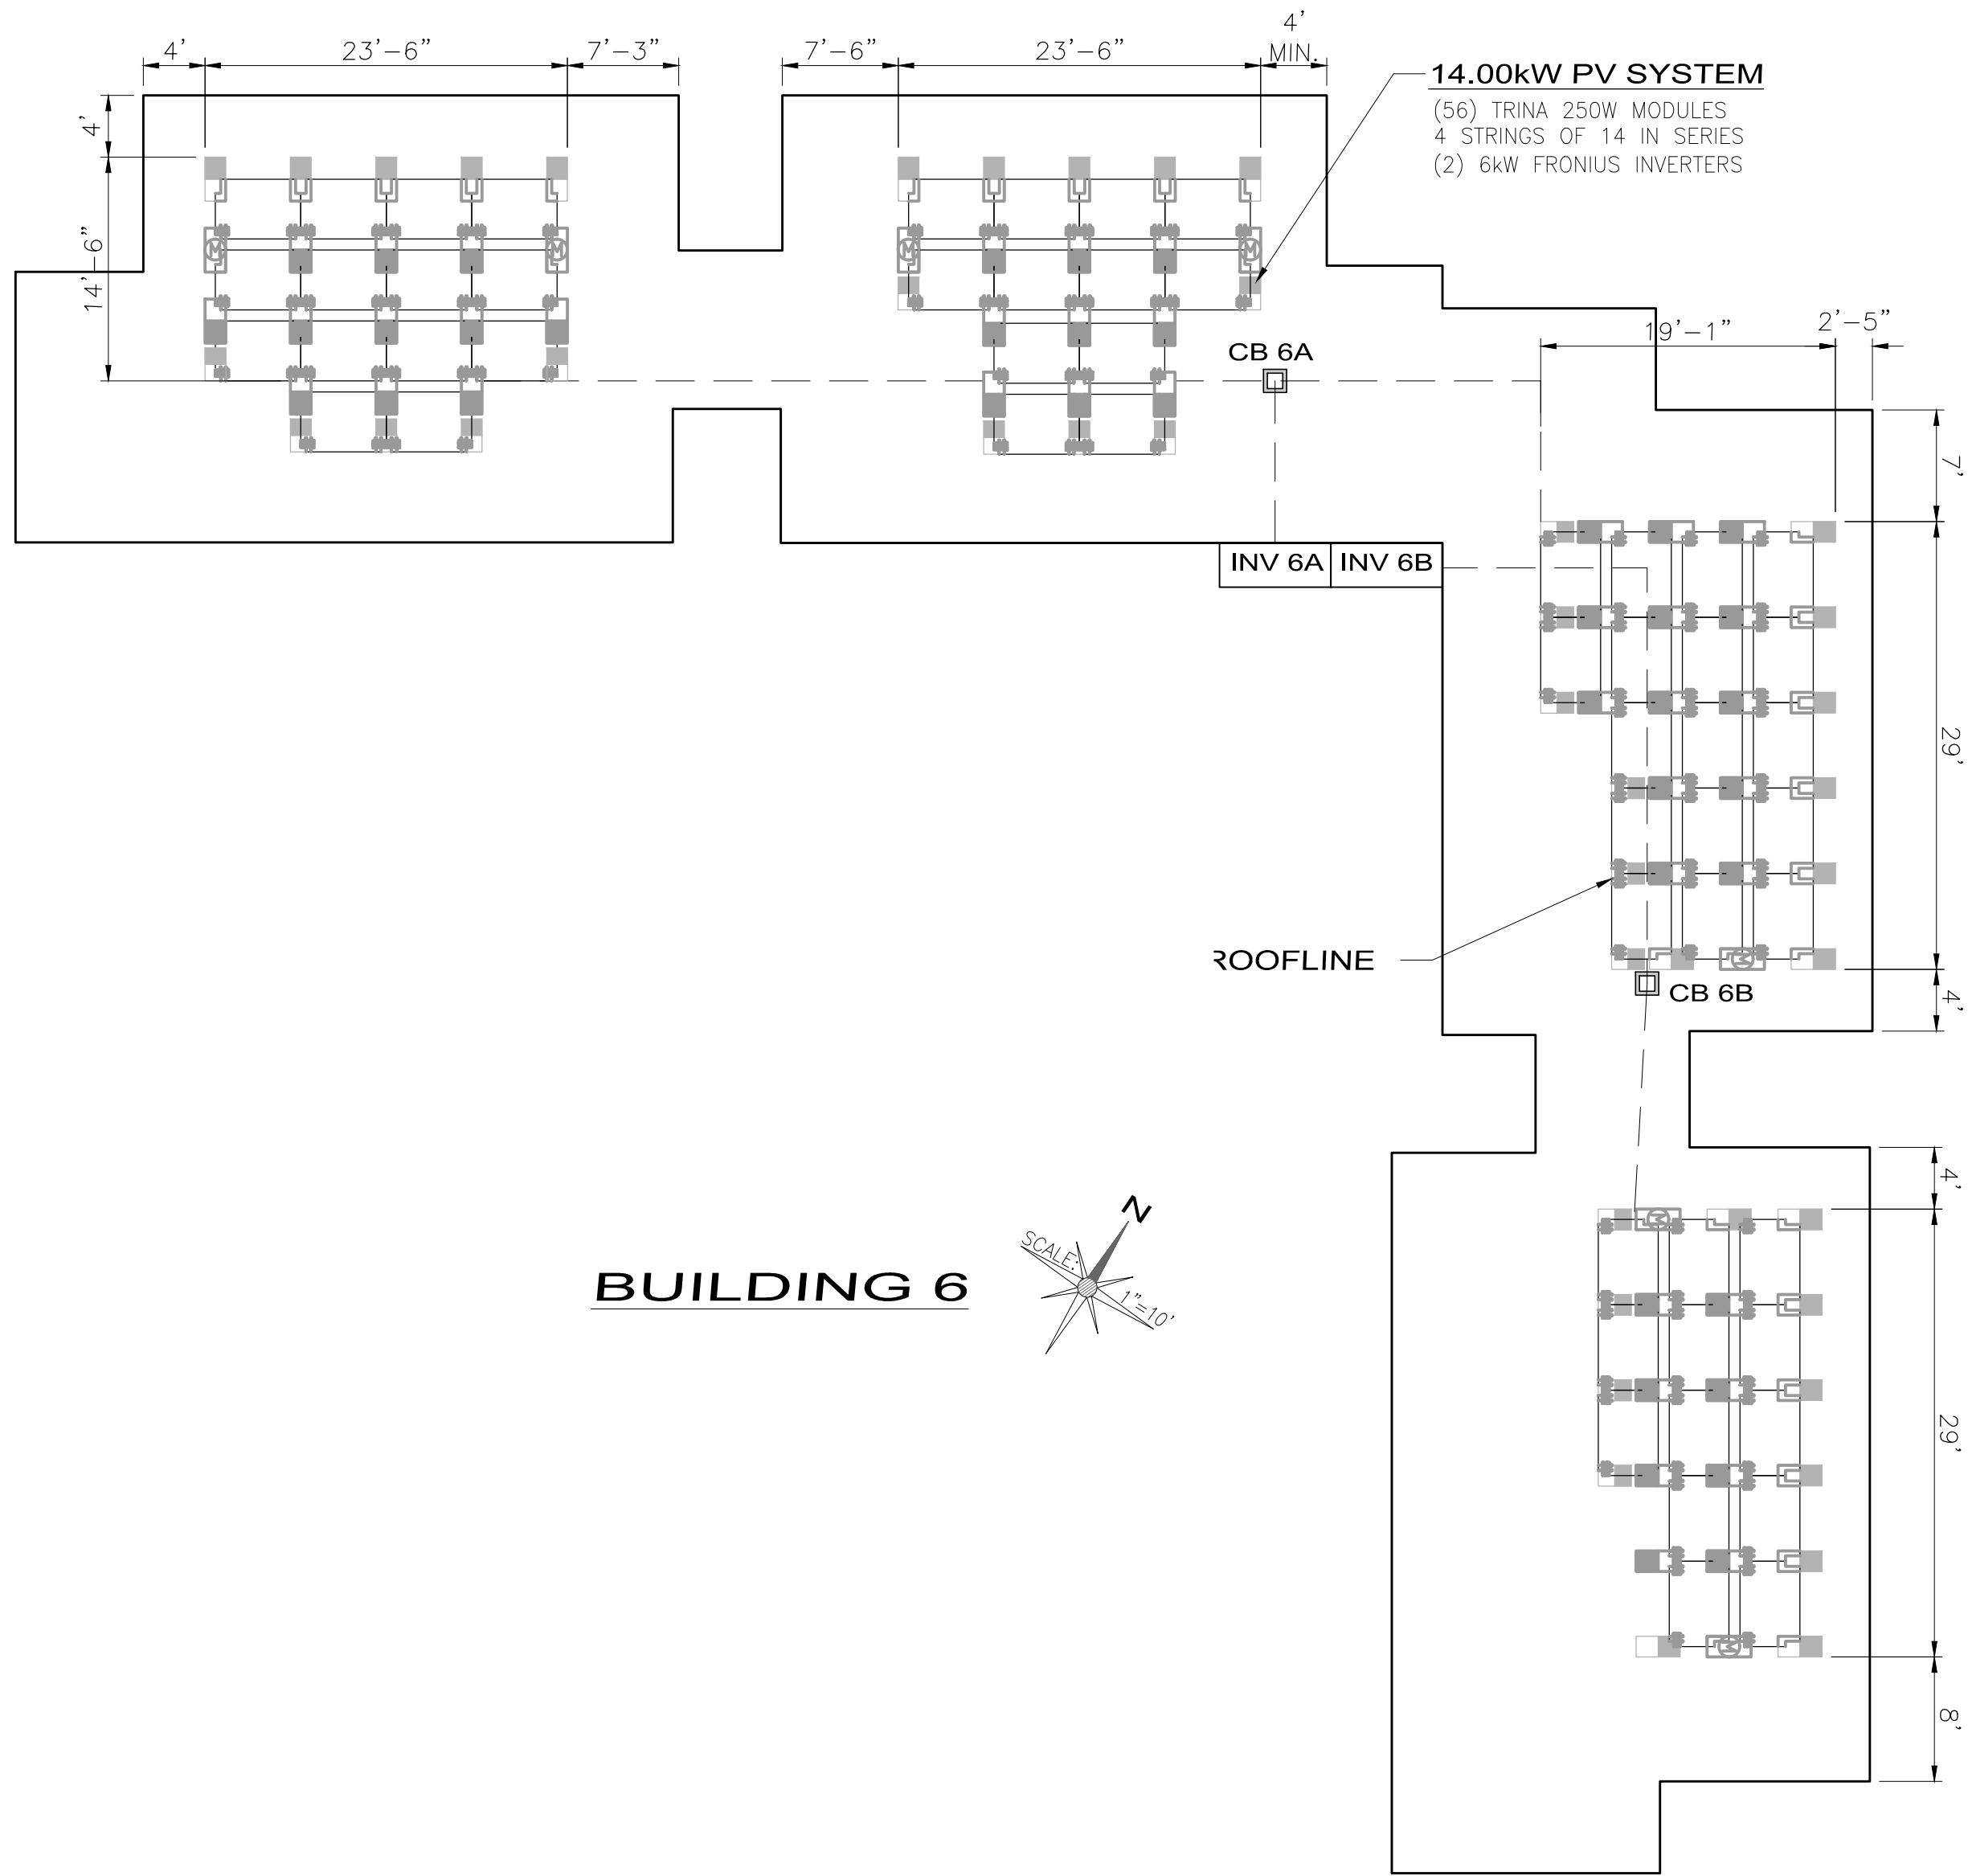

BUILDING 6

PV ROOFTOP LAYOUT - BUILDINGS 6 & 12  
SCALE: 1"=10'



AERIAL VIEW  
NOT TO SCALE

ARRAY MOUNTING NOTES:

1. THE INSTALLATION CONTRACTOR SHALL ADHERE TO ALL REQUIREMENTS TO MAINTAIN THE ROOF WARRANTY AS SPECIFIED BY CURRENT ROOFING MATERIAL MANUFACTURER. ALL ROOFTOP PENETRATIONS SHALL BE OF AN APPROVED METHOD.
2. WHEN LOADING THE ROOF WITH CONSTRUCTION MATERIALS, THE INSTALLATION CONTRACTOR WILL BE RESPONSIBLE FOR PLACING AN APPROVED MEANS OF PROTECTION BELOW EACH PALLET OF MATERIALS TO PREVENT DAMAGE AND/OR INADVERTENT PENETRATIONS. ANY DAMAGE THAT OCCURS FROM IMPROPERLY PROTECTED MATERIALS WILL BE THE RESPONSIBILITY OF THE INSTALLATION CONTRACTOR TO REPAIR.
3. THE INSTALLATION CONTRACTOR WILL BE RESPONSIBLE FOR FOLLOWING ALL PROVIDED ROOFING LOADING DIAGRAMS. THE CONTRACTOR MUST VERIFY WITH CONSTRUCTION MANAGER FOR ALL LOCATIONS WHERE MATERIALS ARE TO BE STORED.
4. WHEN WORKING ON THE ROOF, CONTRACTOR WILL BE RESPONSIBLE FOR PROVIDING A MEANS OF FALL PROTECTION WHEN WORKING IN AREAS WITHIN 6' OF THE ROOFS EDGES OR A 3' CHANGE IN ELEVATION. THIS FALL PROTECTION EQUIPMENT MUST MEET OR EXCEED THE REQUIREMENTS OF OSHA AND CONSTELLATION AS SPECIFIED IN THEIR FALL PROTECTION REGULATIONS.

GENERAL NOTES:

1. THE GENERAL LAYOUT OF ROOFTOP PV EQUIPMENT SHOWN MAY BE SLIGHTLY ADJUSTED TO SUIT EXISTING CONDITIONS.
2. VARIABLE ROOF SLOPES AND EXISTING DRAINAGE AREAS WILL REQUIRE FIELD VERIFICATION OF PANEL CLAW RACKING ROOF PENETRATION LOCATIONS PRIOR TO INSTALLATION OF PHOTOVOLTAIC SYSTEM.
3. EXISTING ROOFTOP AREA WHERE PHOTOVOLTAIC SYSTEM WILL BE INSTALLED IS APPROXIMATELY (64,317) FT<sup>2</sup>.

ENGINEER APPROVAL:



Roberto Rivera

ROBERTO RIVERA, P.E. NO. 16743

09/10/12

DATE:

DESCRIPTION:

100% CONSTRUCTION DRAWINGS

DATE:

9/10/12

REV:

1

PREPARED BY:



6977 NAVAJO RD., SUITE 139  
SAN DIEGO, CA 92119  
PHONE: 858.270.9333  
FAX: 858.270.9334

THIS DOCUMENT IS CONSIDERED PROTECTED  
INTELLECTUAL PROPERTY AND CONTAINS PROPRIETARY  
INFORMATION UNDER UNITED STATES LAW. NO PORTION OF  
PART OF THIS DOCUMENT MAY BE REPRODUCED FOR ANY  
PURPOSE WITHOUT THE EXPLICIT WRITTEN PERMISSION OF  
SUSTINEO CORP.

OWNER/CLIENT:

MADONNA ROAD APARTMENTS  
1550 MADONNA ROAD  
SAN LUIS OBISPO, CA 93405



EVERYDAY ENERGY  
5865 AVENIDA ENCINAS,  
SUITE 142A  
CARLSBAD, CA, 92008  
P: (760) 607-7200

PV ROOFTOP LAYOUT

PHOTOVOLTAIC SYSTEM

1550 MADONNA ROAD  
SAN LUIS OBISPO, CA 93405

TITLE:

PROJECT NO.:

038 - 108

APN:

140-040-003

DATE:


SEPTEMBER 10, 2012

SHEET NO.:



E3.4

7 OF 30





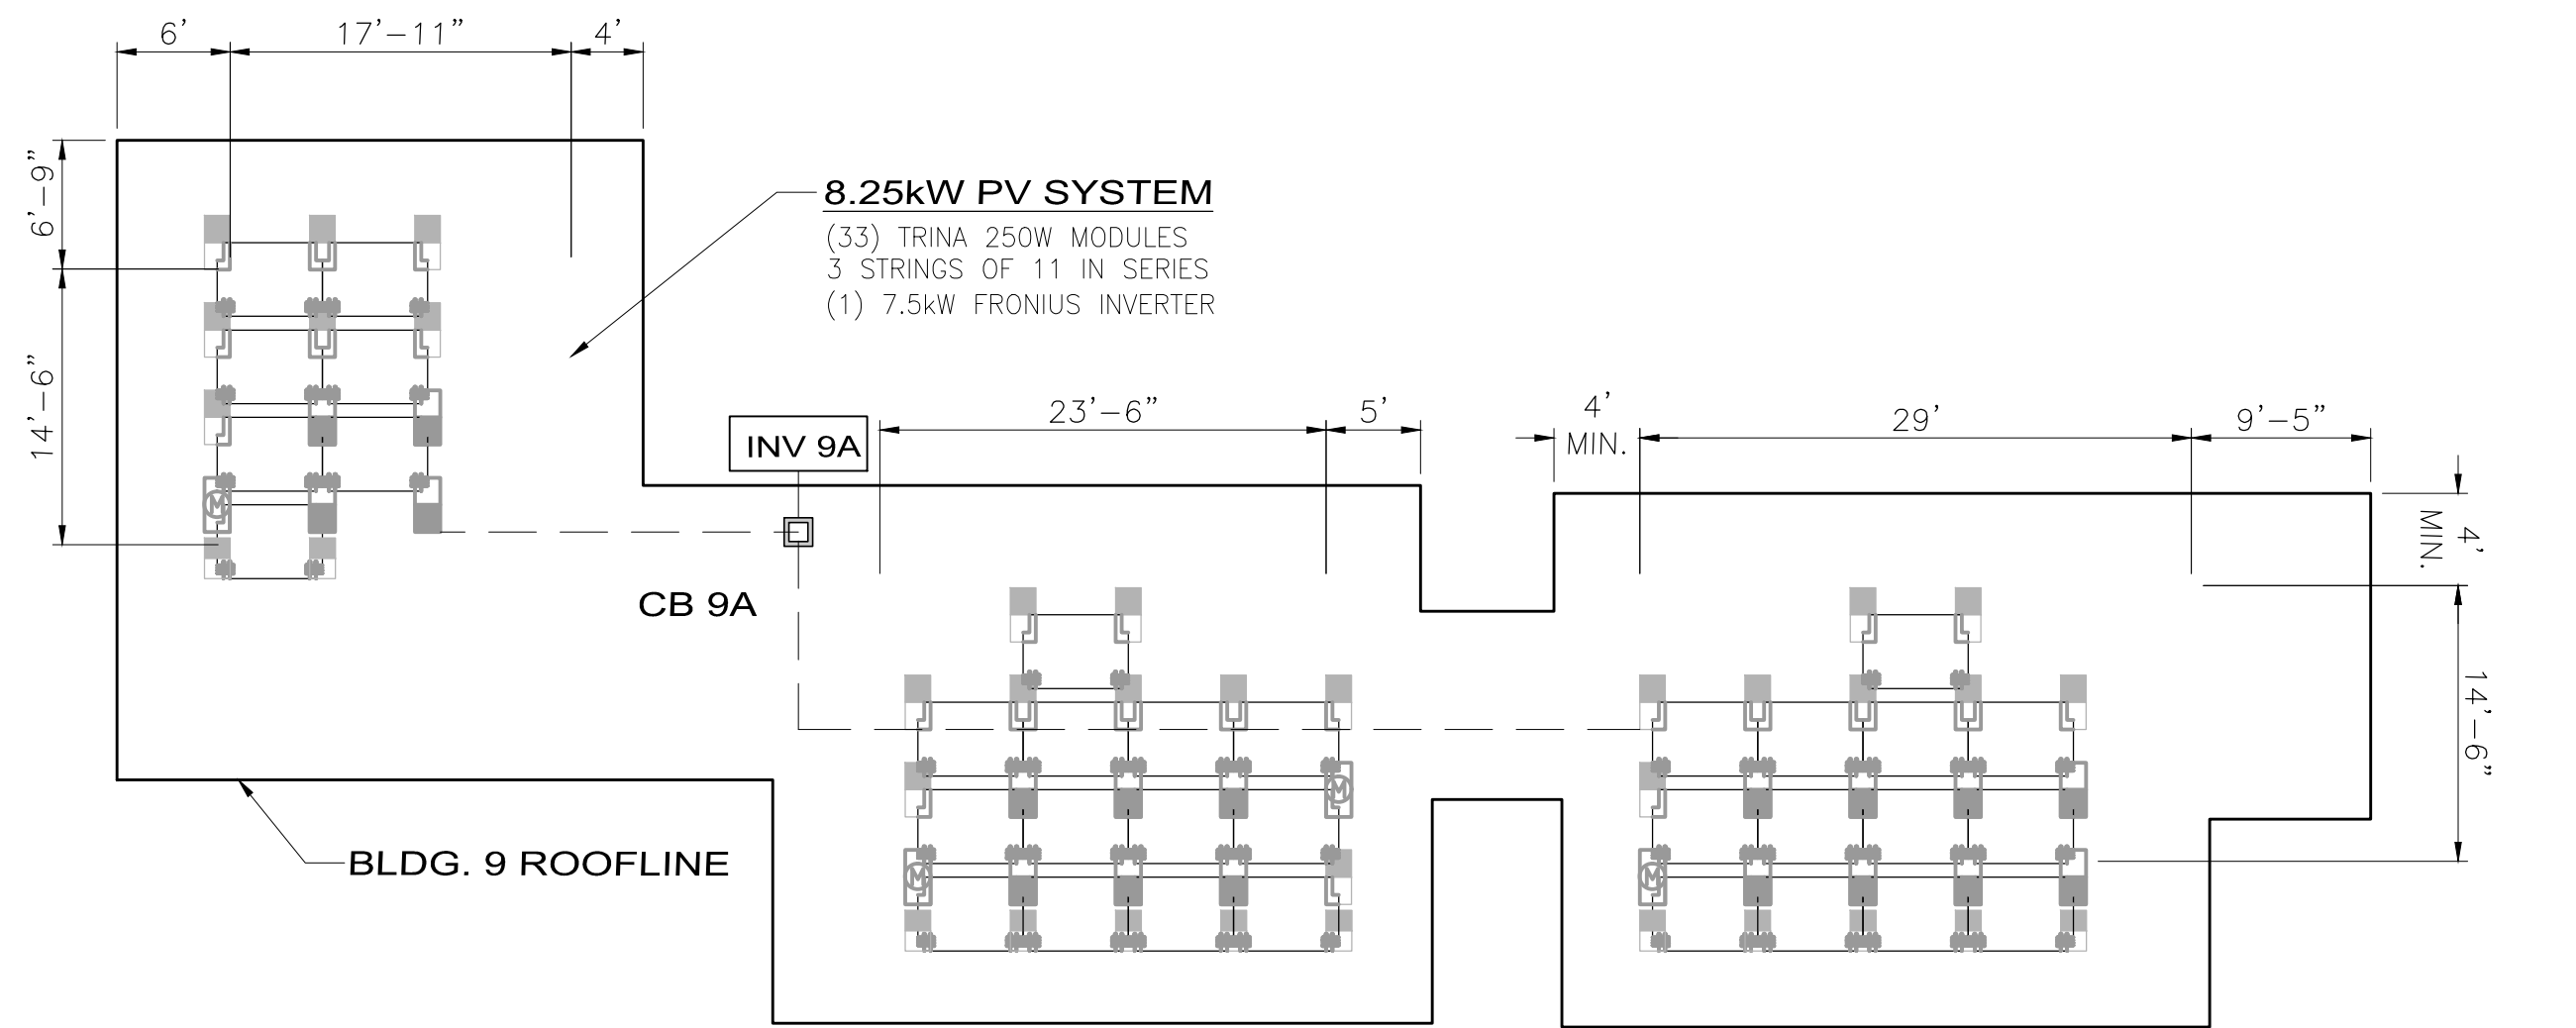


**BUILDING 9**

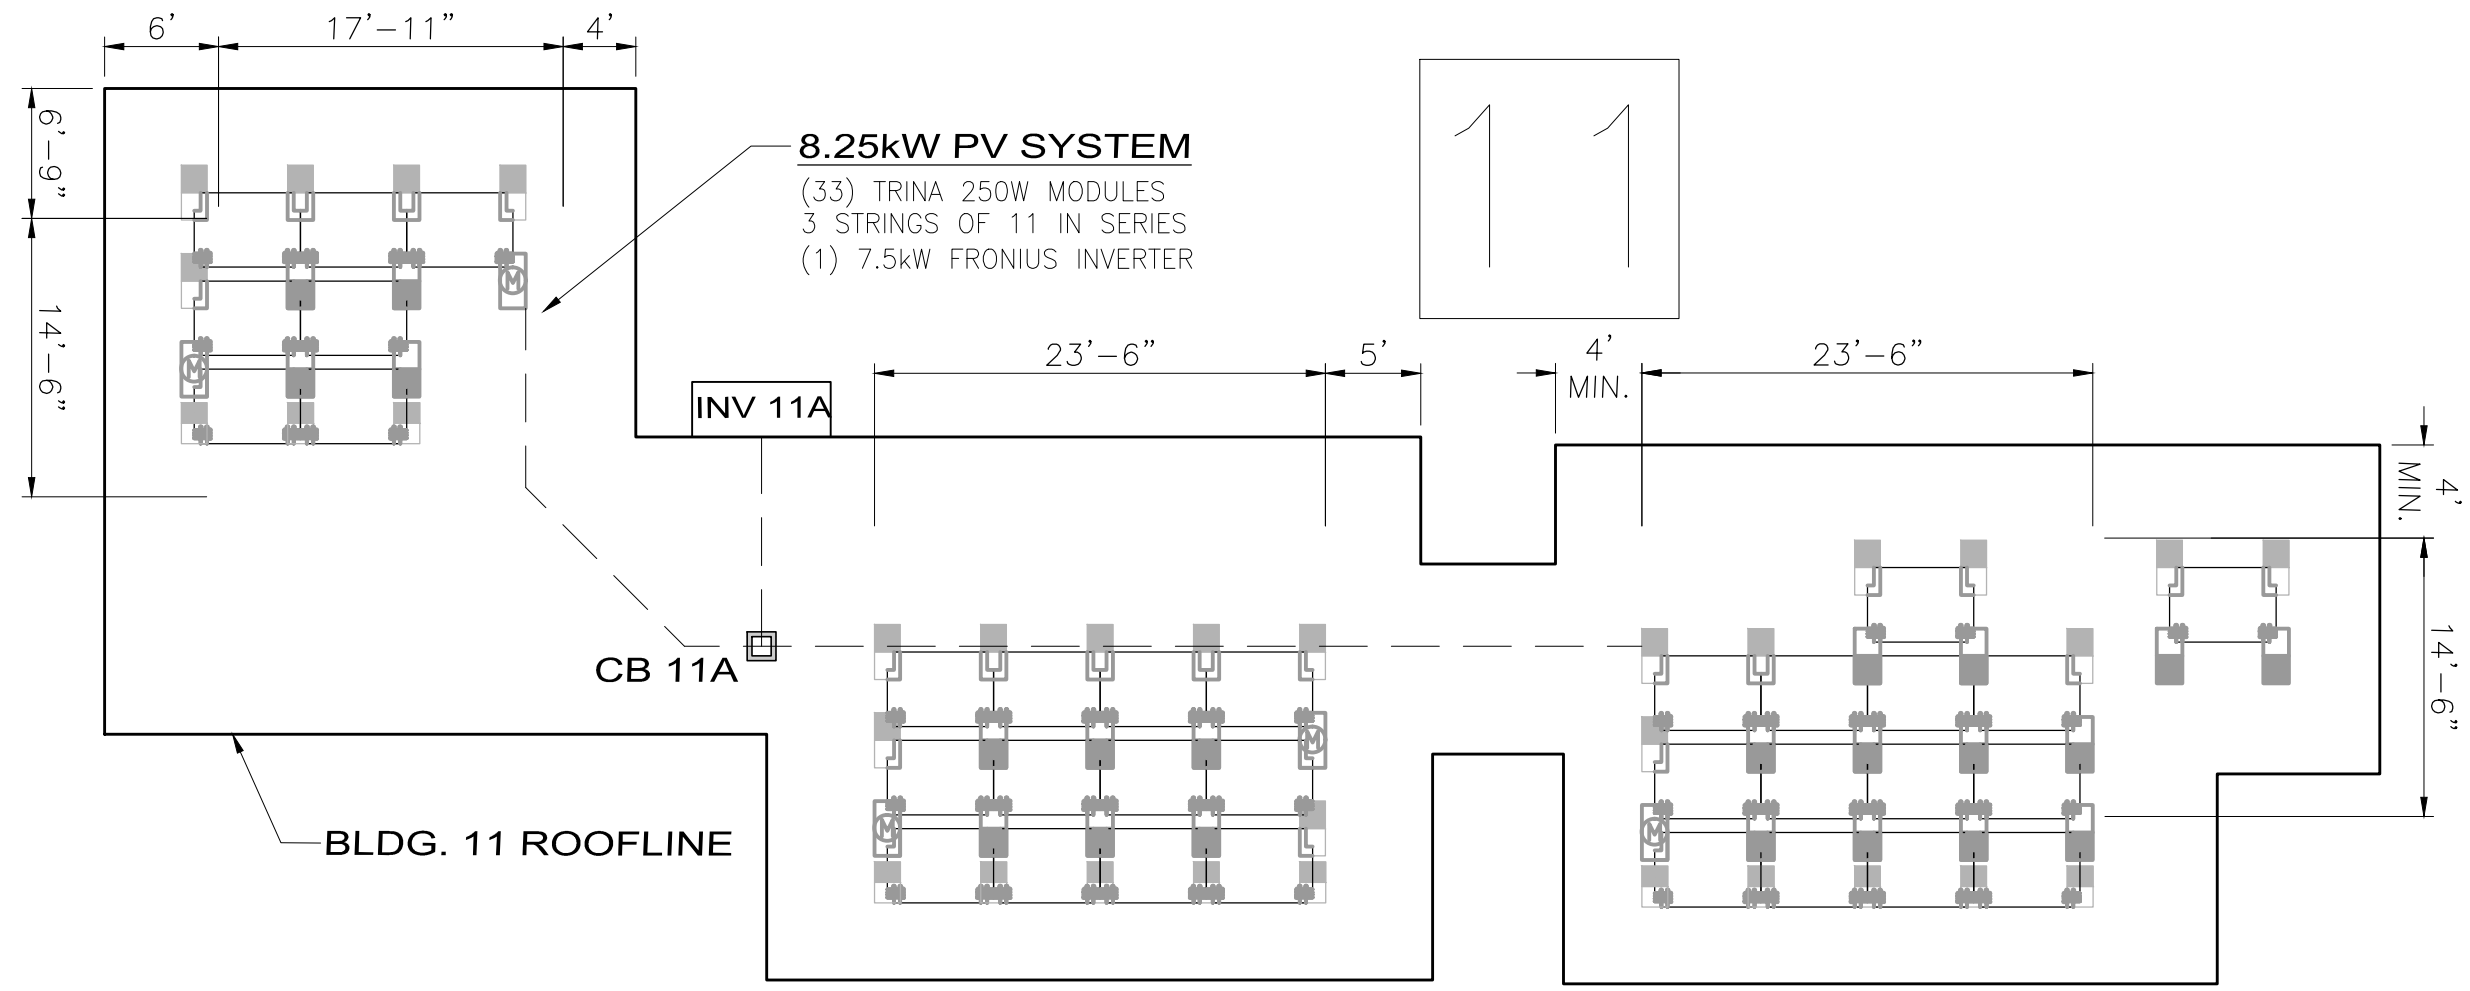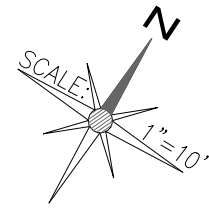

**BUILDING 11**

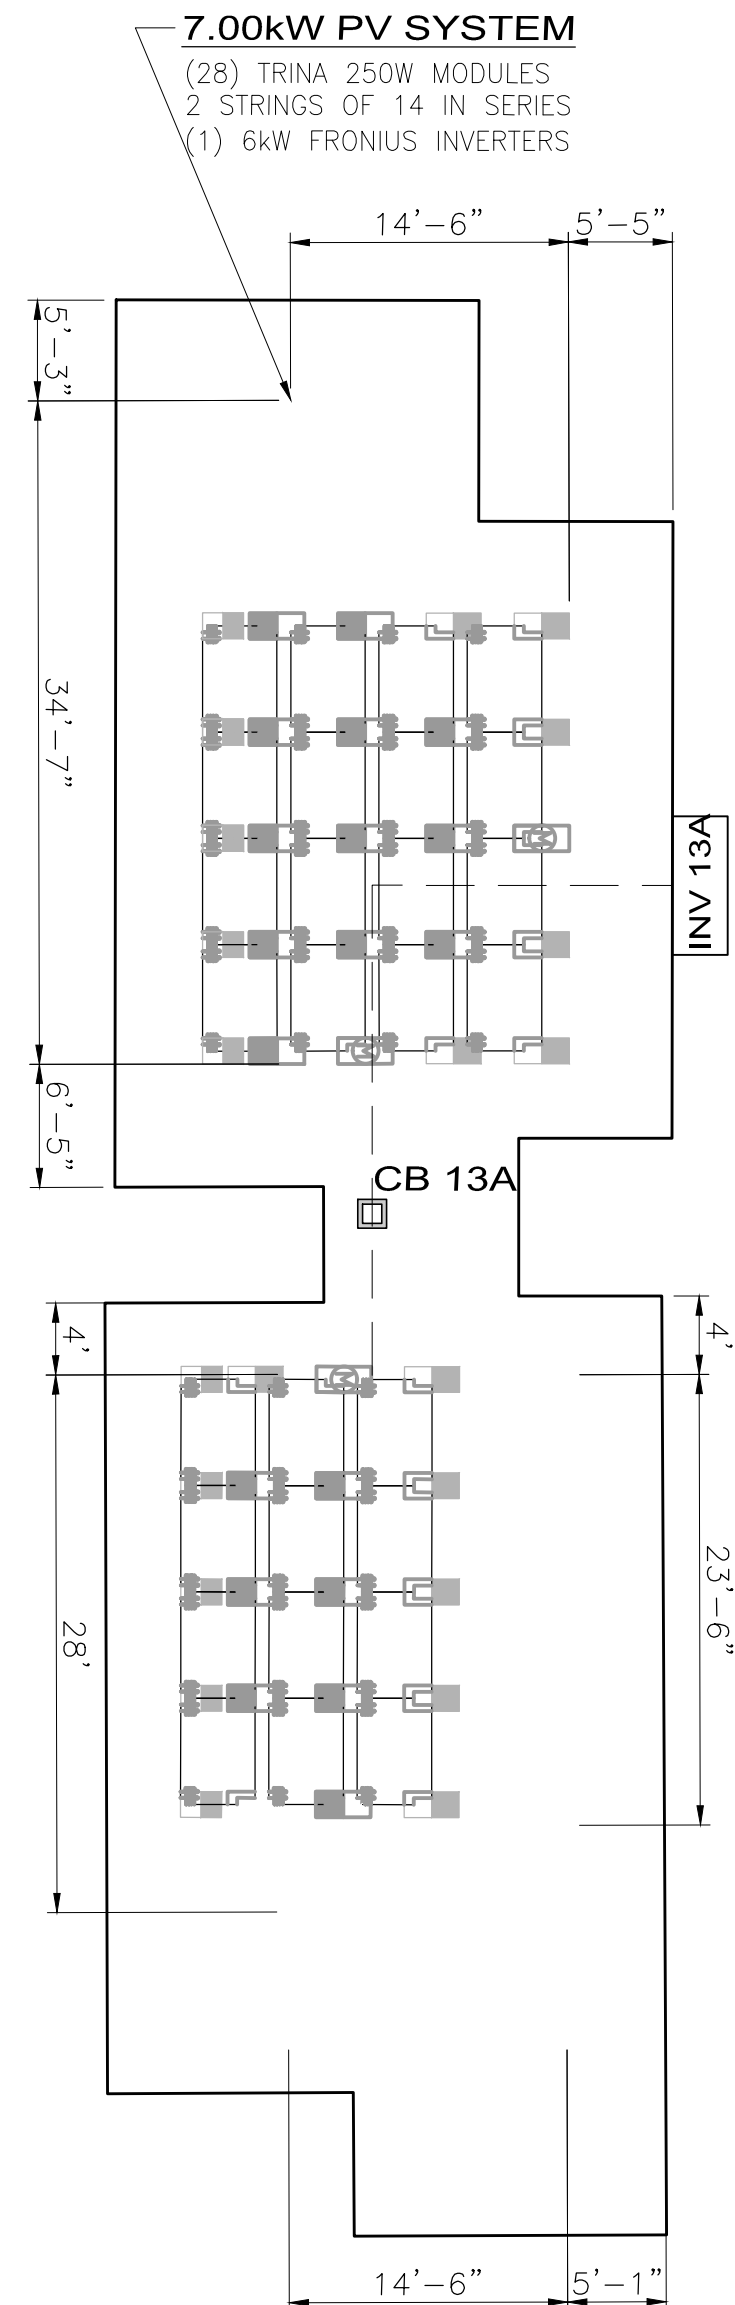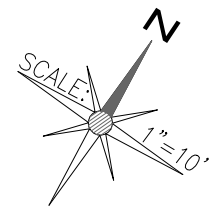

**BUILDING 13**

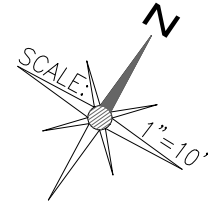

**AERIAL VIEW**  
NOT TO SCALE


**ARRAY MOUNTING NOTES:**

1. THE INSTALLATION CONTRACTOR SHALL ADHERE TO ALL REQUIREMENTS TO MAINTAIN THE ROOF WARRANTY AS SPECIFIED BY CURRENT ROOFING MATERIAL MANUFACTURER. ALL ROOFTOP PENETRATIONS SHALL BE OF AN APPROVED METHOD.
2. WHEN LOADING THE ROOF WITH CONSTRUCTION MATERIALS, THE INSTALLATION CONTRACTOR WILL BE RESPONSIBLE FOR PLACING AN APPROVED MEANS OF PROTECTION BELOW EACH PALLET OF MATERIALS TO PREVENT DAMAGE AND/OR INADVERTENT PENETRATIONS. ANY DAMAGE THAT OCCURS FROM IMPROPERLY PROTECTED MATERIALS WILL BE THE RESPONSIBILITY OF THE INSTALLATION CONTRACTOR TO REPAIR.
3. THE INSTALLATION CONTRACTOR WILL BE RESPONSIBLE FOR FOLLOWING ALL PROVIDED ROOFING LOADING DIAGRAMS. THE CONTRACTOR MUST VERIFY WITH CONSTRUCTION MANAGER FOR ALL LOCATIONS WHERE MATERIALS ARE TO BE STORED.
4. WHEN WORKING ON THE ROOF, CONTRACTOR WILL BE RESPONSIBLE FOR PROVIDING A MEANS OF FALL PROTECTION WHEN WORKING IN AREAS WITHIN 6' OF THE ROOFS EDGES OR A 3' CHANGE IN ELEVATION. THIS FALL PROTECTION EQUIPMENT MUST MEET OR EXCEED THE REQUIREMENTS OF OSHA AND CONSTELLATION AS SPECIFIED IN THEIR FALL PROTECTION REGULATIONS.

**GENERAL NOTES:**

1. THE GENERAL LAYOUT OF ROOFTOP PV EQUIPMENT SHOWN MAY BE SLIGHTLY ADJUSTED TO SUIT EXISTING CONDITIONS.
2. VARIABLE ROOF SLOPES AND EXISTING DRAINAGE AREAS WILL REQUIRE FIELD VERIFICATION OF PANEL CLAW RACKING ROOF PENETRATION LOCATIONS PRIOR TO INSTALLATION OF PHOTOVOLTAIC SYSTEM.
3. EXISTING ROOFTOP AREA WHERE PHOTOVOLTAIC SYSTEM WILL BE INSTALLED IS APPROXIMATELY (64,317) FT<sup>2</sup>.

ENGINEER APPROVAL:

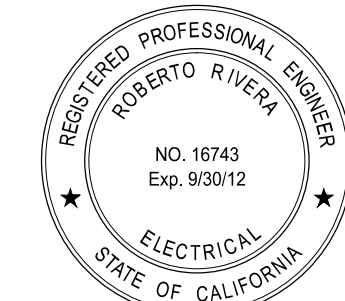

Roberto Rivera  
ROBERTO RIVERA, P.E. NO. 16743  
DATE: 09/10/12

DESCRIPTION: 100% CONSTRUCTION DRAWINGS  
DATE: 9/10/12  
REV: 1

PREPARED BY:



6977 NAVAJO RD., SUITE 139  
SAN DIEGO, CA 92119  
PHONE: 858.270.9333  
FAX: 858.270.9334

THIS DOCUMENT IS CONSIDERED PROTECTED INTELLECTUAL PROPERTY AND CONTAINS PROPRIETARY INFORMATION UNDER US PATENT LAWS. NO PORTION OF THIS DOCUMENT MAY BE REPRODUCED FOR ANY PURPOSE WITHOUT THE WRITTEN PERMISSION OF SUSTINEO CORP.

OWNER/CLIENT:

MADONNA ROAD APARTMENTS  
1550 MADONNA ROAD  
SAN LUIS OBISPO, CA 93405



EVERYDAY ENERGY  
5865 AVENIDA ENCINAS,  
SUITE 142A  
CARLSBAD, CA, 92008  
P: (760) 607-7200

**PV ROOFTOP LAYOUT**

**PHOTOVOLTAIC SYSTEM**

1550 MADONNA ROAD  
SAN LUIS OBISPO, CA 93405

PROJECT NO.: 038 - 108  
APN: 140-040-003  
DATE: SEPTEMBER 10, 2012  
SHEET NO.:





SCALE: 1"=10'




1. THE INSTALLATION CONTRACTOR SHALL ADHERE TO ALL REQUIREMENTS TO MAINTAIN THE ROOF WARRANTY AS SPECIFIED BY CURRENT ROOFING MATERIAL MANUFACTURER. ALL ROOFTOP PENETRATIONS SHALL BE OF AN APPROVED METHOD.
2. WHEN LOADING THE ROOF WITH CONSTRUCTION MATERIALS, THE INSTALLATION CONTRACTOR WILL BE RESPONSIBLE FOR PLACING AN APPROVED MEANS OF PROTECTION BELOW EACH PALLET OF MATERIALS TO PREVENT DAMAGE AND/OR INADVERTENT PENETRATIONS. ANY DAMAGE THAT OCCURS FROM IMPROPERLY PROTECTED MATERIALS WILL BE THE RESPONSIBILITY OF THE INSTALLATION CONTRACTOR TO REPAIR.
3. THE INSTALLATION CONTRACTOR WILL BE RESPONSIBLE FOR FOLLOWING ALL PROVIDED ROOFING LOADING DIAGRAMS. THE CONTRACTOR MUST VERIFY WITH CONSTRUCTION MANAGER FOR ALL LOCATIONS WHERE MATERIALS ARE TO BE STORED.
4. WHEN WORKING ON THE ROOF, CONTRACTOR WILL BE RESPONSIBLE FOR PROVIDING A MEANS OF FALL PROTECTION WHEN WORKING IN AREAS WITHIN 6' OF THE ROOF'S EDGES OR A 3' CHANGE IN ELEVATION. THIS FALL PROTECTION EQUIPMENT MUST MEET OR EXCEED THE REQUIREMENTS OF OSHA AND CONSTELLATION AS SPECIFIED IN THEIR FALL PROTECTION REGULATIONS.

1. THE GENERAL LAYOUT OF ROOFTOP PV EQUIPMENT SHOWN MAY BE SLIGHTLY ADJUSTED TO SUIT EXISTING CONDITIONS.
2. VARIABLE ROOF SLOPES AND EXISTING DRAINAGE AREAS WILL REQUIRE FIELD VERIFICATION OF PANEL CLAW RACKING ROOF PENETRATION LOCATIONS PRIOR TO INSTALLATION OF PHOTOVOLTAIC SYSTEM.
3. EXISTING ROOFTOP AREA WHERE PHOTOVOLTAIC SYSTEM WILL BE INSTALLED IS APPROXIMATELY (64,317) FT<sup>2</sup>.

09/10/12

ROBERTO RIVERA, P.E. NO. 16743


PREPARED BY:

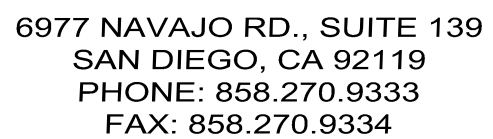

THIS DOCUMENT IS CONSIDERED PROTECTED  
INTELLECTUAL PROPERTY AND CONTAINS PROPRIETARY  
INFORMATION UNDER UNITED STATES LAW. NO PORTION  
OF THIS DOCUMENT MAY BE REPRODUCED FOR ANY  
PURPOSE WITHOUT THE EXPRESS WRITTEN PERMISSION OF  
SUSTINEO CORP.

OWNER/CLIENT:

MADONNA ROAD APARTMENTS  
1550 MADONNA ROAD  
SAN LUIS OBISPO, CA 93405

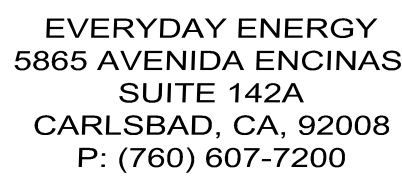

1550 MADONNA ROAD  
SAN LUIS OBISPO, CA 93405

PROJECT NO.:

038 - 108

APN:

140-040-003

DATE \_\_\_\_\_

SEPTEMBER 10, 2012

SHEET NO.


### E3.6

9 OF 3

9 OF 30

## 100% CONSTRUCTION DRAWINGS



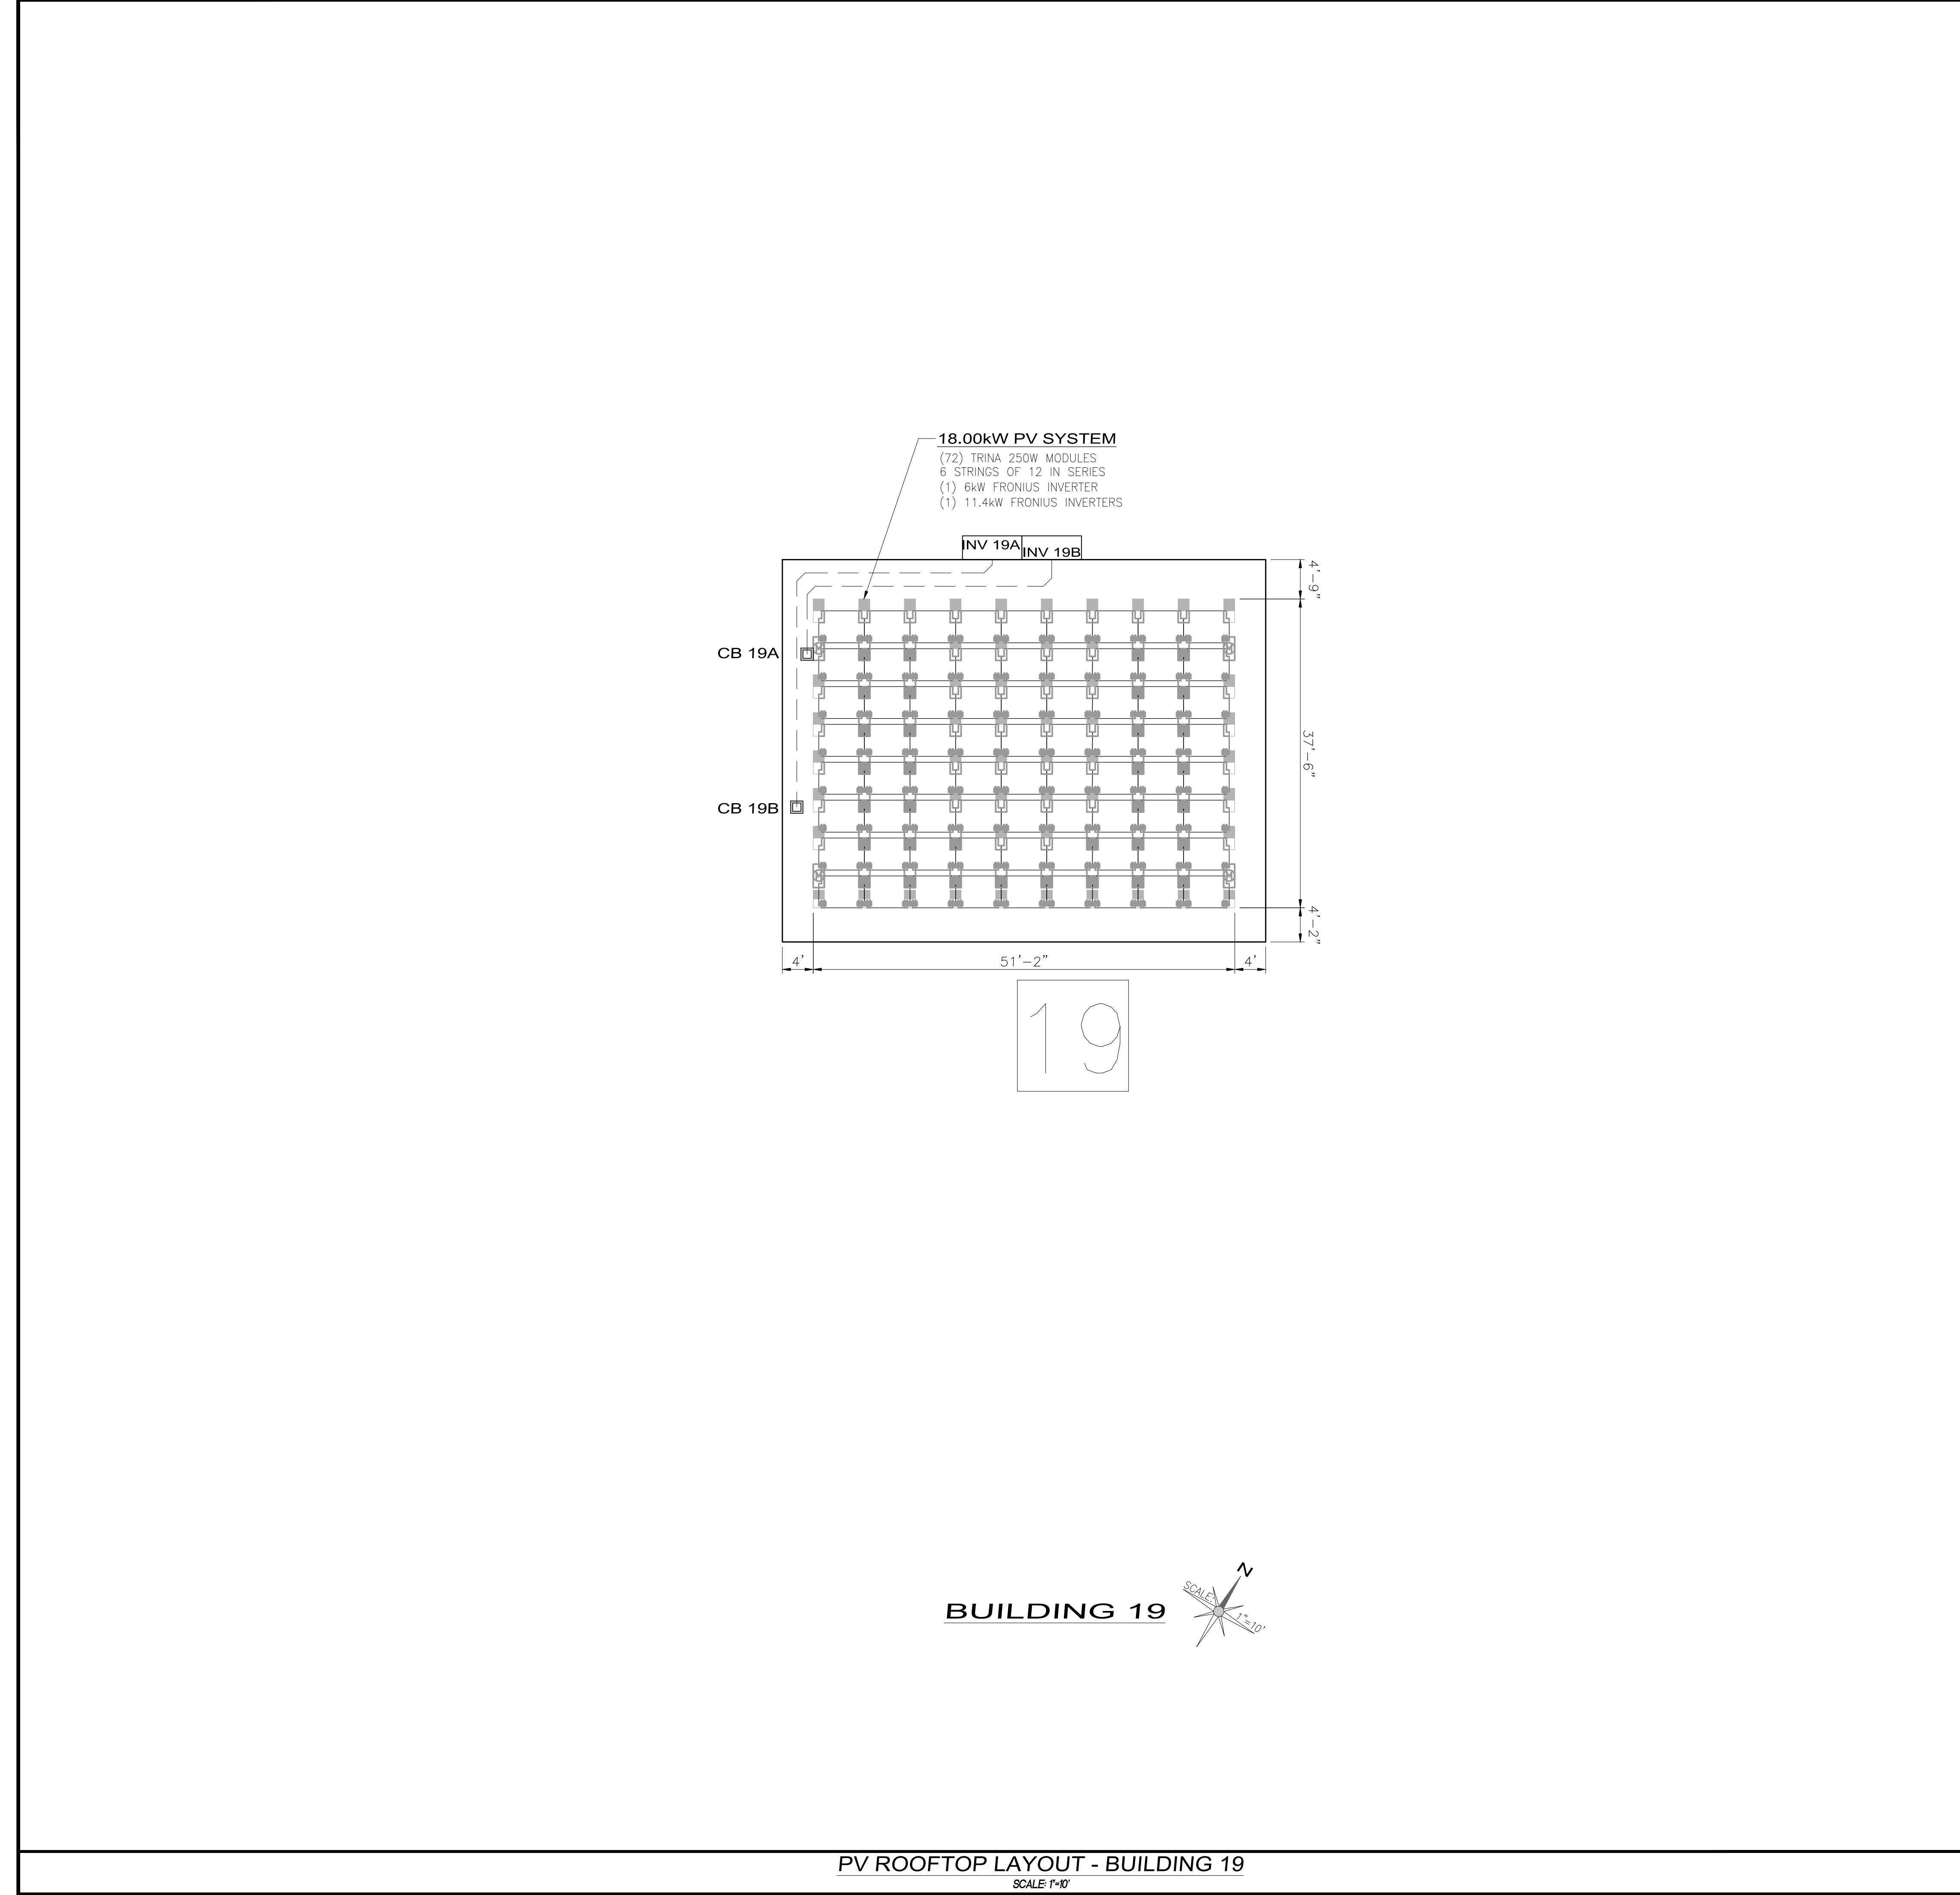

**AERIAL VIEW**  
NOT TO SCALE

**ARRAY MOUNTING NOTES:**

1. THE INSTALLATION CONTRACTOR SHALL ADHERE TO ALL REQUIREMENTS TO MAINTAIN THE ROOF WARRANTY AS SPECIFIED BY CURRENT ROOFING MATERIAL MANUFACTURER. ALL ROOFTOP PENETRATIONS SHALL BE OF AN APPROVED METHOD.
2. WHEN LOADING THE ROOF WITH CONSTRUCTION MATERIALS, THE INSTALLATION CONTRACTOR WILL BE RESPONSIBLE FOR PLACING AN APPROVED MEANS OF PROTECTION BELOW EACH PALLET OF MATERIALS TO PREVENT DAMAGE AND/OR INADVERTENT PENETRATIONS. ANY DAMAGE THAT OCCURS FROM IMPROPERLY PROTECTED MATERIALS WILL BE THE RESPONSIBILITY OF THE INSTALLATION CONTRACTOR TO REPAIR.
3. THE INSTALLATION CONTRACTOR WILL BE RESPONSIBLE FOR FOLLOWING ALL PROVIDED ROOFING LOADING DIAGRAMS. THE CONTRACTOR MUST VERIFY WITH CONSTRUCTION MANAGER FOR ALL LOCATIONS WHERE MATERIALS ARE TO BE STORED.
4. WHEN WORKING ON THE ROOF, CONTRACTOR WILL BE RESPONSIBLE FOR PROVIDING A MEANS OF FALL PROTECTION WHEN WORKING IN AREAS WITHIN 6' OF THE ROOF'S EDGES OR A 3' CHANGE IN ELEVATION. THIS FALL PROTECTION EQUIPMENT MUST MEET OR EXCEED THE REQUIREMENTS OF OSHA AND CONSTELLATION AS SPECIFIED IN THEIR FALL PROTECTION REGULATIONS.

**GENERAL NOTES:**

1. THE GENERAL LAYOUT OF ROOFTOP PV EQUIPMENT SHOWN MAY BE SLIGHTLY ADJUSTED TO SUIT EXISTING CONDITIONS.
2. VARIABLE ROOF SLOPES AND EXISTING DRAINAGE AREAS WILL REQUIRE FIELD VERIFICATION OF PANEL CLAW RACKING ROOF PENETRATION LOCATIONS PRIOR TO INSTALLATION OF PHOTOVOLTAIC SYSTEM.
3. EXISTING ROOFTOP AREA WHERE PHOTOVOLTAIC SYSTEM WILL BE INSTALLED IS APPROXIMATELY (64,317) FT<sup>2</sup>.

ENGINEER APPROVAL:



*Roberto Rivera*  
ROBERTO RIVERA, P.E. NO. 16743

09/10/12

DATE:

DESCRIPTION:  
100% CONSTRUCTION DRAWINGS

DATE:  
9/10/12

REV:  
1

PREPARED BY:



6977 NAVAJO RD., SUITE 139  
SAN DIEGO, CA 92119  
PHONE: 858.270.9333  
FAX: 858.270.9334

THIS DOCUMENT IS CONSIDERED PROTECTED INTELLECTUAL PROPERTY AND CONTAINS PROPRIETARY INFORMATION UNDER US PATENT SYSTEMS LAW. NO PORTION OF PART OF THIS DOCUMENT MAY BE REPRODUCED FOR ANY PURPOSE WITHOUT THE EXPRESS WRITTEN PERMISSION OF SUSTINEO CORP.

OWNER/CLIENT:

MADONNA ROAD APARTMENTS  
1550 MADONNA ROAD  
SAN LUIS OBISPO, CA 93405



EVERYDAY ENERGY  
5865 AVENIDA ENCINAS,  
SUITE 142A  
CARLSBAD, CA, 92008  
P: (760) 607-7200

**PV ROOFTOP LAYOUT**

**PHOTOVOLTAIC SYSTEM**

**1550 MADONNA ROAD  
SAN LUIS OBISPO, CA 93405**

TITLE:

PROJECT LOCATION:

PROJECT NO.:

038 - 108

APN:

140-040-003

DATE:


SEPTEMBER 10, 2012

SHEET NO.:

**E3.7**

10 OF 30



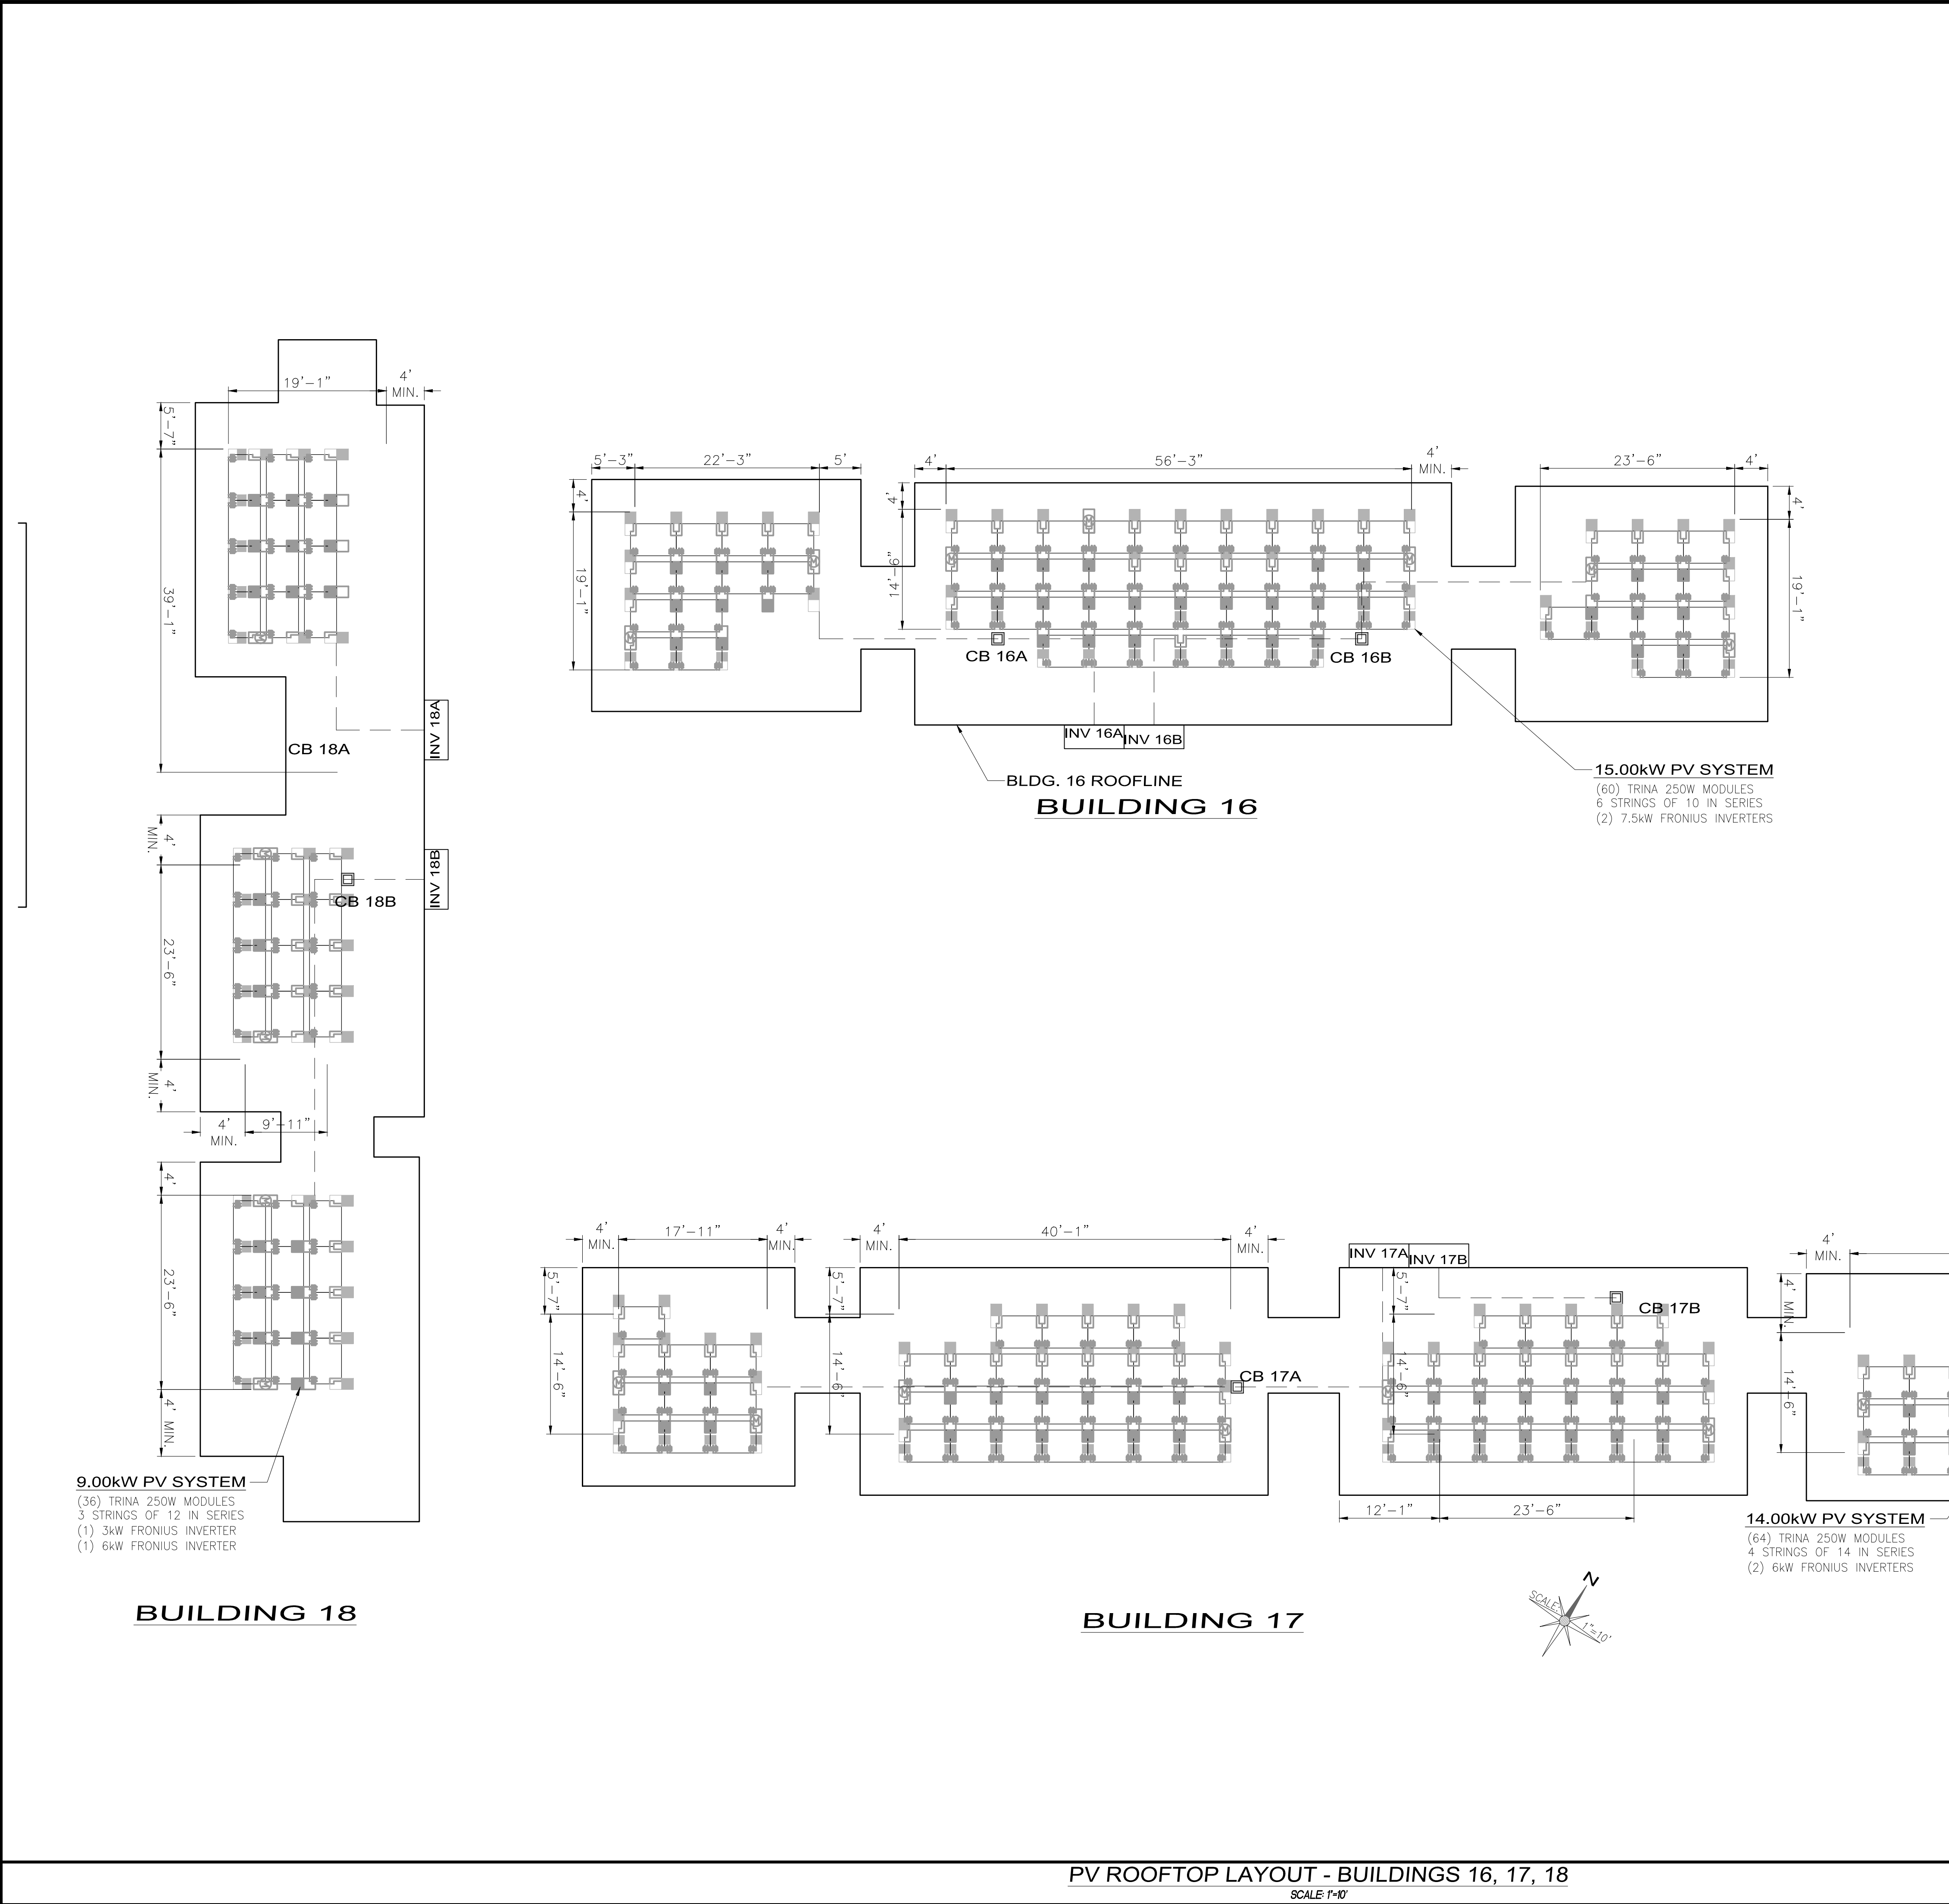

AERIAL VIEW  
NOT TO SCALE

ARRAY MOUNTING NOTES:

1. THE INSTALLATION CONTRACTOR SHALL ADHERE TO ALL REQUIREMENTS TO MAINTAIN THE ROOF WARRANTY AS SPECIFIED BY CURRENT ROOFING MATERIAL MANUFACTURER. ALL ROOFTOP PENETRATIONS SHALL BE OF AN APPROVED METHOD.
2. WHEN LOADING THE ROOF WITH CONSTRUCTION MATERIALS, THE INSTALLATION CONTRACTOR WILL BE RESPONSIBLE FOR PLACING AN APPROVED MEANS OF PROTECTION BELOW EACH PALLET OF MATERIALS TO PREVENT DAMAGE AND/OR INADVERTENT PENETRATIONS. ANY DAMAGE THAT OCCURS FROM IMPROPERLY PROTECTED MATERIALS WILL BE THE RESPONSIBILITY OF THE INSTALLATION CONTRACTOR TO REPAIR.
3. THE INSTALLATION CONTRACTOR WILL BE RESPONSIBLE FOR FOLLOWING ALL PROVIDED ROOFING LOADING DIAGRAMS. THE CONTRACTOR MUST VERIFY WITH CONSTRUCTION MANAGER FOR ALL LOCATIONS WHERE MATERIALS ARE TO BE STORED.
4. WHEN WORKING ON THE ROOF, CONTRACTOR WILL BE RESPONSIBLE FOR PROVIDING A MEANS OF FALL PROTECTION WHEN WORKING IN AREAS WITHIN 6' OF THE ROOF'S EDGES OR A 3' CHANGE IN ELEVATION. THIS FALL PROTECTION EQUIPMENT MUST MEET OR EXCEED THE REQUIREMENTS OF OSHA AND CONSTELLATION AS SPECIFIED IN THEIR FALL PROTECTION REGULATIONS.

GENERAL NOTES:

1. THE GENERAL LAYOUT OF ROOFTOP PV EQUIPMENT SHOWN MAY BE SLIGHTLY ADJUSTED TO SUIT EXISTING CONDITIONS.
2. VARIABLE ROOF SLOPES AND EXISTING DRAINAGE AREAS WILL REQUIRE FIELD VERIFICATION OF PANEL CLAW RACKING ROOF PENETRATION LOCATIONS PRIOR TO INSTALLATION OF PHOTOVOLTAIC SYSTEM.
3. EXISTING ROOFTOP AREA WHERE PHOTOVOLTAIC SYSTEM WILL BE INSTALLED IS APPROXIMATELY (64,317) FT<sup>2</sup>.

ENGINEER APPROVAL:

ROBERTO RIVERA, P.E. NO. 16743

DATE: 09/10/12

|              |                            |
|--------------|----------------------------|
| DESCRIPTION: | 100% CONSTRUCTION DRAWINGS |
| DATE:        | 9/10/12                    |
| REV:         | 1                          |

PREPARED BY:

6977 NAVAJO RD., SUITE 139  
SAN DIEGO, CA 92119  
PHONE: 858.270.9333  
FAX: 858.270.9334

THIS DOCUMENT IS CONSIDERED PROTECTED INTELLECTUAL PROPERTY AND CONTAINS PROPRIETARY INFORMATION UNDER UNITED STATES LAW. NO PORTION OF THIS DOCUMENT MAY BE REPRODUCED FOR ANY PURPOSE WITHOUT THE EXPRESS WRITTEN PERMISSION OF SUSTINEO CORP.

OWNER/CLIENT:

MADONNA ROAD APARTMENTS  
1550 MADONNA ROAD  
SAN LUIS OBISPO, CA 93405

EVERYDAY ENERGY  
5865 AVENIDA ENCINAS,  
SUITE 142A  
CARLSBAD, CA, 92008  
P: (760) 607-7200

TITLE:

PV ROOFTOP LAYOUT  
PHOTOVOLTAIC SYSTEM

PROJECT LOCATION:

1550 MADONNA ROAD  
SAN LUIS OBISPO, CA 93405


PROJECT NO.: 038 - 108

APN: 140-040-003

DATE: SEPTEMBER 10, 2012

SHEET NO.: 11 OF 30



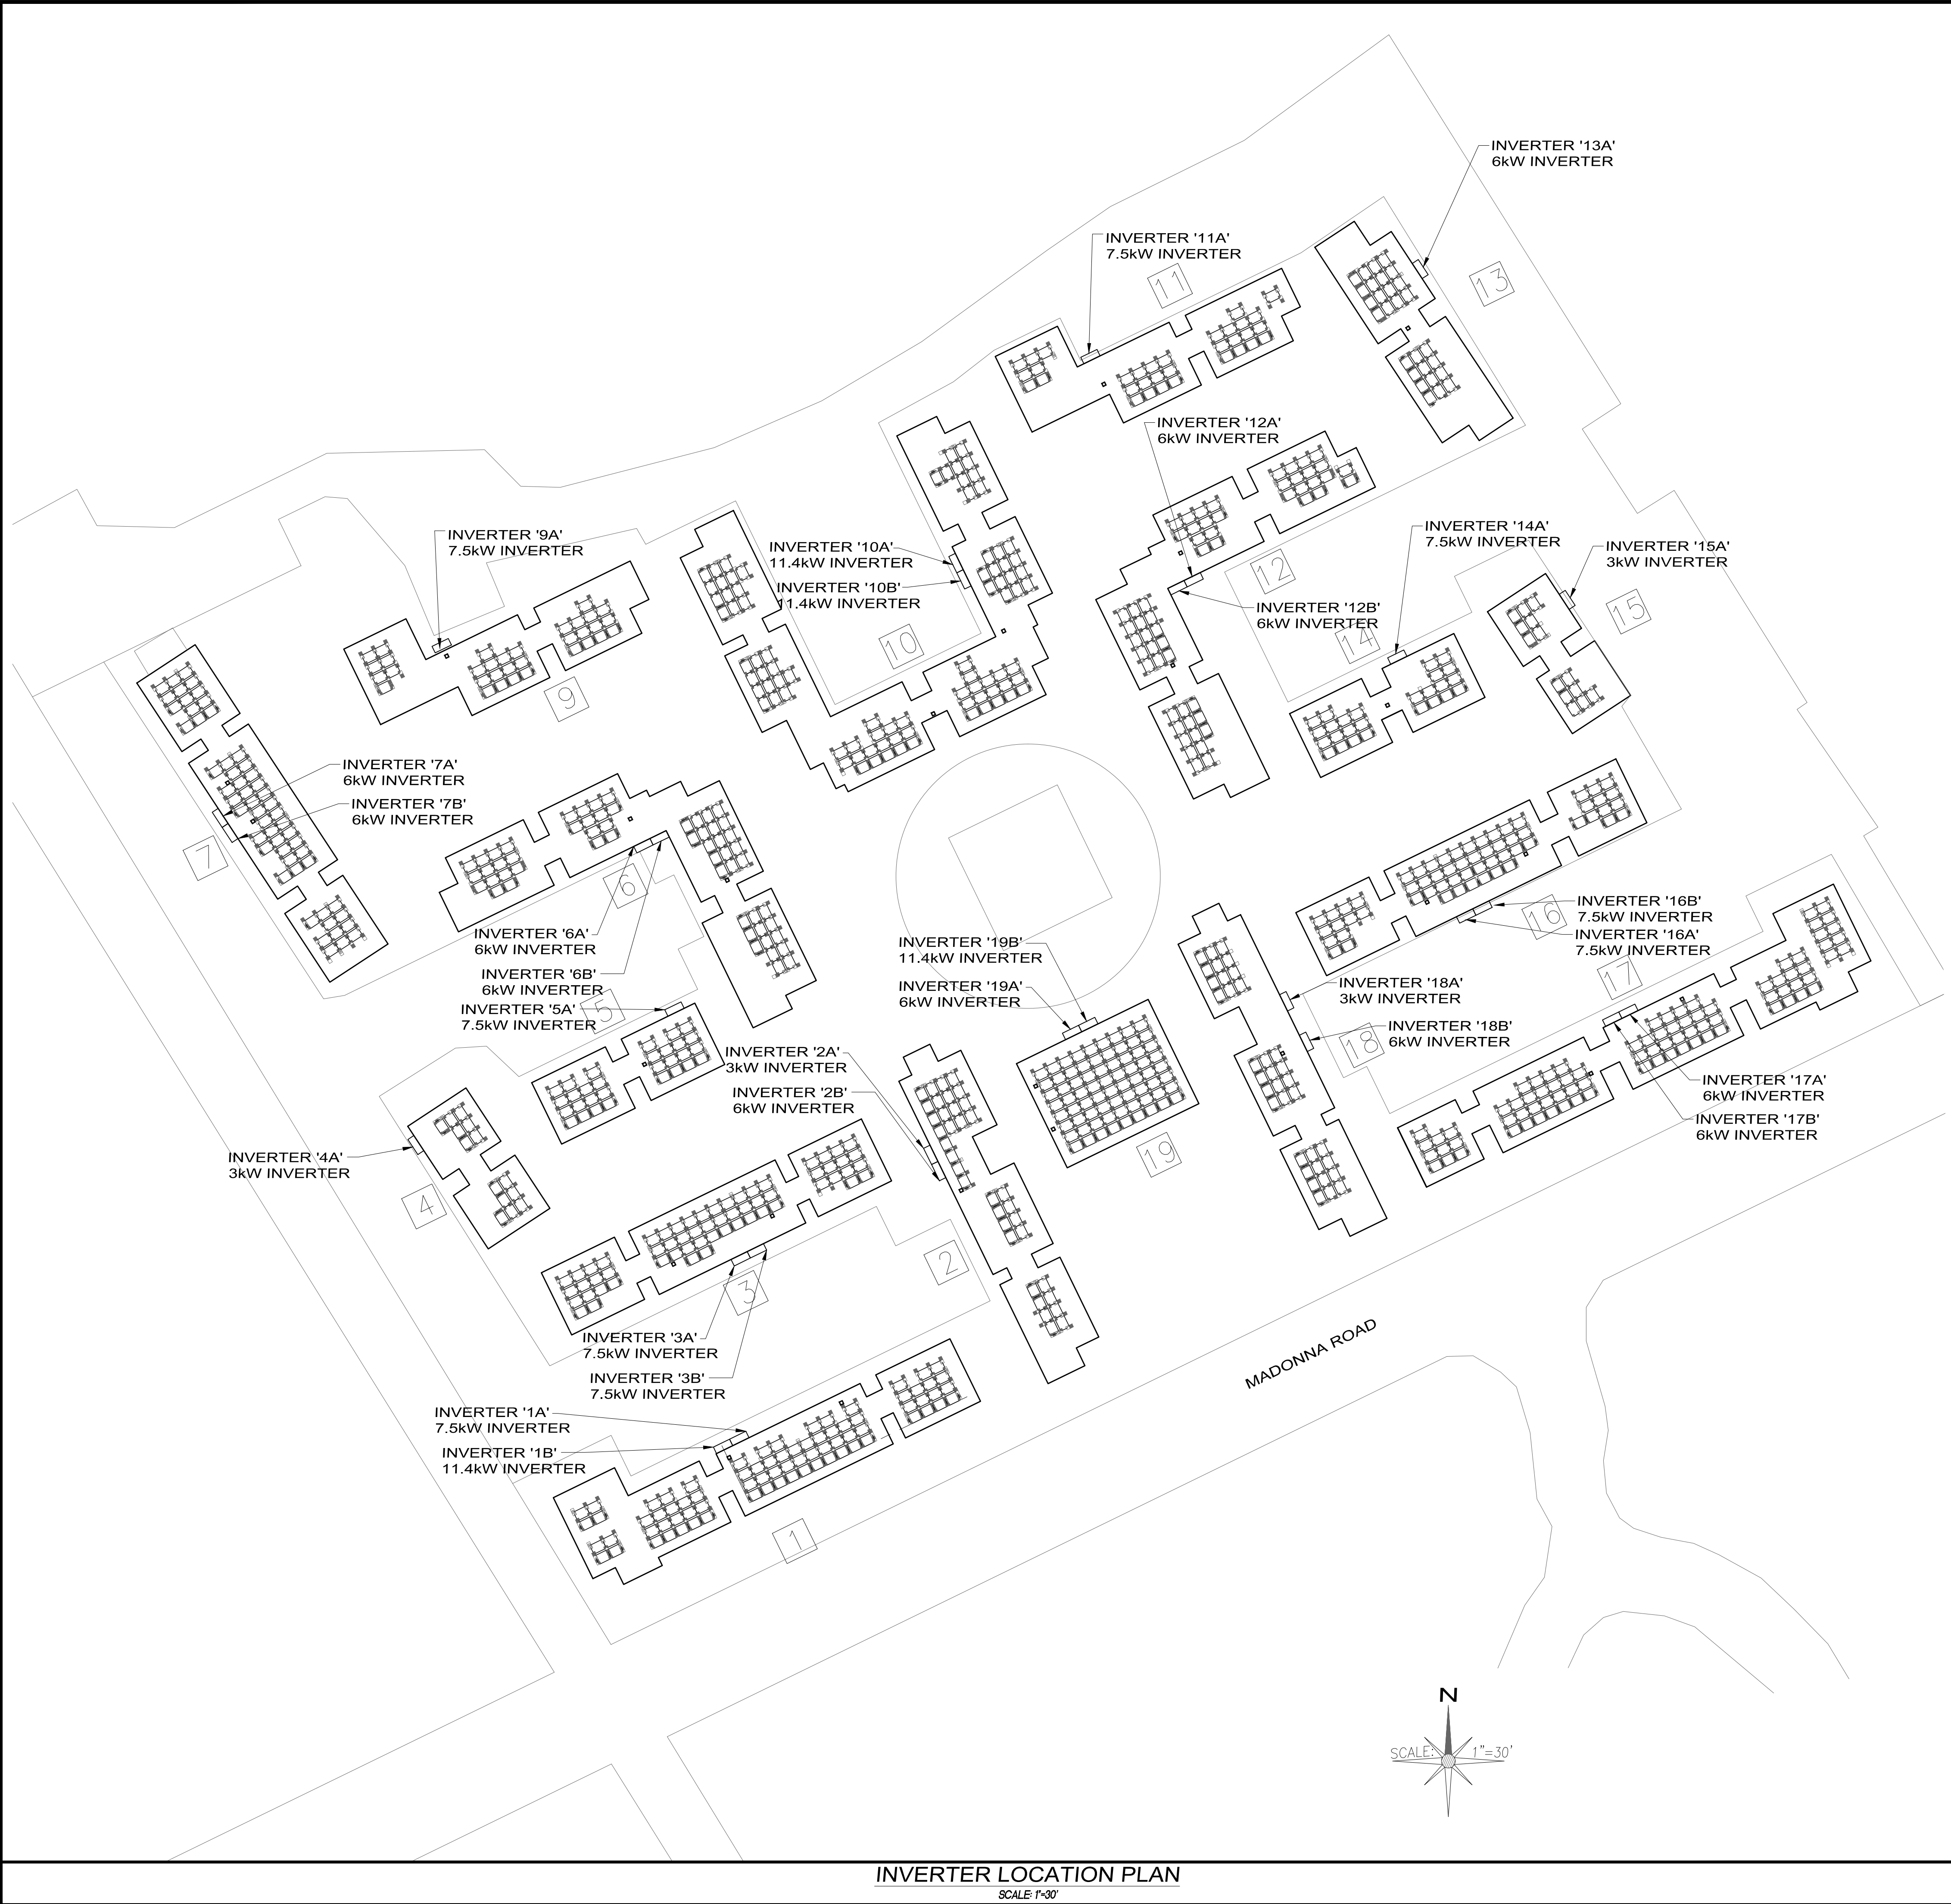

AERIAL VIEW  
NOT TO SCALE

GENERAL NOTES:

1. THE INSTALLATION CONTRACTOR SHALL ADHERE TO ALL REQUIREMENTS TO MAINTAIN EXISTING ACCESS WITH FORKLIFTS AND FACILITY EQUIPMENT. REMOVEABLE BOLLARDS SHALL BE UTILIZED IN LOCATIONS THAT ENCROACH UPON MOTORIZED EQUIPMENT AREAS.
2. THE INSTALLATION CONTRACTOR SHALL VERIFY ALL DIMENSIONS PRIOR TO HOUSE KEEPING PAD AND INVERTER INSTALLATION. PLEASE COORDINATE FINAL INVERTER LOCATIONS WITH FACILITY ENGINEERING MANAGEMENT.
3. THE INSTALLATION CONTRACTOR WILL BE RESPONSIBLE FOR HAVING FINAL INVERTER LOCATIONS APPROVED BY FACILITY PERSONNEL PRIOR TO INSTALLATION.
4. INSTALLATION CONTRACTOR SHALL VERIFY ALL EQUIPMENT ACCESS CLEARANCES PER 2008 NEC.
5. INSTALL AC DISCONNECTING MEANS WITHIN 25' OF POCC.

ENGINEER APPROVAL:  
  
ROBERTO RIVERA, P.E. NO. 16743  
DATE: 09/10/12

|              |                            |
|--------------|----------------------------|
| DESCRIPTION: | 100% CONSTRUCTION DRAWINGS |
| DATE:        | 9/10/12                    |
| REV:         | 1                          |

PREPARED BY:  
  
6977 NAVAJO RD., SUITE 139  
SAN DIEGO, CA 92119  
PHONE: 858.270.9333  
FAX: 858.270.9334

THIS DOCUMENT IS CONSIDERED PROTECTED INTELLECTUAL PROPERTY AND CONTAINS PROPRIETARY INFORMATION UNDER UNITED STATES LAW. NO PORTION OF THIS DOCUMENT MAY BE REPRODUCED FOR ANY PURPOSE WITHOUT THE EXPRESS WRITTEN PERMISSION OF SUSTINEO CORP.

OWNER/CLIENT:  
MADONNA ROAD APARTMENTS  
1550 MADONNA ROAD  
SAN LUIS OBISPO, CA 93405

EVERYDAY ENERGY  
5865 AVENIDA ENCINAS,  
SUITE 142A  
CARLSBAD, CA, 92008  
P: (760) 607-7200

TITLE:  
INVERTER LOCATION PLAN  
PHOTOVOLTAIC SYSTEM

PROJECT LOCATION:  
1550 MADONNA ROAD  
SAN LUIS OBISPO, CA 93405

PROJECT NO.: 038 - 108  
APN: 140-040-003  
DATE: SEPTEMBER 10, 2012  
SHEET NO.:  
**E3.9**  
12 OF 30

100% CONSTRUCTION DRAWINGS



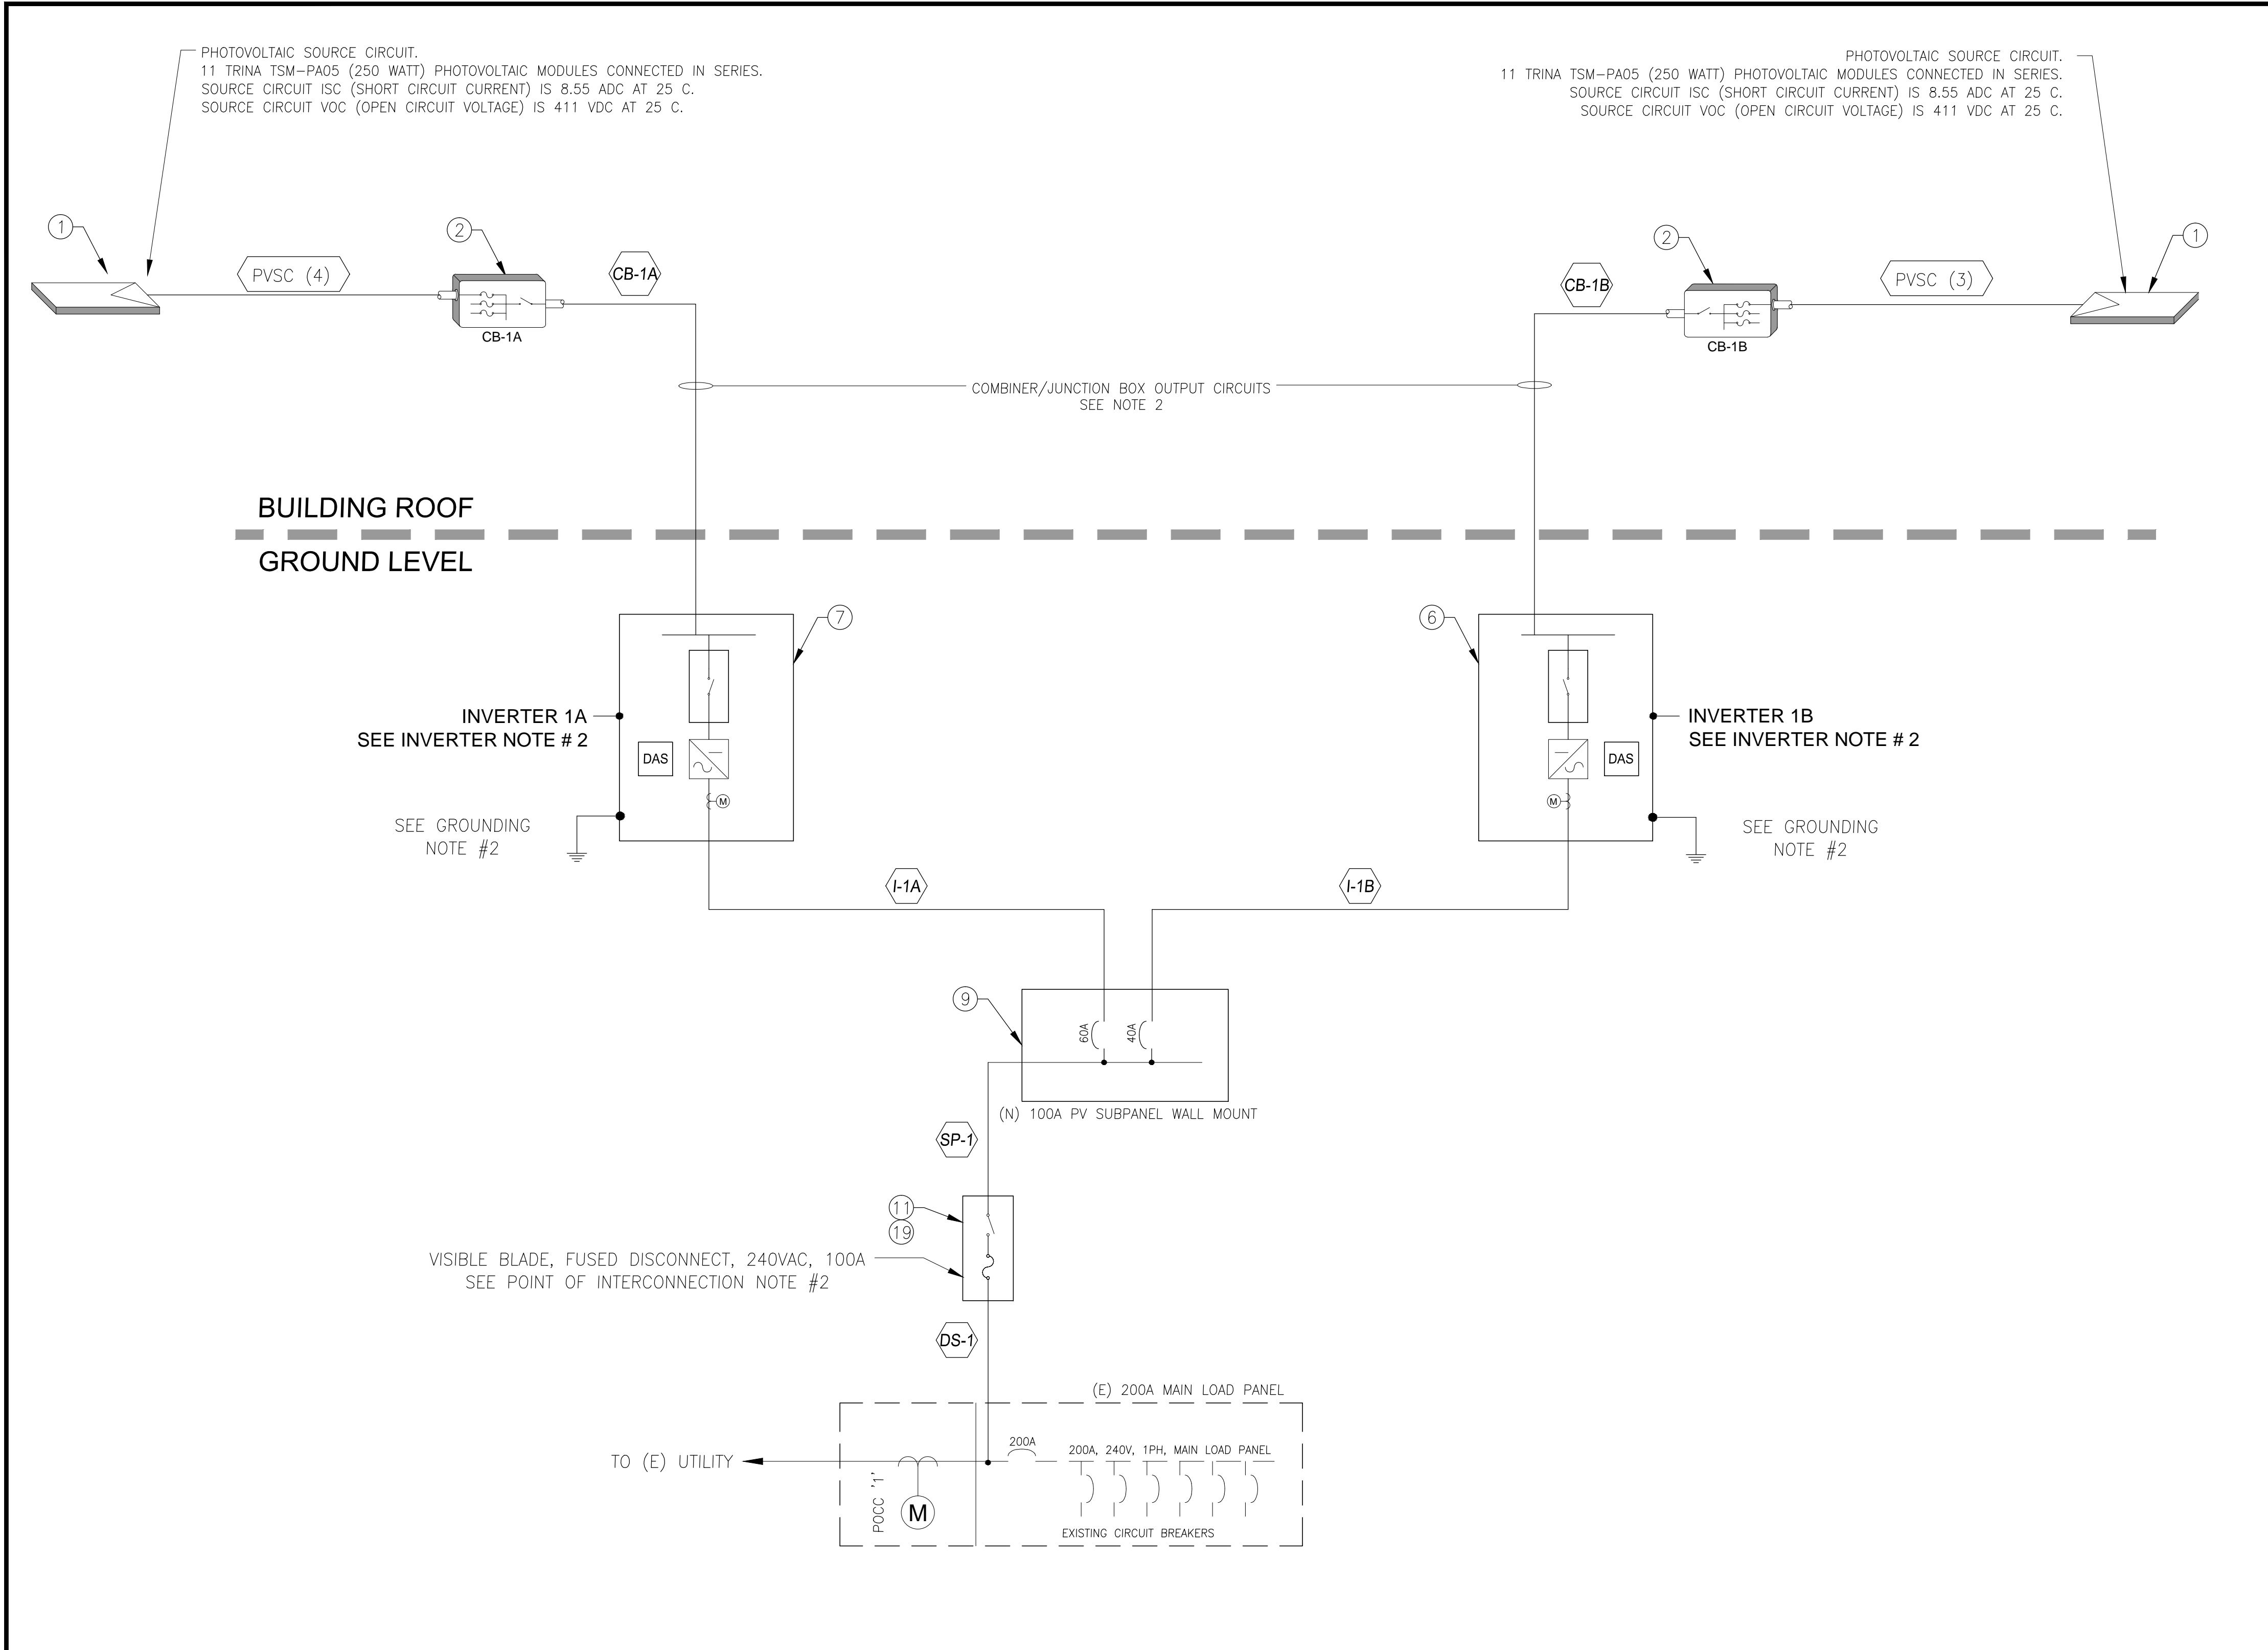


TABLE 1A - DC CIRCUIT SCHEDULE

| CURRENT CARRYING CONDUCTOR |      |     |          |      |             |        | GROUNDING |                     |      | OCPD   |      | CONDUIT/RACEWAY |       |
|----------------------------|------|-----|----------|------|-------------|--------|-----------|---------------------|------|--------|------|-----------------|-------|
| CIRCUIT #                  | TYPE | QTY | DISTANCE | SIZE | INSULATION  | V DROP | SIZE      | INSULATION          | TYPE | RATING | TYPE | SIZE /TYPE      | %FILL |
| Source                     | PVSC | 1   | 100      | 10   | RHW/USE-2   | 0.64%  | #10       | BARE                | EGC  | 15     | Fuse | BACK OF MODULE  |       |
| CB-1A                      | CBOC | 1   | 35       | 6    | THWN/THHN-2 | 0.35%  | #10       | THWN/THHN-2 (GREEN) | -    | -      | Fuse | 1" EMT          | 40    |
| CB-1B                      | CBOC | 1   | 77       | 6    | THWN/THHN-2 | 0.58%  | #10       | THWN/THHN-2 (GREEN) | -    | -      | Fuse | 1" EMT          | 40    |

TABLE 2A - AC CIRCUIT SCHEDULE

| CURRENT CARRYING CONDUCTOR |      |     |          |      |             |        | GROUNDING |             |      | OCPD   |      | CONDUIT/RACEWAY |       |
|----------------------------|------|-----|----------|------|-------------|--------|-----------|-------------|------|--------|------|-----------------|-------|
| CIRCUIT #                  | TYPE | QTY | DISTANCE | SIZE | INSULATION  | V DROP | SIZE      | INSULATION  | TYPE | RATING | TYPE | SIZE /TYPE      | %FILL |
| I-1A                       | IOC  | 3   | 10       | 6    | THWN/THHN-2 | 0.16%  | 8         | THWN/THHN-2 | EGC  | 60     | CB   | 1" EMT          | 40    |
| I-1B                       | IOC  | 3   | 10       | 8    | THWN/THHN-2 | 0.19%  | 8         | THWN/THHN-2 | EGC  | 40     | CB   | 1" EMT          | 40    |
| SP-1                       | IOC  | 3   | 25       | 3    | THWN/THHN-2 | 0.35%  | 8         | THWN/THHN-2 | EGC  | 100    | CB   | 1-1/2" EMT      | 40    |
| DS-1                       | IOC  | 3   | 25       | 3    | THWN/THHN-2 | 0.35%  | 8         | THWN/THHN-2 | EGC  | 100    | CB   | 1-1/2" EMT      | 40    |

SINGLE LINE DIAGRAM NOTES:

- ALL EQUIPMENT INSTALLED SHALL BE IN ACCORDANCE WITH ALL LOCAL AND ELECTRICAL BUILDING CODES. THE INSTALLATION SHALL CONFORM TO ALL LOCAL AND STATE SEISMIC REGULATIONS.
- THE DC GROUNDING ELECTRODE CONDUCTOR SHALL BE BONDED WITH THE AC GROUNDING ELECTRODE.
- COMBINER BOXES SHALL BE NEMA-4 ENCLOSURES OR BETTER.
- ALL PV SOURCE CIRCUIT WIRES SHALL BE RHW/USE-2 SUNLIGHT RESISTANT OR XHHW-2.
- #10-AWG BARE COPPER GROUND SHALL BE USED AS AN EQUIPMENT GROUND TO BOND THE MOUNTING SYSTEM TO THE OTHER PV SYSTEM EQUIPMENT AND TERMINATE IN THE COMBINER BOX. COMBINER BOX EQUIPMENT GROUND SHALL BE RUN IN SERIES AND TERMINATED IN THE INVERTER(S).

GROUNDING NOTES:

- ALL BARE COPPER GROUND WIRING RUNNING BETWEEN ARRAYS SHALL BE PROTECTED FROM INADVERTENT DAMAGE BY BEING ROUTED INSIDE ACCEPTABLE CONDUIT OR WIREWAY. ALL CONDUITS OR WIREWAYS MUST BE NEATLY INSTALLED AND ATTACHED SECURELY TO THE MOUNTING SYSTEM.
- THE GROUNDING ELECTRODE CONDUCTOR (GEC) ON THE AC SIDE OF THE SYSTEM SHALL BE TIED TO A CODE COMPLIANT GROUND ROD NEXT TO THE INVERTER OR AN EXISTING GEC POINT AT THE POC.

GENERAL EQUIPMENT NOTES:

- CIRCLE CALL-OUTS INDICATE BILL OF MATERIALS ITEM NUMBER AND IDENTIFY THE EQUIPMENT USED:
  - ② INDICATES ITEM 2, COMBINER BOX
  - ③ INDICATES ITEM 3, JUNCTION BOX
  - ④ THRU ⑧ INDICATES ITEMS 4-8, INVERTER
  - PVSC (3) INDICATES CIRCUIT TYPE AND NUMBER OF STRINGS
- COMBINER/JUNCTION BOX OUTPUT CIRCUITS: EQUAL NUMBER OF CONDUCTORS FOR POSITIVE AND NEGATIVE COMBINER TERMINALS (1) 10-AWG GREEN EQUIPMENT GROUNDING CONDUCTOR (EGC) REFER TO TABLE 1A FOR OUTPUT CONDUCTOR AND CONDUIT SIZING
- ALL CONDUCTORS ARE COPPER.
- ALL ENCLOSURES ARE NEMA-4 UNLESS OTHERWISE NOTED.
- EQUIPMENT SHALL BE INSTALLED IN ACCORDANCE WITH THE NEC AND ALL APPLICABLE REQUIREMENTS OF THE SERVING ELECTRICAL UTILITY COMPANY AND OF THE LOCAL AUTHORITY HAVING JURISDICTION.
- COMBINER/JUNCTION BOXES ARE IDENTIFIED BY INVERTER DESIGNATION:  
INVERTER 1A: CB-1A  
INVERTER 1B: CB-1B
- WHEN TRANSITIONING FROM RHW/USE-2 IN THE PV SOURCE CIRCUIT TO THHN/THWN-2, CONTRACTOR SHALL UTILIZE WATERTIGHT (NEMA-3R) JUNCTION BOX AND POLARIS CONNECTOR.

INVERTER NOTES:

- INSTALLATION CONTRACTOR SHALL INSTALL COMBINER BOX OUTPUT CIRCUIT ON THE "COMBINED" INPUT CIRCUIT OF THE INVERTER. CONSULT INVERTER MANUAL FOR PROPER INSTALLATION OF REQUIRED CONNECTING DISTRIBUTORS.
- INVERTERS ARE IDENTIFIED BY UNIT NUMBER AND LETTER. FOR UNIT 1  
INVERTER DESIGNATIONS ARE: INV 1A AND 1B

POINT OF INTERCONNECTION NOTES:

- CONNECT FUSED DISCONNECT TO BUS BAR ON LINE SIDE OF SERVICE PANEL. THIS IS A LINE SIDE TAP.
- ATTACH PLACARDS PER APPLICABLE PLACARD SHEET INSTRUCTIONS.

ENGINEER APPROVAL:



ROBERTO RIVERA, P.E. NO. 16743 DATE: 09/10/12

| REV | DATE    | DESCRIPTION                |
|-----|---------|----------------------------|
| 1   | 9/10/12 | 100% CONSTRUCTION DRAWINGS |

PREPARED BY:



6977 NAVAJO RD., SUITE 139  
SAN DIEGO, CA 92119  
PHONE: 858.270.9333  
FAX: 858.270.9334

THIS DOCUMENT IS CONSIDERED PROTECTED  
INTELLECTUAL PROPERTY AND CONTAINS PROPRIETARY  
INFORMATION UNDER UNITED STATES LAW. NO PORTION OR  
PART OF THIS DOCUMENT MAY BE REPRODUCED FOR ANY  
PURPOSE WITHOUT THE EXPLICIT WRITTEN PERMISSION OF  
SUSTINEO CORP.

OWNER/CLIENT:

MADONNA ROAD APARTMENTS  
1550 MADONNA ROAD  
SAN LUIS OBISPO, CA 93405



EVERYDAY ENERGY  
5865 AVENIDA ENCINAS,  
SUITE 142A  
CARLSBAD, CA, 92008  
P: (760) 607-7200

SINGLE LINE DIAGRAM - UNIT 1

PHOTOVOLTAIC SYSTEM

1550 MADONNA ROAD  
SAN LUIS OBISPO, CA 93405

TITLE:

PROJECT NO.:

038 - 108

APN:

140-040-003

DATE:


SEPTEMBER 10, 2012

SHEET NO.:

E4.1

13 OF 30



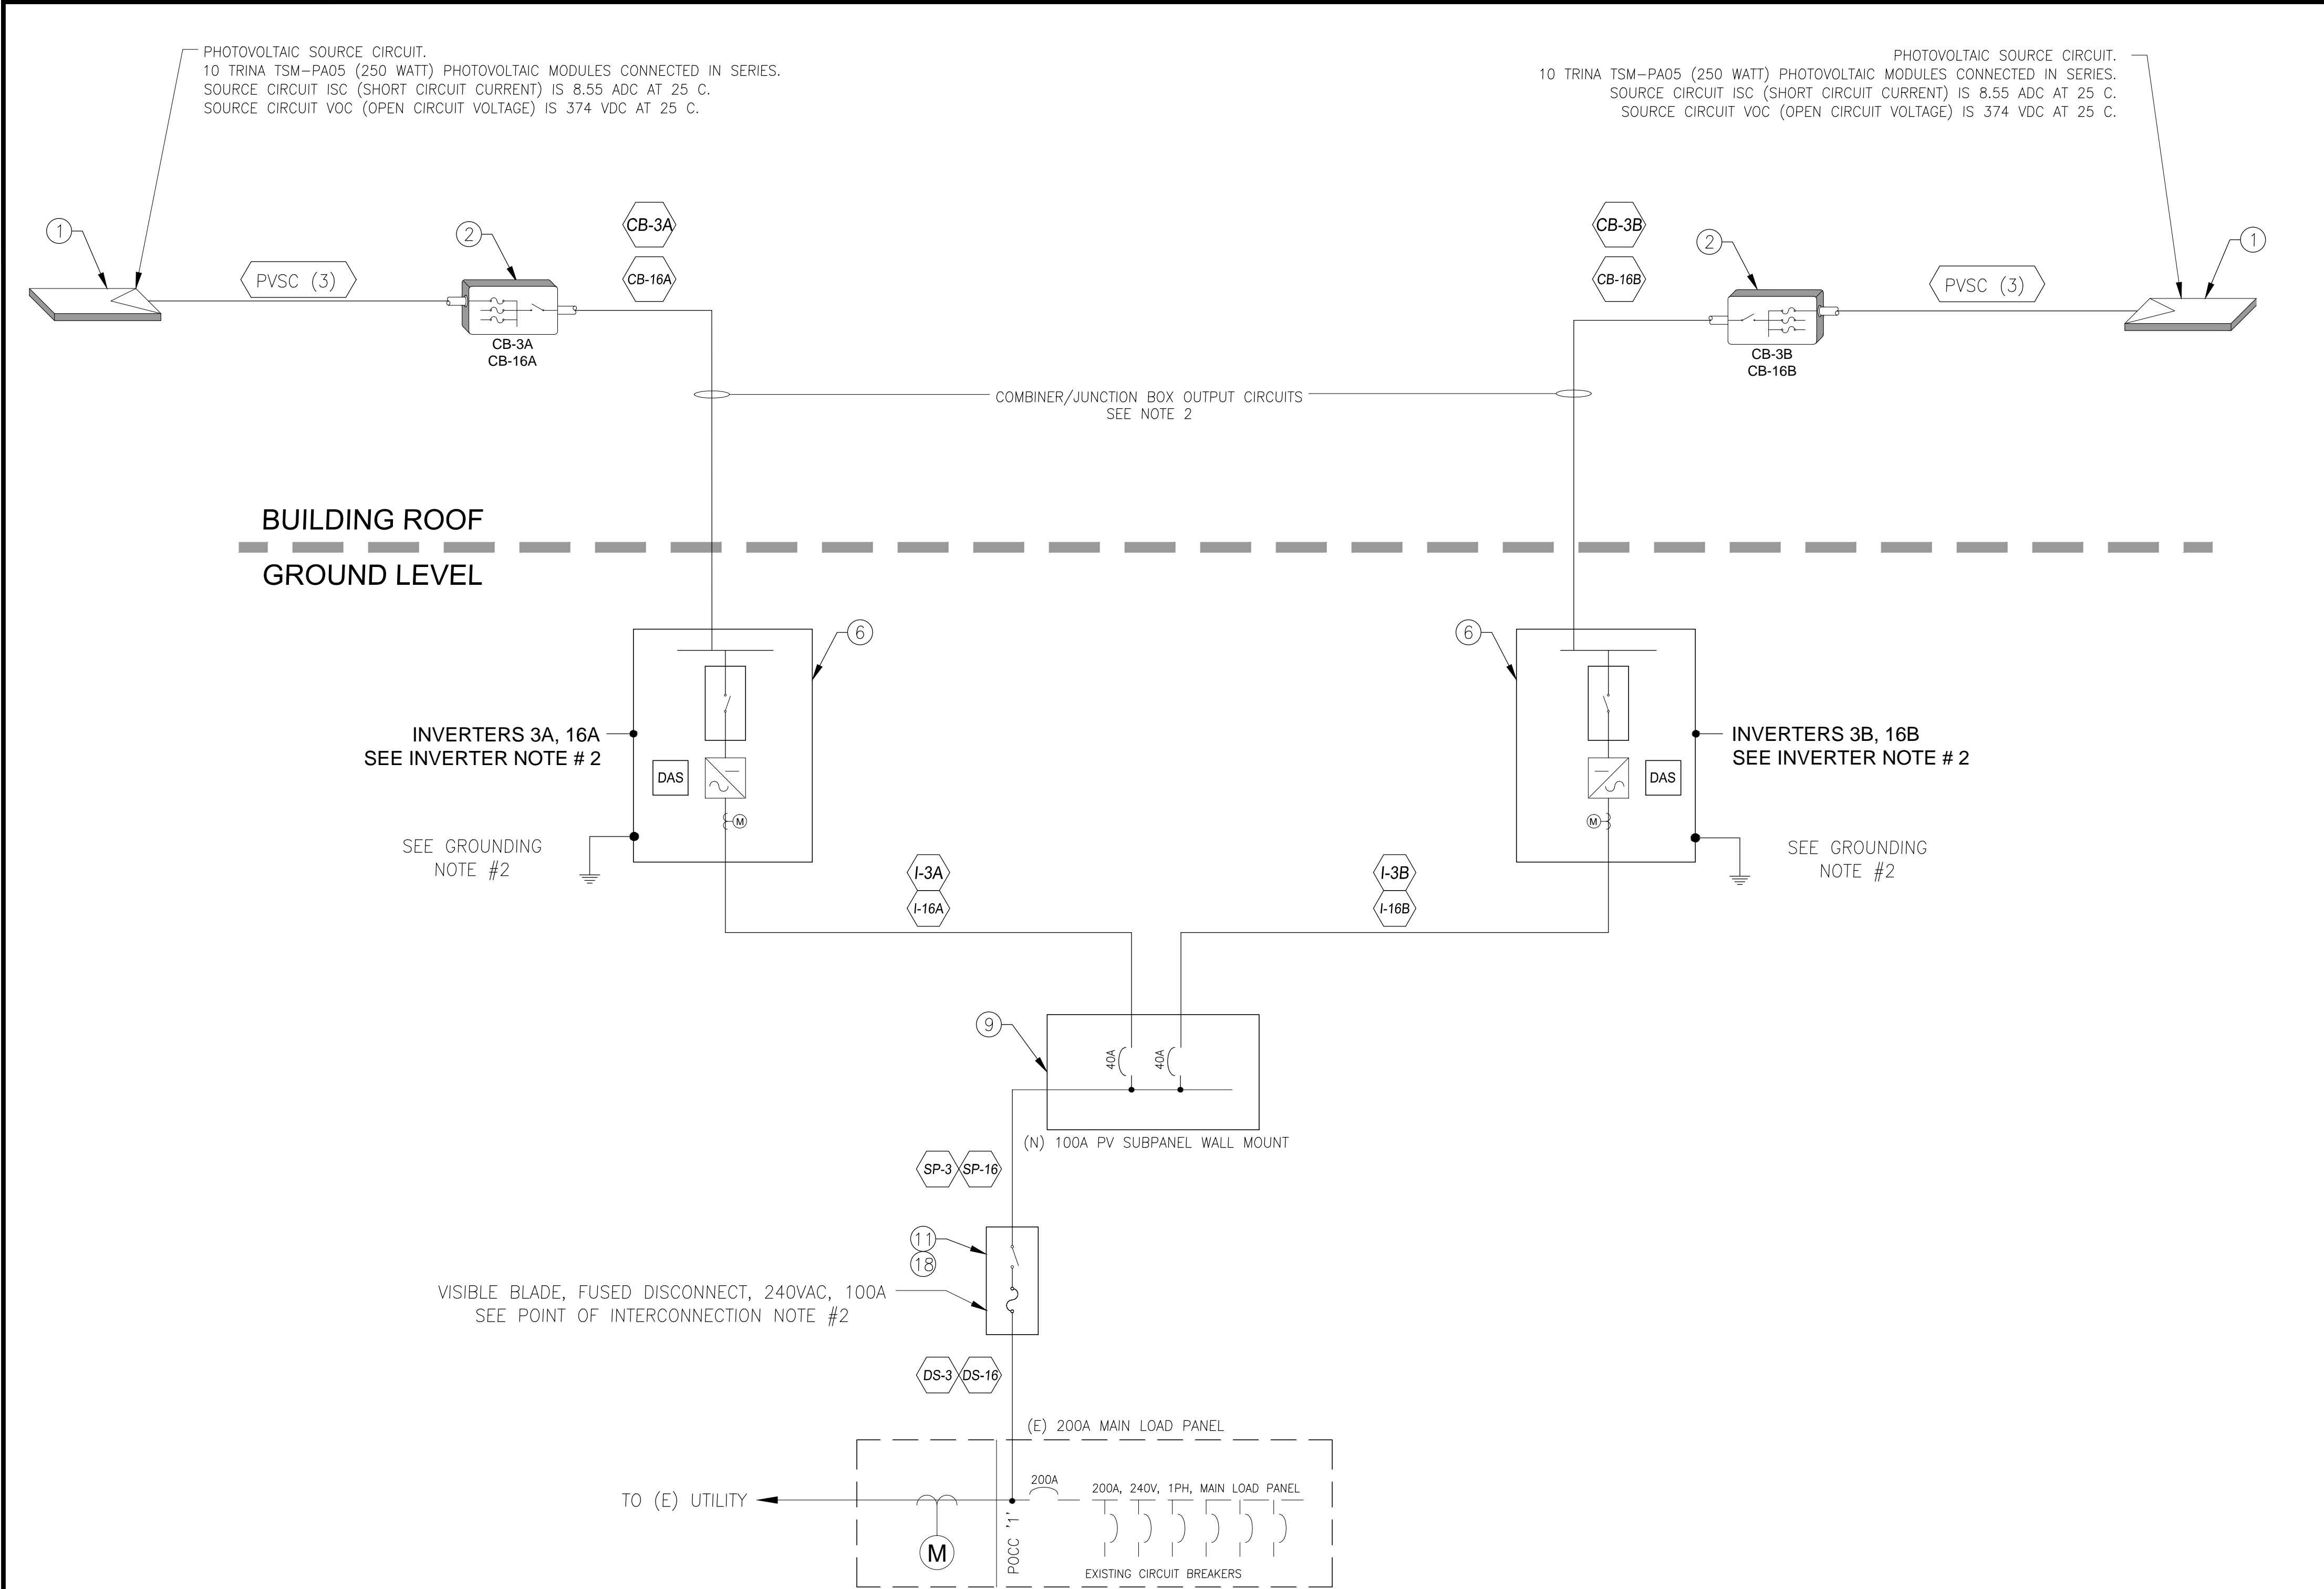

**SINGLE LINE DIAGRAM NOTES:**

1. ALL EQUIPMENT INSTALLED SHALL BE IN ACCORDANCE WITH ALL LOCAL AND ELECTRICAL BUILDING CODES. THE INSTALLATION SHALL CONFORM TO ALL LOCAL AND STATE SEISMIC REGULATIONS.
2. THE DC GROUNDING ELECTRODE CONDUCTOR SHALL BE BONDED WITH THE AC GROUNDING ELECTRODE.
3. COMBINER BOXES SHALL BE NEMA-4 ENCLOSURES OR BETTER.
4. ALL PV SOURCE CIRCUIT WIRES SHALL BE RHW/USE-2 SUNLIGHT RESISTANT OR XHHW-2.
5. #10-AWG BARE COPPER GROUND SHALL BE USED AS AN EQUIPMENT GROUND TO BOND THE MOUNTING SYSTEM TO THE OTHER PV SYSTEM EQUIPMENT AND TERMINATE IN THE COMBINER BOX. COMBINER BOX EQUIPMENT GROUND SHALL BE RUN IN SERIES AND TERMINATED IN THE INVERTER(S).

**GROUNDING NOTES:**

1. ALL BARE COPPER GROUND WIRING RUNNING BETWEEN ARRAYS SHALL BE PROTECTED FROM INADVERTENT DAMAGE BY BEING ROUTED INSIDE ACCEPTABLE CONDUIT OR WIREWAY. ALL CONDUITS OR WIREWAYS MUST BE NEATLY INSTALLED AND ATTACHED SECURELY TO THE MOUNTING SYSTEM.
2. THE GROUNDING ELECTRODE CONDUCTOR (GEC) ON THE AC SIDE OF THE SYSTEM SHALL BE TIED TO A CODE COMPLIANT GROUND ROD NEXT TO THE INVERTER OR AN EXISTING GEC POINT AT THE POCC.

**GENERAL EQUIPMENT NOTES:**

1. CIRCLE CALL-OUTS INDICATE BILL OF MATERIALS ITEM NUMBER AND IDENTIFY THE EQUIPMENT USED:
  - ② INDICATES ITEM 2, COMBINER BOX
  - ③ INDICATES ITEM 3, JUNCTION BOX
  - ④ THRU ⑧ INDICATES ITEMS 4-8, INVERTER
  - PVSC (3) INDICATES CIRCUIT TYPE AND NUMBER OF STRINGS
2. COMBINER/JUNCTION BOX OUTPUT CIRCUITS: EQUAL NUMBER OF CONDUCTORS FOR POSITIVE AND NEGATIVE COMBINER TERMINALS (1) 10-AWG GREEN EQUIPMENT GROUNDING CONDUCTOR (EGC) REFER TO TABLE 1A FOR OUTPUT CONDUCTOR AND CONDUIT SIZING
3. ALL CONDUCTORS ARE COPPER.
4. ALL ENCLOSURES ARE NEMA-4 UNLESS OTHERWISE NOTED.
5. EQUIPMENT SHALL BE INSTALLED IN ACCORDANCE WITH THE NEC AND ALL APPLICABLE REQUIREMENTS OF THE SERVING ELECTRICAL UTILITY COMPANY AND OF THE LOCAL AUTHORITY HAVING JURISDICTION.
6. COMBINER/JUNCTION BOXES ARE IDENTIFIED BY INVERTER DESIGNATION:  
INVERTER 3A & 16A: CB-3A & CB-16A  
INVERTER 3B & 16B: CB-3B & CB-16B
7. WHEN TRANSITIONING FROM RHW/USE-2 IN THE PV SOURCE CIRCUIT TO THHN/THWN-2, CONTRACTOR SHALL UTILIZE WATERTIGHT (NEMA-3R) JUNCTION BOX AND POLARIS CONNECTOR.

**INVERTER NOTES:**

1. INSTALLATION CONTRACTOR SHALL INSTALL COMBINER BOX OUTPUT CIRCUIT ON THE "COMBINED" INPUT CIRCUIT OF THE INVERTER. CONSULT INVERTER MANUAL FOR PROPER INSTALLATION OF REQUIRED CONNECTING DISTRIBUTORS.
2. INVERTERS ARE IDENTIFIED BY UNIT NUMBER AND LETTER FOR UNITS 3 AND 16  
INVERTER DESIGNATIONS ARE: INV 3A/3B AND 16A/16B

**POINT OF INTERCONNECTION NOTES:**

1. CONNECT FUSED DISCONNECT TO BUS BAR ON LINE SIDE OF SERVICE PANEL.  
THIS IS A LINE SIDE TAP.
2. ATTACH PLACARDS PER APPLICABLE PLACARD SHEET INSTRUCTIONS.

| TABLE 1A - DC CIRCUIT SCHEDULE |      |     |          |      |             |        |           |                     |      |        |      |                 |       |
|--------------------------------|------|-----|----------|------|-------------|--------|-----------|---------------------|------|--------|------|-----------------|-------|
| CURRENT CARRYING CONDUCTOR     |      |     |          |      |             |        | GROUNDING |                     |      | OCPD   |      | CONDUIT/RACEWAY |       |
| CIRCUIT #                      | TYPE | QTY | DISTANCE | SIZE | INSULATION  | V DROP | SIZE      | INSULATION          | TYPE | RATING | TYPE | SIZE /TYPE      | %FILL |
| Source                         | PVSC | 1   | 100      | 10   | RHW/USE-2   | 0.70%  | #10       | BARE                | EGC  | 15     | Fuse | BACK OF MODULE  |       |
| CB-3A                          | CBOC | 1   | 70       | 6    | THWN/THHN-2 | 0.58%  | #10       | THWN/THHN-2 (GREEN) | EGC  | -      | -    | 1" EMT          | 40    |
| CB-3B                          | CBOC | 1   | 70       | 6    | THWN/THHN-2 | 0.58%  | #10       | THWN/THHN-2 (GREEN) | EGC  | -      | -    | 1" EMT          | 40    |

| TABLE 2A - AC CIRCUIT SCHEDULE |      |     |          |      |             |        |           |             |      |        |      |                 |       |
|--------------------------------|------|-----|----------|------|-------------|--------|-----------|-------------|------|--------|------|-----------------|-------|
| CURRENT CARRYING CONDUCTOR     |      |     |          |      |             |        | GROUNDING |             |      | OCPD   |      | CONDUIT/RACEWAY |       |
| CIRCUIT #                      | TYPE | QTY | DISTANCE | SIZE | INSULATION  | V DROP | SIZE      | INSULATION  | TYPE | RATING | TYPE | SIZE /TYPE      | %FILL |
| I-3A                           | IOC  | 3   | 10       | 8    | THWN/THHN-2 | 0.19%  | 8         | THWN/THHN-2 | EGC  | 40     | CB   | 1" EMT          | 40    |
| I-3B                           | IOC  | 3   | 10       | 8    | THWN/THHN-2 | 0.19%  | 8         | THWN/THHN-2 | EGC  | 40     | CB   | 1" EMT          | 40    |
| SP-3                           | IOC  | 3   | 25       | 4    | THWN/THHN-2 | 0.38%  | 8         | THWN/THHN-2 | EGC  | 80     | CB   | 1-1/2" EMT      | 40    |
| DS-3                           | IOC  | 3   | 25       | 4    | THWN/THHN-2 | 0.38%  | 8         | THWN/THHN-2 | EGC  | 80     | CB   | 1-1/2" EMT      | 40    |

| TABLE 1A - DC CIRCUIT SCHEDULE |      |     |          |      |             |        |           |                     |      |        |      |                 |       |
|--------------------------------|------|-----|----------|------|-------------|--------|-----------|---------------------|------|--------|------|-----------------|-------|
| CURRENT CARRYING CONDUCTOR     |      |     |          |      |             |        | GROUNDING |                     |      | OCPE   |      | CONDUIT/RACEWAY |       |
| CIRCUIT #                      | TYPE | QTY | DISTANCE | SIZE | INSULATION  | V DROP | SIZE      | INSULATION          | TYPE | RATING | TYPE | SIZE /TYPE      | %FILL |
| Source                         | PVSC | 1   | 100      | 10   | RHW/USE-2   | 0.70%  | #10       | BARE                | EGC  | 15     | Fuse | BACK OF MODULE  |       |
| CB-16A                         | CBOC | 1   | 60       | 6    | THWN/THHN-2 | 0.50%  | #10       | THWN/THHN-2 (GREEN) | EGC  | -      | -    | 1" EMT          | 40    |
| CB-16B                         | CBOC | 1   | 70       | 6    | THWN/THHN-2 | 0.58%  | #10       | THWN/THHN-2 (GREEN) | EGC  | -      | -    | 1" EMT          | 40    |

| TABLE 2A - AC CIRCUIT SCHEDULE |      |     |          |      |             |        |           |             |      |        |      |                 |       |
|--------------------------------|------|-----|----------|------|-------------|--------|-----------|-------------|------|--------|------|-----------------|-------|
| CURRENT CARRYING CONDUCTOR     |      |     |          |      |             |        | GROUNDING |             |      | OCPD   |      | CONDUIT/RACEWAY |       |
| CIRCUIT #                      | TYPE | QTY | DISTANCE | SIZE | INSULATION  | V DROP | SIZE      | INSULATION  | TYPE | RATING | TYPE | SIZE /TYPE      | %FILL |
| I-16A                          | IOC  | 3   | 10       | 8    | THWN/THHN-2 | 0.19%  | 8         | THWN/THHN-2 | EGC  | 40     | CB   | 1" EMT          | 40    |
| I-16B                          | IOC  | 3   | 10       | 8    | THWN/THHN-2 | 0.19%  | 8         | THWN/THHN-2 | EGC  | 40     | CB   | 1" EMT          | 40    |
| SP-16                          | IOC  | 3   | 25       | 4    | THWN/THHN-2 | 0.38%  | 8         | THWN/THHN-2 | EGC  | 80     | CB   | 1-1/2" EMT      | 40    |
| DS-16                          | IOC  | 3   | 25       | 4    | THWN/THHN-2 | 0.38%  | 8         | THWN/THHN-2 | EGC  | 80     | CB   | 1-1/2" EMT      | 40    |

ENGINEER APPROVAL:



ROBERTO RIVERA, P.E. NO. 16743 DATE: 09/10/12

| REV | DATE    | DESCRIPTION                |
|-----|---------|----------------------------|
| 1   | 9/10/12 | 100% CONSTRUCTION DRAWINGS |

PREPARED BY:



6977 NAVAJO RD., SUITE 139  
SAN DIEGO, CA 92119  
PHONE: 858.270.9333  
FAX: 858.270.9334

THIS DOCUMENT IS CONSIDERED PROTECTED  
INTELLECTUAL PROPERTY AND CONTAINS PROPRIETARY  
INFORMATION UNDER UNITED STATES LAW. NO PORTION OR  
PART OF THIS DOCUMENT MAY BE REPRODUCED FOR ANY  
PURPOSE WITHOUT THE EXPLICIT WRITTEN PERMISSION OF  
SUSTINEO CORP.

OWNER/CLIENT:

MADONNA ROAD APARTMENTS  
1550 MADONNA ROAD  
SAN LUIS OBISPO, CA 93405



EVERYDAY ENERGY  
5865 AVENIDA ENCINAS,  
SUITE 142A  
CARLSBAD, CA, 92008  
P: (760) 607-7200

SINGLE LINE DIAGRAM - UNITS 3 & 16

PHOTOVOLTAIC SYSTEM

1550 MADONNA ROAD  
SAN LUIS OBISPO, CA 93405

PROJECT NO.: 038 - 108


APN: 140-040-003

DATE: SEPTEMBER 10, 2012

SHEET NO.:

E4.2  
14 OF 30



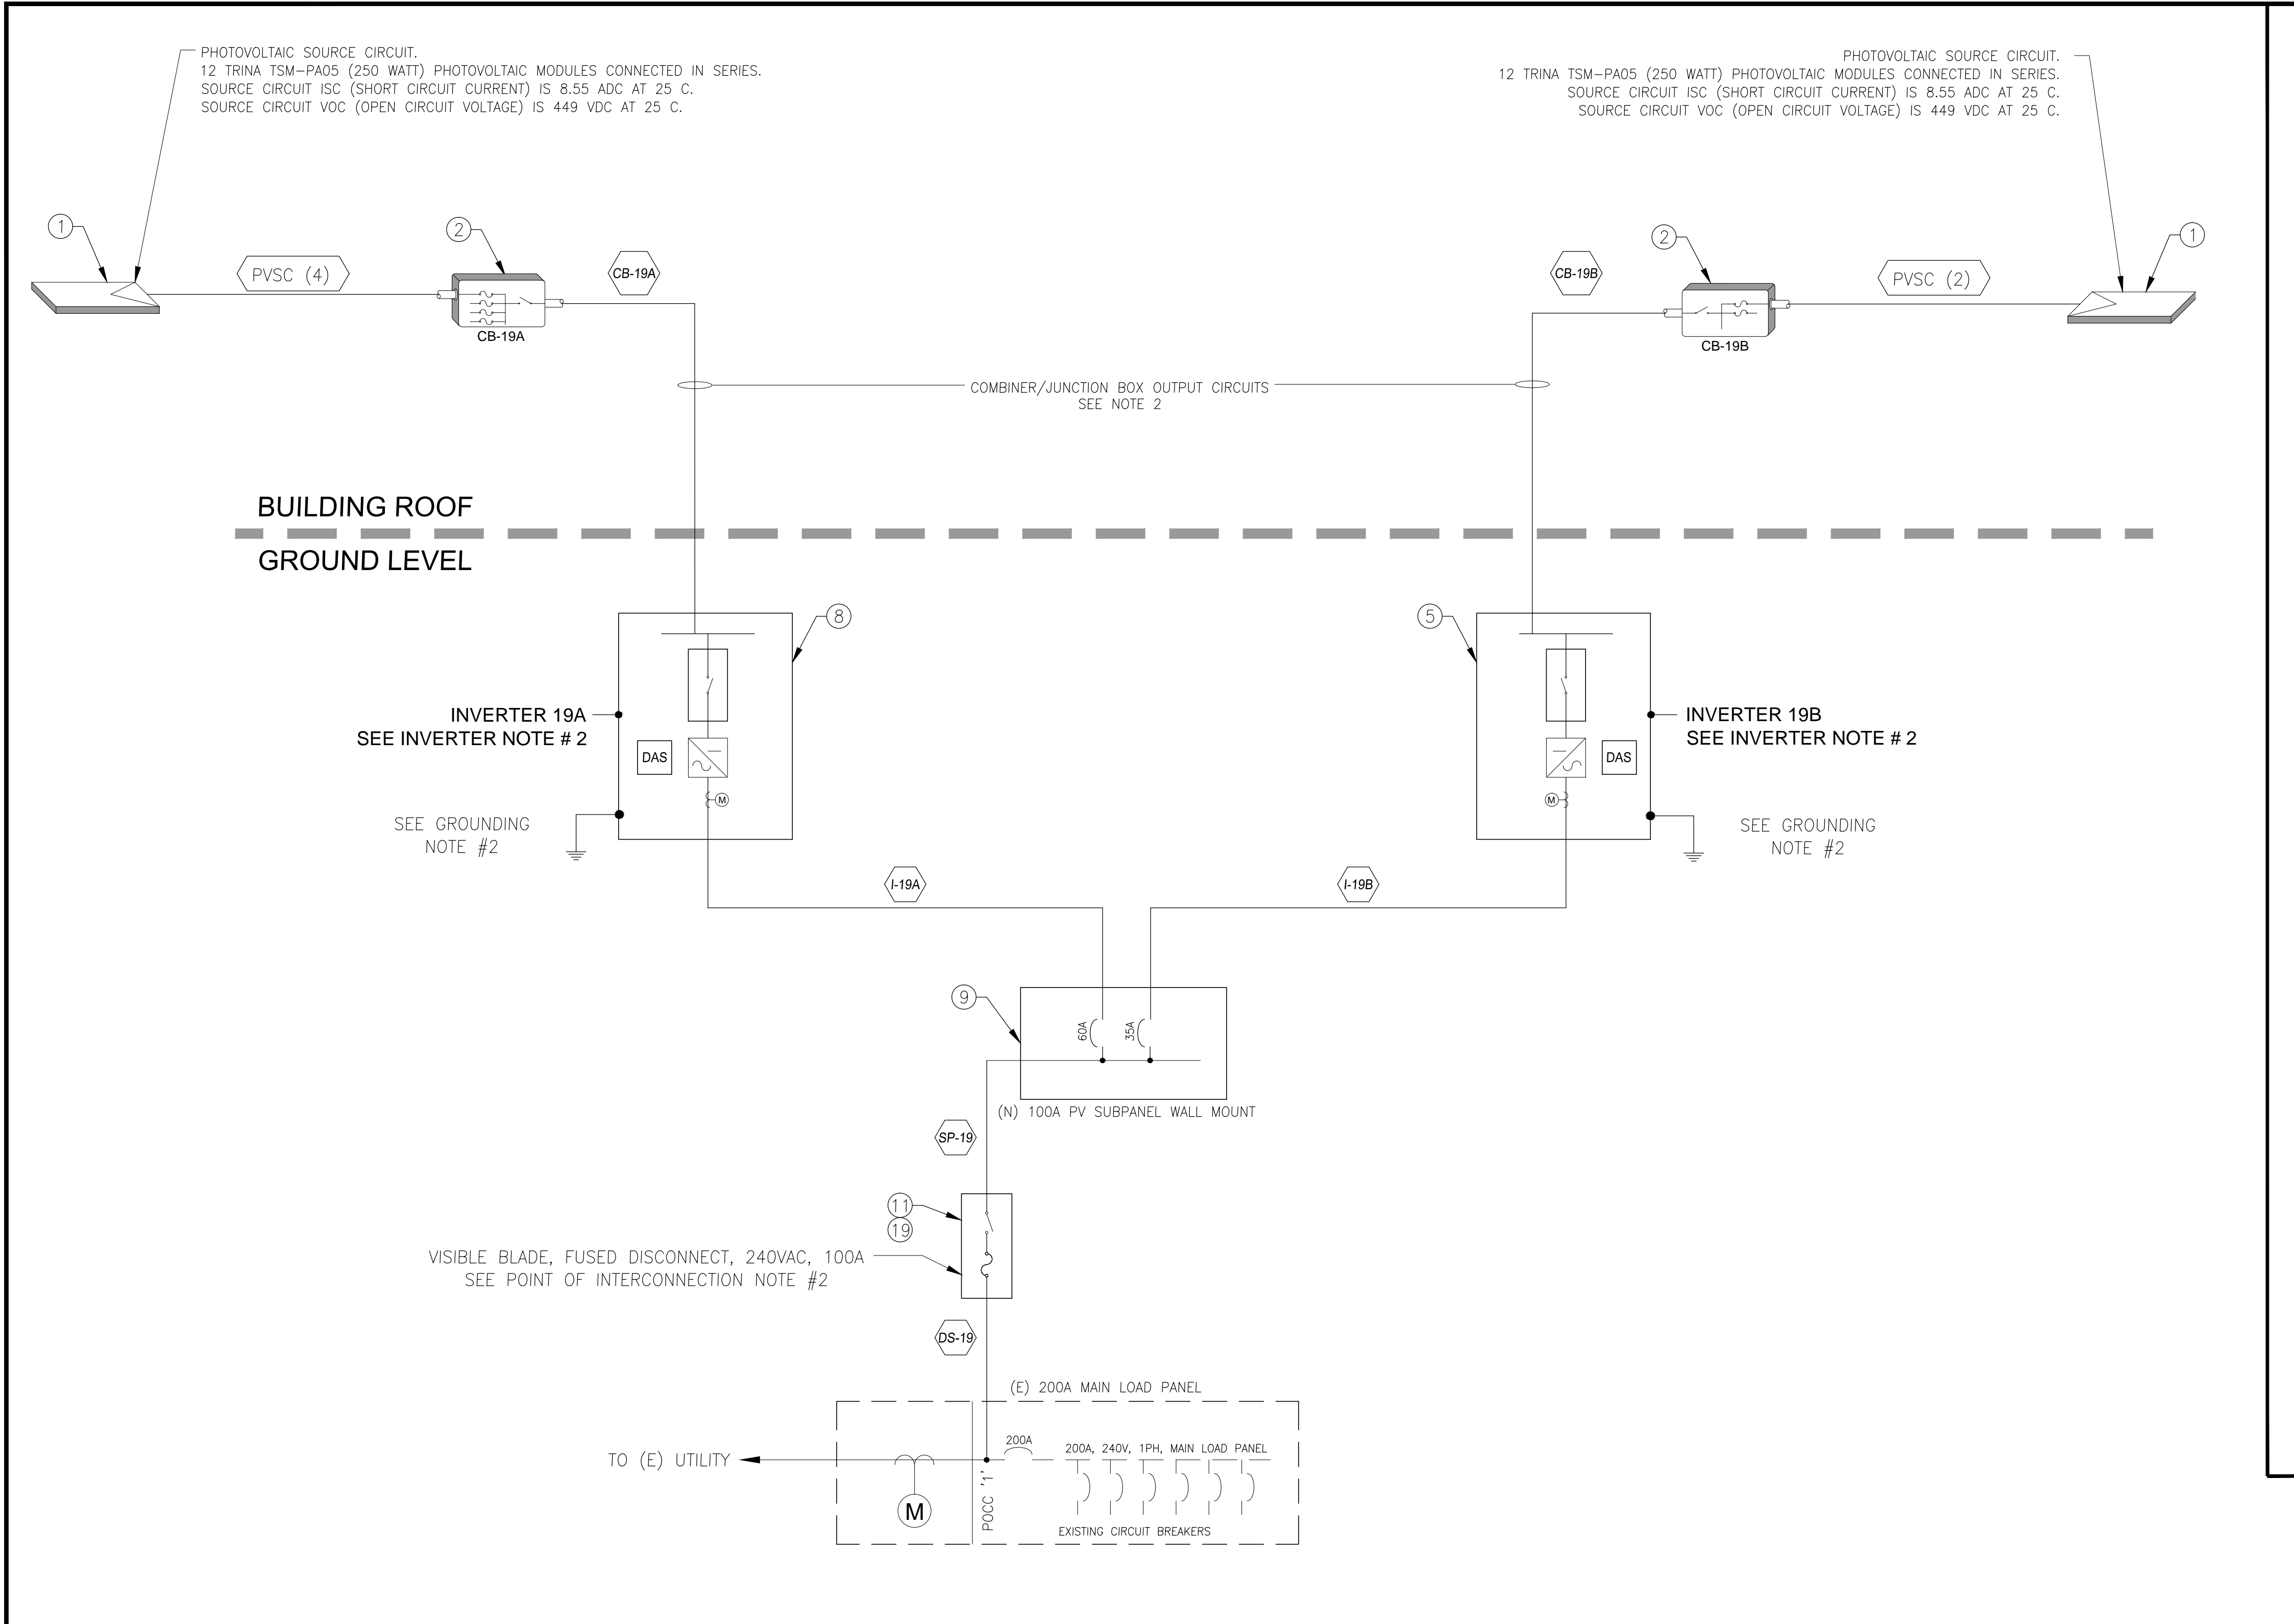

**SINGLE LINE DIAGRAM NOTES:**

1. ALL EQUIPMENT INSTALLED SHALL BE IN ACCORDANCE WITH ALL LOCAL AND ELECTRICAL BUILDING CODES. THE INSTALLATION SHALL CONFORM TO ALL LOCAL AND STATE SEISMIC REGULATIONS.
2. THE DC GROUNDING ELECTRODE CONDUCTOR SHALL BE BONDED WITH THE AC GROUNDING ELECTRODE.
3. COMBINER BOXES SHALL BE NEMA-4 ENCLOSURES OR BETTER.
4. ALL PV SOURCE CIRCUIT WIRES SHALL BE RHW/USE-2 SUNLIGHT RESISTANT OR XHHW-2.
5. #10-AWG BARE COPPER GROUND SHALL BE USED AS AN EQUIPMENT GROUND TO BOND THE MOUNTING SYSTEM TO THE OTHER PV SYSTEM EQUIPMENT AND TERMINATE IN THE COMBINER BOX. COMBINER BOX EQUIPMENT GROUND SHALL BE RUN IN SERIES AND TERMINATED IN THE INVERTER(S).

**GROUNDING NOTES:**

1. ALL BARE COPPER GROUND WIRING RUNNING BETWEEN ARRAYS SHALL BE PROTECTED FROM INADVERTENT DAMAGE BY BEING ROUTED INSIDE ACCEPTABLE CONDUIT OR WIREWAY. ALL CONDUITS OR WIREWAYS MUST BE NEATLY INSTALLED AND ATTACHED SECURELY TO THE MOUNTING SYSTEM.
2. THE GROUNDING ELECTRODE CONDUCTOR (GEC) ON THE AC SIDE OF THE SYSTEM SHALL BE TIED TO A CODE COMPLIANT GROUND ROD NEXT TO THE INVERTER OR AN EXISTING GEC POINT AT THE POCC.

**GENERAL EQUIPMENT NOTES:**

1. CIRCLE CALL-OUTS INDICATE BILL OF MATERIALS ITEM NUMBER AND IDENTIFY THE EQUIPMENT USED:
  - ② INDICATES ITEM 2, COMBINER BOX
  - ③ INDICATES ITEM 3, JUNCTION BOX
  - ④ THRU ⑧ INDICATES ITEMS 4-8, INVERTER
  - PVSC (3) INDICATES CIRCUIT TYPE AND NUMBER OF STRINGS
2. COMBINER/JUNCTION BOX OUTPUT CIRCUITS: EQUAL NUMBER OF CONDUCTORS FOR POSITIVE AND NEGATIVE COMBINER TERMINALS (1) 10-AWG GREEN EQUIPMENT GROUNDING CONDUCTOR (EGC) REFER TO TABLE 1A FOR OUTPUT CONDUCTOR AND CONDUIT SIZING
3. ALL CONDUCTORS ARE COPPER.
4. ALL ENCLOSURES ARE NEMA-4 UNLESS OTHERWISE NOTED.
5. EQUIPMENT SHALL BE INSTALLED IN ACCORDANCE WITH THE NEC AND ALL APPLICABLE REQUIREMENTS OF THE SERVING ELECTRICAL UTILITY COMPANY AND OF THE LOCAL AUTHORITY HAVING JURISDICTION.
6. COMBINER/JUNCTION BOXES ARE IDENTIFIED BY INVERTER DESIGNATION:  
INVERTER 19A: CB-19A  
INVERTER 19B: CB-19B
7. WHEN TRANSITIONING FROM RHW/USE-2 IN THE PV SOURCE CIRCUIT TO THWN/THHN-2, CONTRACTOR SHALL UTILIZE WATERTIGHT (NEMA-3R) JUNCTION BOX AND POLARIS CONNECTOR.

**INVERTER NOTES:**

1. INSTALLATION CONTRACTOR SHALL INSTALL COMBINER BOX OUTPUT CIRCUIT ON THE "COMBINED" INPUT CIRCUIT OF THE INVERTER. CONSULT INVERTER MANUAL FOR PROPER INSTALLATION OF REQUIRED CONNECTING DISTRIBUTORS.
2. INVERTERS ARE IDENTIFIED BY UNIT NUMBER AND LETTER. FOR UNIT 19 INVERTER DESIGNATIONS ARE: INV 19A AND 19B

**POINT OF INTERCONNECTION NOTES:**

1. CONNECT FUSED DISCONNECT TO BUS BAR ON LINE SIDE OF SERVICE PANEL. THIS IS A LINE SIDE TAP.
2. ATTACH PLACARDS PER APPLICABLE PLACARD SHEET INSTRUCTIONS.

| TABLE 1A - DC CIRCUIT SCHEDULE |      |     |          |      |             |        |           |                     |      |        |      |                 |       |
|--------------------------------|------|-----|----------|------|-------------|--------|-----------|---------------------|------|--------|------|-----------------|-------|
| CURRENT CARRYING CONDUCTOR     |      |     |          |      |             |        | GROUNDING |                     |      | OCPE   |      | CONDUIT/RACEWAY |       |
| CIRCUIT #                      | TYPE | QTY | DISTANCE | SIZE | INSULATION  | V DROP | SIZE      | INSULATION          | TYPE | RATING | TYPE | SIZE /TYPE      | %FILL |
| Source                         | PVSC | 1   | 100      | 10   | RHW/USE-2   | 0.59%  | #10       | BARE                | EGC  | 15     | Fuse | BACK OF MODULE  |       |
| CB19A-1                        | CBOC | 1   | 90       | 6    | THWN/THHN-2 | 0.83%  | #10       | THWN/THHN-2 (GREEN) | EGC  | -      | -    | 1" EMT          | 40    |
| CB19B-1                        | CBOC | 1   | 70       | 8    | THWN/THHN-2 | 0.51%  | #10       | THWN/THHN-2 (GREEN) | EGC  | -      | -    | 1" EMT          | 40    |

| TABLE 2A - AC CIRCUIT SCHEDULE |      |     |          |      |             |        |           |             |      |        |      |                 |       |
|--------------------------------|------|-----|----------|------|-------------|--------|-----------|-------------|------|--------|------|-----------------|-------|
| CURRENT CARRYING CONDUCTOR     |      |     |          |      |             |        | GROUNDING |             |      | OCPD   |      | CONDUIT/RACEWAY |       |
| CIRCUIT #                      | TYPE | QTY | DISTANCE | SIZE | INSULATION  | V DROP | SIZE      | INSULATION  | TYPE | RATING | TYPE | SIZE /TYPE      | %FILL |
| I-19A                          | IOC  | 3   | 11       | 6    | THWN/THHN-2 | 0.20%  | 8         | THWN/THHN-2 | EGC  | 60     | CB   | 1" EMT          | 40    |
| I-19B                          | IOC  | 3   | 11       | 10   | THWN/THHN-2 | 0.27%  | 8         | THWN/THHN-2 | EGC  | 35     | CB   | 1" EMT          | 40    |
| SP-19                          | IOC  | 3   | 25       | 3    | THWN/THHN-2 | 0.35%  | 8         | THWN/THHN-2 | EGC  | 100    | CB   | 1-1/2" EMT      | 40    |
| DS-19                          | IOC  | 3   | 25       | 3    | THWN/THHN-2 | 0.35%  | 8         | THWN/THHN-2 | EGC  | 100    | CB   | 1-1/2" EMT      | 40    |

SINGLE LINE WIRING DIAGRAM - UNIT 19

ENGINEER APPROVAL:

REGISTERED PROFESSIONAL ENGINEER  
ROBERTO RIVERA  
NO. 16743  
Exp. 9/30/12  
ELECTRICAL  
STATE OF CALIFORNIA

ROBERTO RIVERA, P.E. NO. 16743  
DATE: 09/10/12

| REV. | DATE:   | DESCRIPTION:               |
|------|---------|----------------------------|
| 1    | 9/10/12 | 100% CONSTRUCTION DRAWINGS |

PREPARED BY:

6977 NAVAJO RD., SUITE 139  
SAN DIEGO, CA 92119  
PHONE: 858.270.9333  
FAX: 858.270.9334

THIS DOCUMENT IS CONSIDERED PROTECTED INTELLECTUAL PROPERTY AND CONTAINS PROPRIETARY INFORMATION UNDER UNITED STATES LAW. NO PORTION OR PART OF THIS DOCUMENT MAY BE REPRODUCED FOR ANY PURPOSE WITHOUT THE EXPLICIT WRITTEN PERMISSION OF SUSTINEO CORP.

OWNER/CLIENT:

EVERYDAY ENERGY  
5865 AVENIDA ENCINAS,  
SUITE 142A  
CARLSBAD, CA, 92008  
P: (760) 607-7200

TITLE: SINGLE LINE DIAGRAM - UNIT 19

PROJECT LOCATION: 1550 MADONNA ROAD  
SAN LUIS OBISPO, CA 93405


PROJECT NO.: 038 - 108

APN: 140-040-003

DATE: SEPTEMBER 10, 2012

SHEET NO.: **E4.3**  
15 OF 30



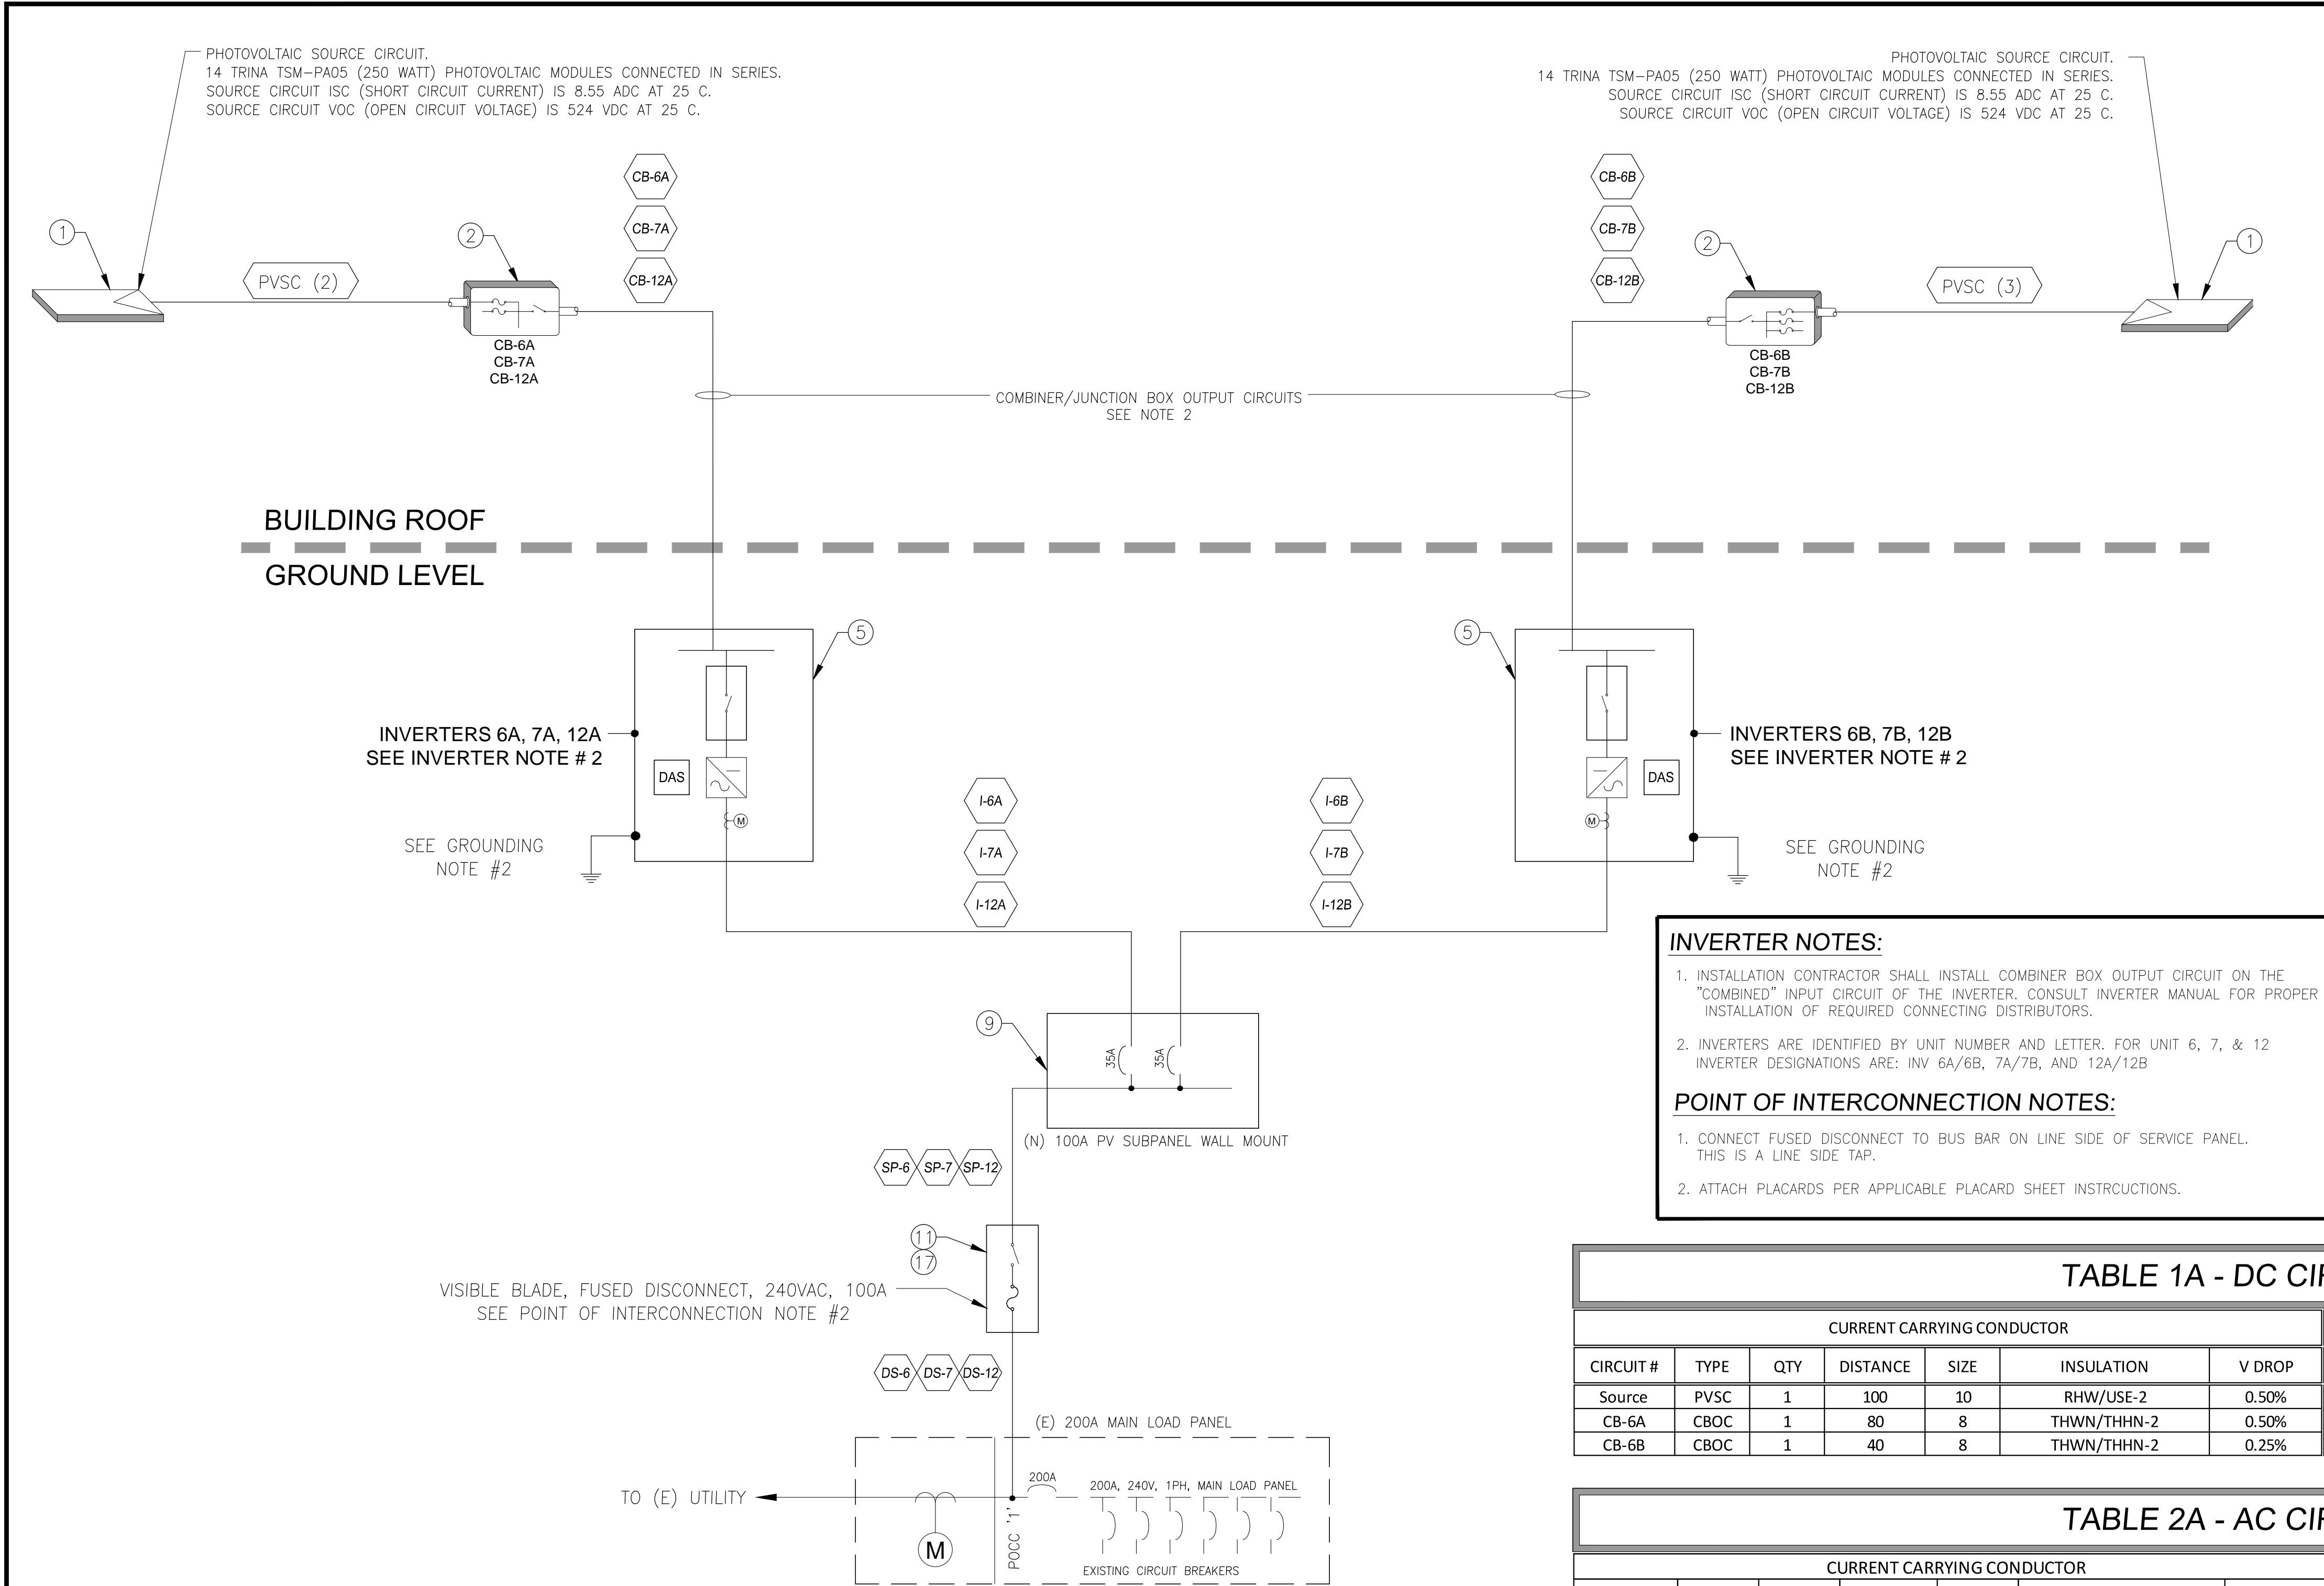

#### SINGLE LINE DIAGRAM NOTES:

1. ALL EQUIPMENT INSTALLED SHALL BE IN ACCORDANCE WITH ALL LOCAL AND ELECTRICAL BUILDING CODES. THE INSTALLATION SHALL CONFORM TO ALL LOCAL AND STATE SEISMIC REGULATIONS.
2. THE DC GROUNDING ELECTRODE CONDUCTOR SHALL BE BONDED WITH THE AC GROUNDING ELECTRODE.
3. COMBINER BOXES SHALL BE NEMA-4 ENCLOSURES OR BETTER.
4. ALL PV SOURCE CIRCUIT WIRES SHALL BE RHW/USE-2 SUNLIGHT RESISTANT OR XHHW-2.
5. #10-AWG BARE COPPER GROUND SHALL BE USED AS AN EQUIPMENT GROUND TO BOND THE MOUNTING SYSTEM TO THE OTHER PV SYSTEM EQUIPMENT AND TERMINATE IN THE COMBINER BOX. COMBINER BOX EQUIPMENT GROUND SHALL BE RUN IN SERIES AND TERMINATED IN THE INVERTER(S).

#### GROUNDING NOTES:

1. ALL BARE COPPER GROUND WIRING RUNNING BETWEEN ARRAYS SHALL BE PROTECTED FROM INADVERTENT DAMAGE BY BEING ROUTED INSIDE ACCEPTABLE CONDUIT OR WIREWAY. ALL CONDUITS OR WIREWAYS MUST BE NEATLY INSTALLED AND ATTACHED SECURELY TO THE MOUNTING SYSTEM.
2. THE GROUNDING ELECTRODE CONDUCTOR (GEC) ON THE AC SIDE OF THE SYSTEM SHALL BE TIED TO A CODE COMPLIANT GROUND ROD NEXT TO THE INVERTER OR AN EXISTING GEC POINT AT THE POCC.

#### GENERAL EQUIPMENT NOTES:

1. CIRCULE CALL-OUTS INDICATE BILL OF MATERIALS ITEM NUMBER AND IDENTIFY THE EQUIPMENT USED:
  - ② INDICATES ITEM 2, COMBINER BOX
  - ③ INDICATES ITEM 3, JUNCTION BOX
  - ④ THRU ⑧ INDICATES ITEMS 4-8, INVERTER
  - PVSC (3) INDICATES CIRCUIT TYPE AND NUMBER OF STRINGS
2. COMBINER/JUNCTION BOX OUTPUT CIRCUITS: EQUAL NUMBER OF CONDUCTORS FOR POSITIVE AND NEGATIVE COMBINER TERMINALS (1) 10-AWG GREEN EQUIPMENT GROUNDING CONDUCTOR (EGC) REFER TO TABLE 1A FOR OUTPUT CONDUCTOR AND CONDUIT SIZING
3. ALL CONDUCTORS ARE COPPER.
4. ALL ENCLOSURES ARE NEMA-4 UNLESS OTHERWISE NOTED.
5. EQUIPMENT SHALL BE INSTALLED IN ACCORDANCE WITH THE NEC AND ALL APPLICABLE REQUIREMENTS OF THE SERVING ELECTRICAL UTILITY COMPANY AND OF THE LOCAL AUTHORITY HAVING JURISDICTION.
6. COMBINER/JUNCTION BOXES ARE IDENTIFIED BY INVERTER DESIGNATION:  
INVERTER 6A, 7A, 12A: CB-6A, CB-7A, CB-12A  
INVERTER 6B, 7B, 12B: CB-6B, CB-7B, CB-12B
7. WHEN TRANSITIONING FROM RHW/USE-2 IN THE PV SOURCE CIRCUIT TO THHN/THWN-2, CONTRACTOR SHALL UTILIZE WATERTIGHT (NEMA-3R) JUNCTION BOX AND POLARIS CONNECTOR.

TABLE 1A - DC CIRCUIT SCHEDULE

| CURRENT CARRYING CONDUCTOR |      |     |          |      |             |        | GROUNDING |                     |      | OCPE   |      | CONDUIT/RACEWAY |       |
|----------------------------|------|-----|----------|------|-------------|--------|-----------|---------------------|------|--------|------|-----------------|-------|
| CIRCUIT #                  | TYPE | QTY | DISTANCE | SIZE | INSULATION  | V DROP | SIZE      | INSULATION          | TYPE | RATING | TYPE | SIZE /TYPE      | %FILL |
| Source                     | PVSC | 1   | 100      | 10   | RHW/USE-2   | 0.50%  | #10       | BARE                | EGC  | 15     | Fuse | BACK OF MODULE  |       |
| CB-6A                      | CBOC | 1   | 80       | 8    | THWN/THHN-2 | 0.50%  | #10       | THWN/THHN-2 (GREEN) | EGC  | -      | -    | 1" EMT          | 40    |
| CB-6B                      | CBOC | 1   | 40       | 8    | THWN/THHN-2 | 0.25%  | #10       | THWN/THHN-2 (GREEN) | EGC  | -      | -    | 1" EMT          | 40    |

TABLE 2A - AC CIRCUIT SCHEDULE

| CURRENT CARRYING CONDUCTOR |      |     |          |      |             |        | GROUNDING |             |      | OCPD   |      | CONDUIT/RACEWAY |       |
|----------------------------|------|-----|----------|------|-------------|--------|-----------|-------------|------|--------|------|-----------------|-------|
| CIRCUIT #                  | TYPE | QTY | DISTANCE | SIZE | INSULATION  | V DROP | SIZE      | INSULATION  | TYPE | RATING | TYPE | SIZE /TYPE      | %FILL |
| I-6A                       | IOC  | 3   | 10       | 10   | THWN/THHN-2 | 0.24%  | 8         | THWN/THHN-2 | EGC  | 35     | CB   | 1" EMT          | 40    |
| I-6B                       | IOC  | 3   | 10       | 10   | THWN/THHN-2 | 0.24%  | 8         | THWN/THHN-2 | EGC  | 35     | CB   | 1" EMT          | 40    |
| SP-6                       | IOC  | 3   | 25       | 6    | THWN/THHN-2 | 0.48%  | 8         | THWN/THHN-2 | EGC  | 70     | CB   | 1" EMT          | 40    |
| DS-6                       | IOC  | 3   | 25       | 6    | THWN/THHN-2 | 0.48%  | 8         | THWN/THHN-2 | EGC  | 70     | CB   | 1" EMT          | 40    |

TABLE 1A - DC CIRCUIT SCHEDULE

| CURRENT CARRYING CONDUCTOR |      |     |          |      |             |        | GROUNDING |                     |      | OCPE   |      | CONDUIT/RACEWAY |       |
|----------------------------|------|-----|----------|------|-------------|--------|-----------|---------------------|------|--------|------|-----------------|-------|
| CIRCUIT #                  | TYPE | QTY | DISTANCE | SIZE | INSULATION  | V DROP | SIZE      | INSULATION          | TYPE | RATING | TYPE | SIZE /TYPE      | %FILL |
| Source                     | PVSC | 1   | 100      | 10   | RHW/USE-2   | 0.50%  | #10       | BARE                | EGC  | 15     | Fuse | BACK OF MODULE  |       |
| CB-12A                     | CBOC | 1   | 80       | 8    | THWN/THHN-2 | 0.50%  | #10       | THWN/THHN-2 (GREEN) | EGC  | -      | -    | 1" EMT          | 40    |
| CB-12B                     | CBOC | 1   | 50       | 8    | THWN/THHN-2 | 0.32%  | #10       | THWN/THHN-2 (GREEN) | EGC  | -      | -    | 1" EMT          | 40    |

TABLE 2A - AC CIRCUIT SCHEDULE

| CURRENT CARRYING CONDUCTOR |      |     |          |      |             |        | GROUNDING |             |      | OCPD   |      | CONDUIT/RACEWAY |       |
|----------------------------|------|-----|----------|------|-------------|--------|-----------|-------------|------|--------|------|-----------------|-------|
| CIRCUIT #                  | TYPE | QTY | DISTANCE | SIZE | INSULATION  | V DROP | SIZE      | INSULATION  | TYPE | RATING | TYPE | SIZE /TYPE      | %FILL |
| I-12A                      | IOC  | 3   | 10       | 10   | THWN/THHN-2 | 0.24%  | 8         | THWN/THHN-2 | EGC  | 35     | CB   | 1" EMT          | 40    |
| I-12B                      | IOC  | 3   | 10       | 10   | THWN/THHN-2 | 0.24%  | 8         | THWN/THHN-2 | EGC  | 35     | CB   | 1" EMT          | 40    |
| SP-12                      | IOC  | 3   | 25       | 6    | THWN/THHN-2 | 0.48%  | 8         | THWN/THHN-2 | EGC  | 70     | CB   | 1" EMT          | 40    |
| DS-12                      | IOC  | 3   | 25       | 6    | THWN/THHN-2 | 0.48%  | 8         | THWN/THHN-2 | EGC  | 70     | CB   | 1" EMT          | 40    |

TABLE 1A - DC CIRCUIT SCHEDULE

| CURRENT CARRYING CONDUCTOR |      |     |          |      |             |        | GROUNDING |                     |      | OCPE   |      | CONDUIT/RACEWAY |       |
|----------------------------|------|-----|----------|------|-------------|--------|-----------|---------------------|------|--------|------|-----------------|-------|
| CIRCUIT #                  | TYPE | QTY | DISTANCE | SIZE | INSULATION  | V DROP | SIZE      | INSULATION          | TYPE | RATING | TYPE | SIZE /TYPE      | %FILL |
| Source                     | PVSC | 1   | 100      | 10   | RHW/USE-2   | 0.50%  | #10       | BARE                | EGC  | 15     | Fuse | BACK OF MODULE  |       |
| CB-7A                      | CBOC | 1   | 40       | 8    | THWN/THHN-2 | 0.25%  | #10       | THWN/THHN-2 (GREEN) | EGC  | -      | -    | 1" EMT          | 40    |
| CB-7B                      | CBOC | 1   | 50       | 8    | THWN/THHN-2 | 0.32%  | #10       | THWN/THHN-2 (GREEN) | EGC  | -      | -    | 1" EMT          | 40    |

TABLE 2A - AC CIRCUIT SCHEDULE

| CURRENT CARRYING CONDUCTOR |      |     |          |      |             |        | GROUNDING |             |      | OCPD   |      | CONDUIT/RACEWAY |       |
|----------------------------|------|-----|----------|------|-------------|--------|-----------|-------------|------|--------|------|-----------------|-------|
| CIRCUIT #                  | TYPE | QTY | DISTANCE | SIZE | INSULATION  | V DROP | SIZE      | INSULATION  | TYPE | RATING | TYPE | SIZE /TYPE      | %FILL |
| I-7A                       | IOC  | 3   | 10       | 10   | THWN/THHN-2 | 0.24%  | 8         | THWN/THHN-2 | EGC  | 35     | CB   | 1" EMT          | 40    |
| I-7B                       | IOC  | 3   | 10       | 10   | THWN/THHN-2 | 0.24%  | 8         | THWN/THHN-2 | EGC  | 35     | CB   | 1" EMT          | 40    |
| SP-7                       | IOC  | 3   | 25       | 6    | THWN/THHN-2 | 0.48%  | 8         | THWN/THHN-2 | EGC  | 70     | CB   | 1" EMT          | 40    |
| DS-7                       | IOC  | 3   | 25       | 6    | THWN/THHN-2 | 0.48%  | 8         | THWN/THHN-2 | EGC  | 70     | CB   | 1" EMT          | 40    |

ENGINEER APPROVAL:



ROBERTO RIVERA, P.E. NO. 16743 DATE: 09/10/12

DESCRIPTION: 100% CONSTRUCTION DRAWINGS

PREPARED BY:



6977 NAVAJO RD., SUITE 139  
SAN DIEGO, CA 92119  
PHONE: 858.270.9333  
FAX: 858.270.9334

THIS DOCUMENT IS CONSIDERED PROTECTED  
INTELLECTUAL PROPERTY AND CONTAINS PROPRIETARY  
INFORMATION UNDER UNITED STATES LAW. NO PORTION OR  
PART OF THIS DOCUMENT MAY BE REPRODUCED FOR ANY  
PURPOSE WITHOUT THE EXPLICIT WRITTEN PERMISSION OF  
SUSTINEO CORP.

OWNER/CLIENT:

MADONNA ROAD APARTMENTS  
1550 MADONNA ROAD  
SAN LUIS OBISPO, CA 93405



EVERYDAY ENERGY  
5865 AVENIDA ENCINAS,  
SUITE 142A  
CARLSBAD, CA, 92008  
P: (760) 607-7200

SINGLE LINE DIAGRAM - UNITS 6, 7, 12

PHOTOVOLTAIC SYSTEM

1550 MADONNA ROAD  
SAN LUIS OBISPO, CA 93405

TITLE:

PROJECT NO.:

038 - 108

APN:

140-040-003


DATE:

SEPTEMBER 10, 2012

SHEET NO.:

E4.4



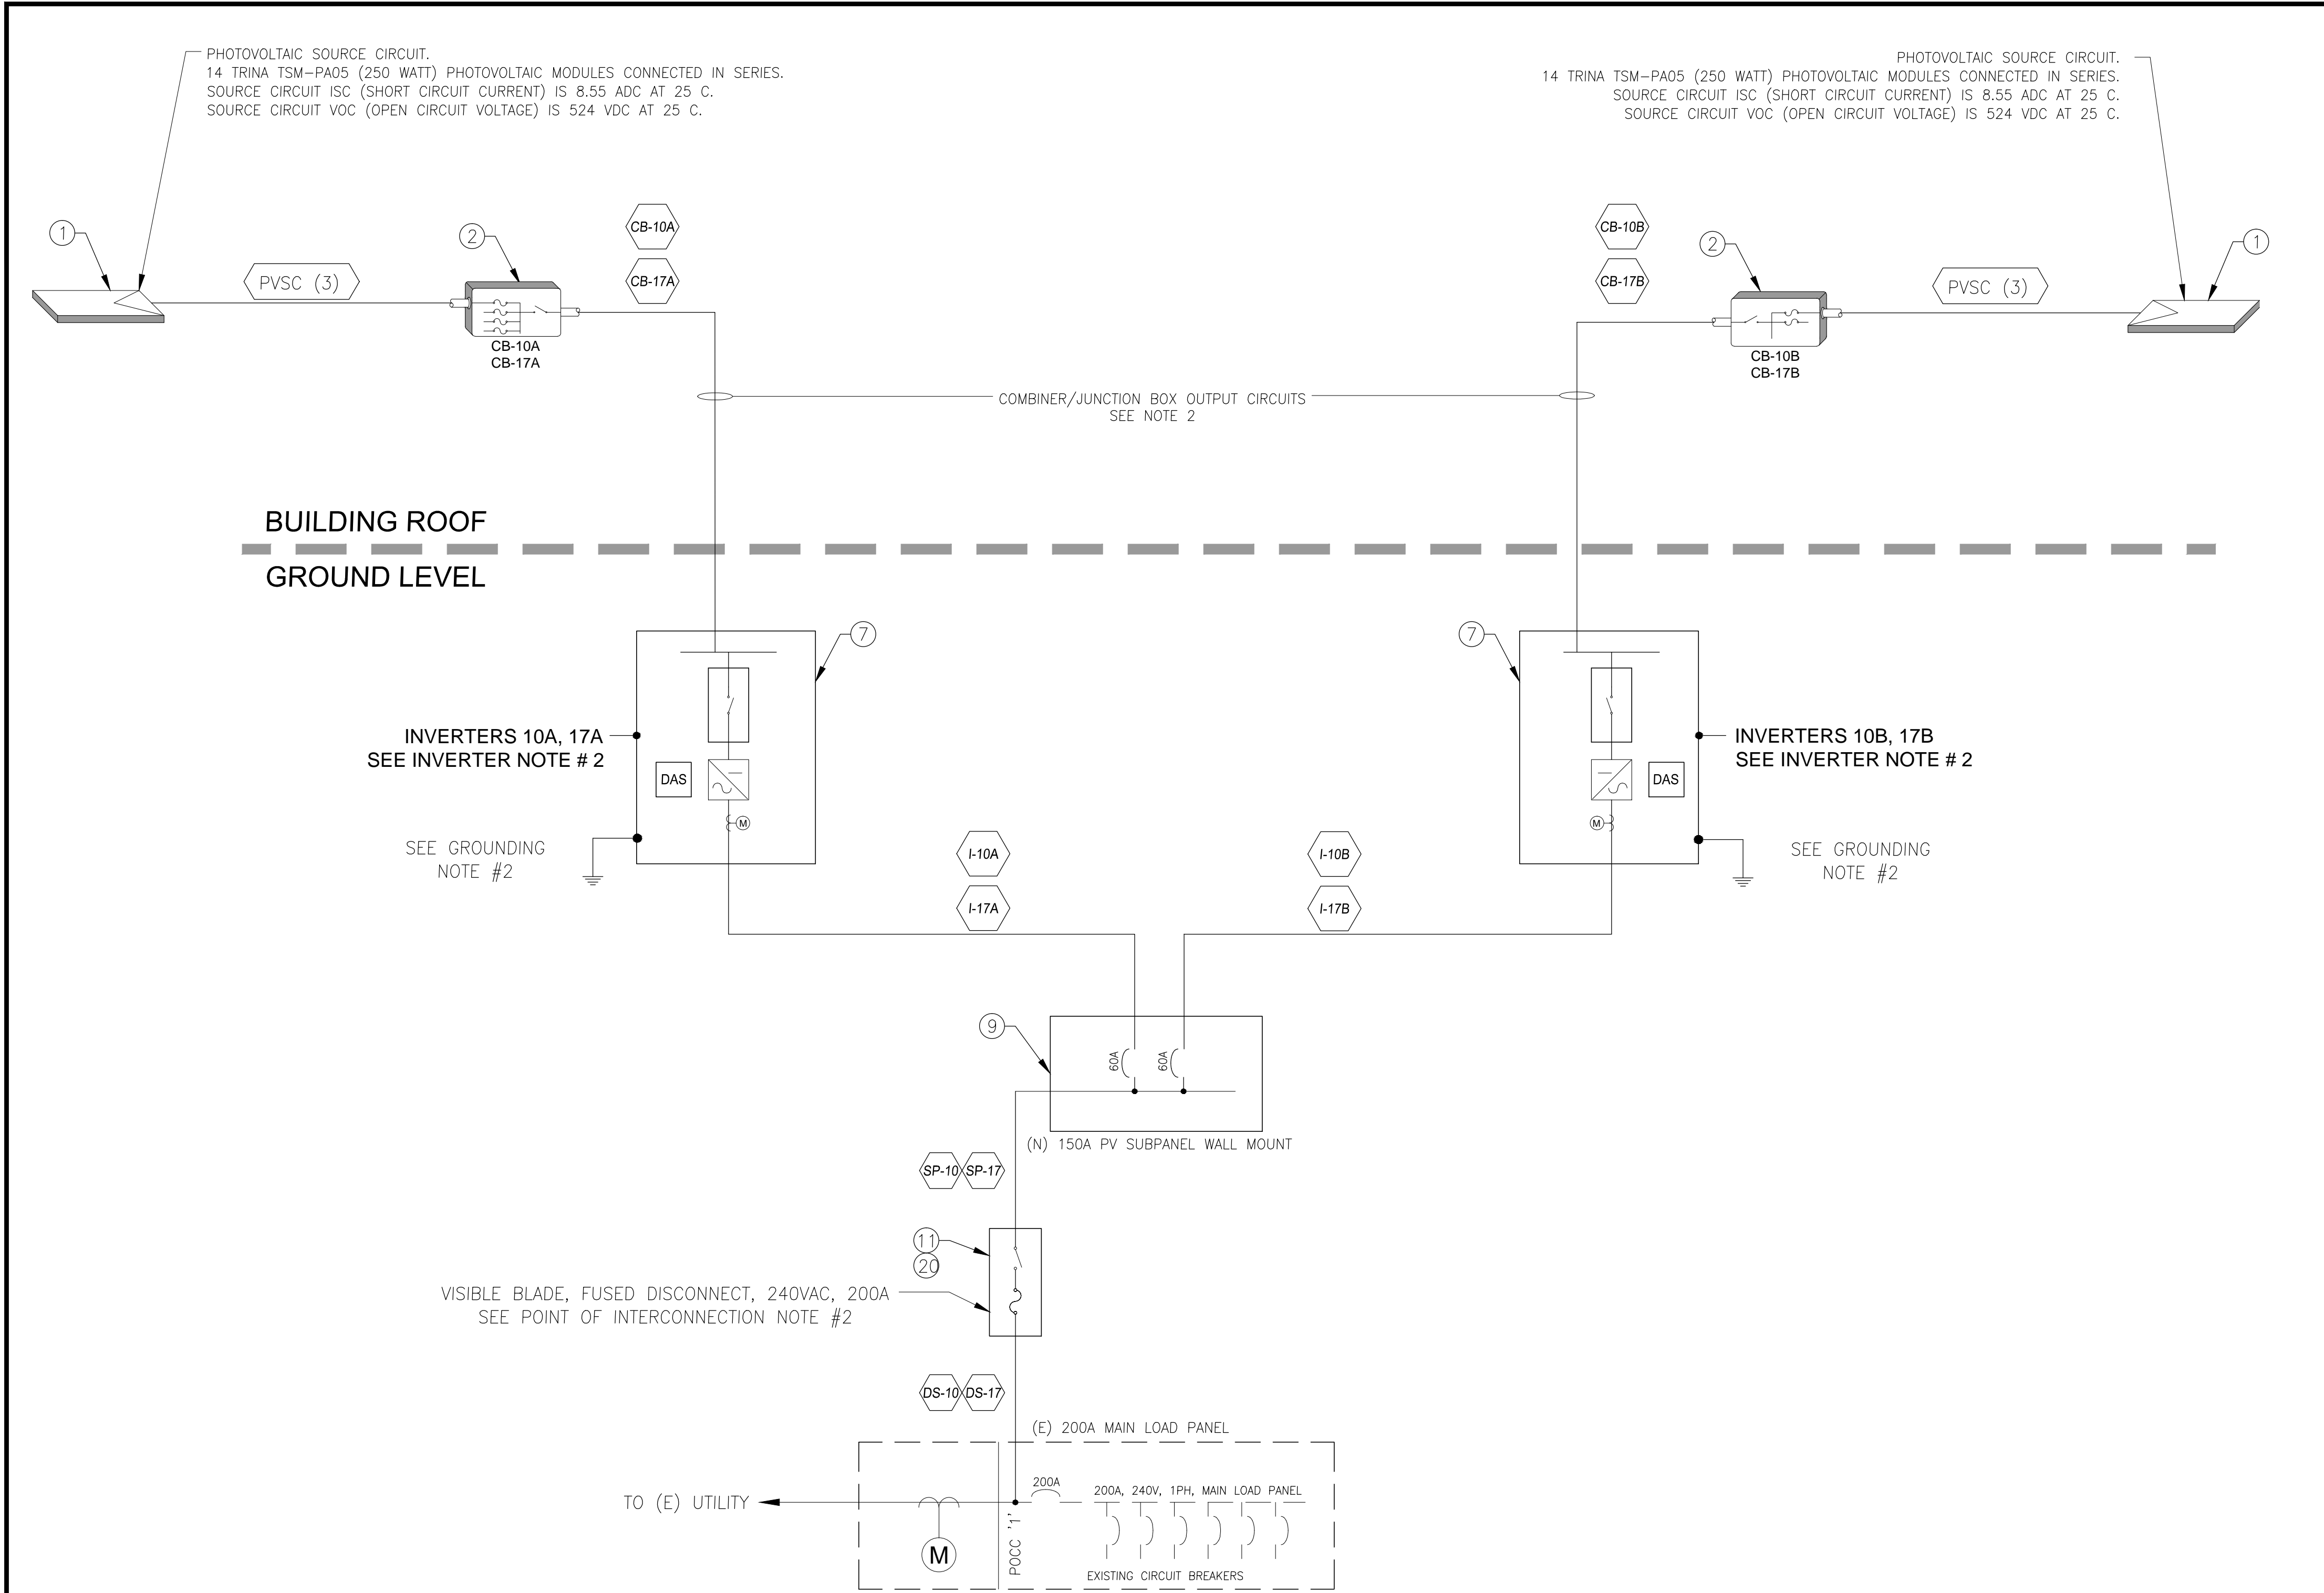

**SINGLE LINE DIAGRAM NOTES:**

1. ALL EQUIPMENT INSTALLED SHALL BE IN ACCORDANCE WITH ALL LOCAL AND ELECTRICAL BUILDING CODES. THE INSTALLATION SHALL CONFORM TO ALL LOCAL AND STATE SEISMIC REGULATIONS.
2. THE DC GROUNDING ELECTRODE CONDUCTOR SHALL BE BONDED WITH THE AC GROUNDING ELECTRODE.
3. COMBINER BOXES SHALL BE NEMA-4 ENCLOSURES OR BETTER.
4. ALL PV SOURCE CIRCUIT WIRES SHALL BE RHW/USE-2 SUNLIGHT RESISTANT OR XHHW-2.
5. #10-AWG BARE COPPER GROUND SHALL BE USED AS AN EQUIPMENT GROUND TO BOND THE MOUNTING SYSTEM TO THE OTHER PV SYSTEM EQUIPMENT AND TERMINATE IN THE COMBINER BOX. COMBINER BOX EQUIPMENT GROUND SHALL BE RUN IN SERIES AND TERMINATED IN THE INVERTER(S).

**GROUNDING NOTES:**

1. ALL BARE COPPER GROUND WIRING RUNNING BETWEEN ARRAYS SHALL BE PROTECTED FROM INADVERTENT DAMAGE BY BEING ROUTED INSIDE ACCEPTABLE CONDUIT OR WIREWAY. ALL CONDUITS OR WIREWAYS MUST BE NEATLY INSTALLED AND ATTACHED SECURELY TO THE MOUNTING SYSTEM.
2. THE GROUNDING ELECTRODE CONDUCTOR (GEC) ON THE AC SIDE OF THE SYSTEM SHALL BE TIED TO A CODE COMPLIANT GROUND ROD NEXT TO THE INVERTER OR AN EXISTING GEC POINT AT THE POCC.

**GENERAL EQUIPMENT NOTES:**

1. CIRCLE CALL-OUTS INDICATE BILL OF MATERIALS ITEM NUMBER AND IDENTIFY THE EQUIPMENT USED:
  - ② INDICATES ITEM 2, COMBINER BOX
  - ③ INDICATES ITEM 3, JUNCTION BOX
  - ④ THRU ⑧ INDICATES ITEMS 4-8, INVERTER
  - PVSC (3) INDICATES CIRCUIT TYPE AND NUMBER OF STRINGS
2. COMBINER/JUNCTION BOX OUTPUT CIRCUITS: EQUAL NUMBER OF CONDUCTORS FOR POSITIVE AND NEGATIVE COMBINER TERMINALS (1) 10-AWG GREEN EQUIPMENT GROUNDING CONDUCTOR (EGC) REFER TO TABLE 1A FOR OUTPUT CONDUCTOR AND CONDUIT SIZING
3. ALL CONDUCTORS ARE COPPER.
4. ALL ENCLOSURES ARE NEMA-4 UNLESS OTHERWISE NOTED.
5. EQUIPMENT SHALL BE INSTALLED IN ACCORDANCE WITH THE NEC AND ALL APPLICABLE REQUIREMENTS OF THE SERVING ELECTRICAL UTILITY COMPANY AND OF THE LOCAL AUTHORITY HAVING JURISDICTION.
6. COMBINER/JUNCTION BOXES ARE IDENTIFIED BY INVERTER DESIGNATION:  
INVERTER 10A & 17A: CB-10A & CB-17A  
INVERTER 10B & 17B: CB-10B & CB-17B
7. WHEN TRANSITIONING FROM RHW/USE-2 IN THE PV SOURCE CIRCUIT TO THHN/THWN-2, CONTRACTOR SHALL UTILIZE WATERTIGHT (NEMA-3R) JUNCTION BOX AND POLARIS CONNECTOR.

**INVERTER NOTES:**

1. INSTALLATION CONTRACTOR SHALL INSTALL COMBINER BOX OUTPUT CIRCUIT ON THE "COMBINED" INPUT CIRCUIT OF THE INVERTER. CONSULT INVERTER MANUAL FOR PROPER INSTALLATION OF REQUIRED CONNECTING DISTRIBUTORS.
2. INVERTERS ARE IDENTIFIED BY UNIT NUMBER AND LETTER. FOR UNITS 10 & 17 INVERTER DESIGNATIONS ARE: INV 10A/10B AND 17A/17B

**POINT OF INTERCONNECTION NOTES:**

1. CONNECT FUSED DISCONNECT TO BUS BAR ON LINE SIDE OF SERVICE PANEL. THIS IS A LINE SIDE TAP.
2. ATTACH PLACARDS PER APPLICABLE PLACARD SHEET INSTRUCTIONS.

| TABLE 1A - DC CIRCUIT SCHEDULE |      |     |          |      |             |        |           |                     |      |        |      |                 |       |
|--------------------------------|------|-----|----------|------|-------------|--------|-----------|---------------------|------|--------|------|-----------------|-------|
| CURRENT CARRYING CONDUCTOR     |      |     |          |      |             |        | GROUNDING |                     |      | OCPE   |      | CONDUIT/RACEWAY |       |
| CIRCUIT #                      | TYPE | QTY | DISTANCE | SIZE | INSULATION  | V DROP | SIZE      | INSULATION          | TYPE | RATING | TYPE | SIZE /TYPE      | %FILL |
| Source                         | PVSC | 1   | 100      | 10   | RHW/USE-2   | 0.50%  | #10       | BARE                | EGC  | 15     | Fuse | BACK OF MODULE  |       |
| CB-10A                         | CBOC | 1   | 140      | 6    | THWN/THHN-2 | 0.83%  | #10       | THWN/THHN-2 (GREEN) | EGC  | -      | -    | 1" EMT          | 40    |
| CB-10B                         | CBOC | 1   | 70       | 6    | THWN/THHN-2 | 0.42%  | #10       | THWN/THHN-2 (GREEN) | EGC  | -      | -    | 1" EMT          | 40    |

| TABLE 2A - AC CIRCUIT SCHEDULE |      |     |          |      |             |        |           |             |      |        |      |                 |       |
|--------------------------------|------|-----|----------|------|-------------|--------|-----------|-------------|------|--------|------|-----------------|-------|
| CURRENT CARRYING CONDUCTOR     |      |     |          |      |             |        | GROUNDING |             |      | OCPD   |      | CONDUIT/RACEWAY |       |
| CIRCUIT #                      | TYPE | QTY | DISTANCE | SIZE | INSULATION  | V DROP | SIZE      | INSULATION  | TYPE | RATING | TYPE | SIZE /TYPE      | %FILL |
| I-10A                          | IOC  | 3   | 10       | 6    | THWN/THHN-2 | 0.16%  | 8         | THWN/THHN-2 | EGC  | 60     | CB   | 1" EMT          | 40    |
| I-10B                          | IOC  | 3   | 10       | 6    | THWN/THHN-2 | 0.16%  | 8         | THWN/THHN-2 | EGC  | 60     | CB   | 1" EMT          | 40    |
| SP-10                          | IOC  | 3   | 25       | 2    | THWN/THHN-2 | 0.32%  | 8         | THWN/THHN-2 | EGC  | 110    | CB   | 1-1/2" EMT      | 40    |
| DS-10                          | IOC  | 3   | 25       | 2    | THWN/THHN-2 | 0.32%  | 8         | THWN/THHN-2 | EGC  | 110    | CB   | 1-1/2" EMT      | 40    |

| TABLE 1A - DC CIRCUIT SCHEDULE |      |     |          |      |             |        |           |                     |      |        |      |                 |       |
|--------------------------------|------|-----|----------|------|-------------|--------|-----------|---------------------|------|--------|------|-----------------|-------|
| CURRENT CARRYING CONDUCTOR     |      |     |          |      |             |        | GROUNDING |                     |      | OCPE   |      | CONDUIT/RACEWAY |       |
| CIRCUIT #                      | TYPE | QTY | DISTANCE | SIZE | INSULATION  | V DROP | SIZE      | INSULATION          | TYPE | RATING | TYPE | SIZE /TYPE      | %FILL |
| Source                         | PVSC | 1   | 100      | 10   | RHW/USE-2   | 0.50%  | #10       | BARE                | EGC  | 15     | Fuse | BACK OF MODULE  |       |
| CB-17A                         | CBOC | 1   | 70       | 8    | THWN/THHN-2 | 0.66%  | #10       | THWN/THHN-2 (GREEN) | EGC  | -      | -    | 1" EMT          | 40    |
| CB-17B                         | CBOC | 1   | 60       | 8    | THWN/THHN-2 | 0.57%  | #10       | THWN/THHN-2 (GREEN) | EGC  | -      | -    | 1" EMT          | 40    |

| TABLE 2A - AC CIRCUIT SCHEDULE |      |     |          |      |             |        |           |             |      |        |      |                 |       |
|--------------------------------|------|-----|----------|------|-------------|--------|-----------|-------------|------|--------|------|-----------------|-------|
| CURRENT CARRYING CONDUCTOR     |      |     |          |      |             |        | GROUNDING |             |      | OCPD   |      | CONDUIT/RACEWAY |       |
| CIRCUIT #                      | TYPE | QTY | DISTANCE | SIZE | INSULATION  | V DROP | SIZE      | INSULATION  | TYPE | RATING | TYPE | SIZE /TYPE      | %FILL |
| I-17A                          | IOC  | 3   | 10       | 6    | THWN/THHN-2 | 0.16%  | 8         | THWN/THHN-2 | EGC  | 60     | CB   | 1" EMT          | 40    |
| I-17B                          | IOC  | 3   | 10       | 6    | THWN/THHN-2 | 0.16%  | 8         | THWN/THHN-2 | EGC  | 60     | CB   | 1" EMT          | 40    |
| SP-17                          | IOC  | 3   | 25       | 2    | THWN/THHN-2 | 0.32%  | 8         | THWN/THHN-2 | EGC  | 110    | CB   | 1-1/2" EMT      | 40    |
| DS-17                          | IOC  | 3   | 25       | 2    | THWN/THHN-2 | 0.32%  | 8         | THWN/THHN-2 | EGC  | 110    | CB   | 1-1/2" EMT      | 40    |

ENGINEER APPROVAL:



ROBERTO RIVERA, P.E. NO. 16743

DATE: 09/10/12

| REV | DATE    | DESCRIPTION                |
|-----|---------|----------------------------|
| 1   | 9/10/12 | 100% CONSTRUCTION DRAWINGS |

PREPARED BY:



6977 NAVAJO RD., SUITE 139  
SAN DIEGO, CA 92119  
PHONE: 858.270.9333  
FAX: 858.270.9334

THIS DOCUMENT IS CONSIDERED PROTECTED  
INTELLECTUAL PROPERTY AND CONTAINS PROPRIETARY  
INFORMATION UNDER UNITED STATES LAW. NO PORTION OR  
PART OF THIS DOCUMENT MAY BE REPRODUCED FOR ANY  
PURPOSE WITHOUT THE EXPLICIT WRITTEN PERMISSION OF  
SUSTINEO CORP.

OWNER/CLIENT:

MADONNA ROAD APARTMENTS  
1550 MADONNA ROAD  
SAN LUIS OBISPO, CA 93405



EVERYDAY ENERGY  
5865 AVENIDA ENCINAS,  
SUITE 142A  
CARLSBAD, CA, 92008  
P: (760) 607-7200

SINGLE LINE DIAGRAM - UNITS 10 & 17

PHOTOVOLTAIC SYSTEM

PROJECT LOCATION:

1550 MADONNA ROAD  
SAN LUIS OBISPO, CA 93405

PROJECT NO.:

038 - 108

APN:

140-040-003

DATE:


SEPTEMBER 10, 2012

SHEET NO.:

E4.5

17 OF 30



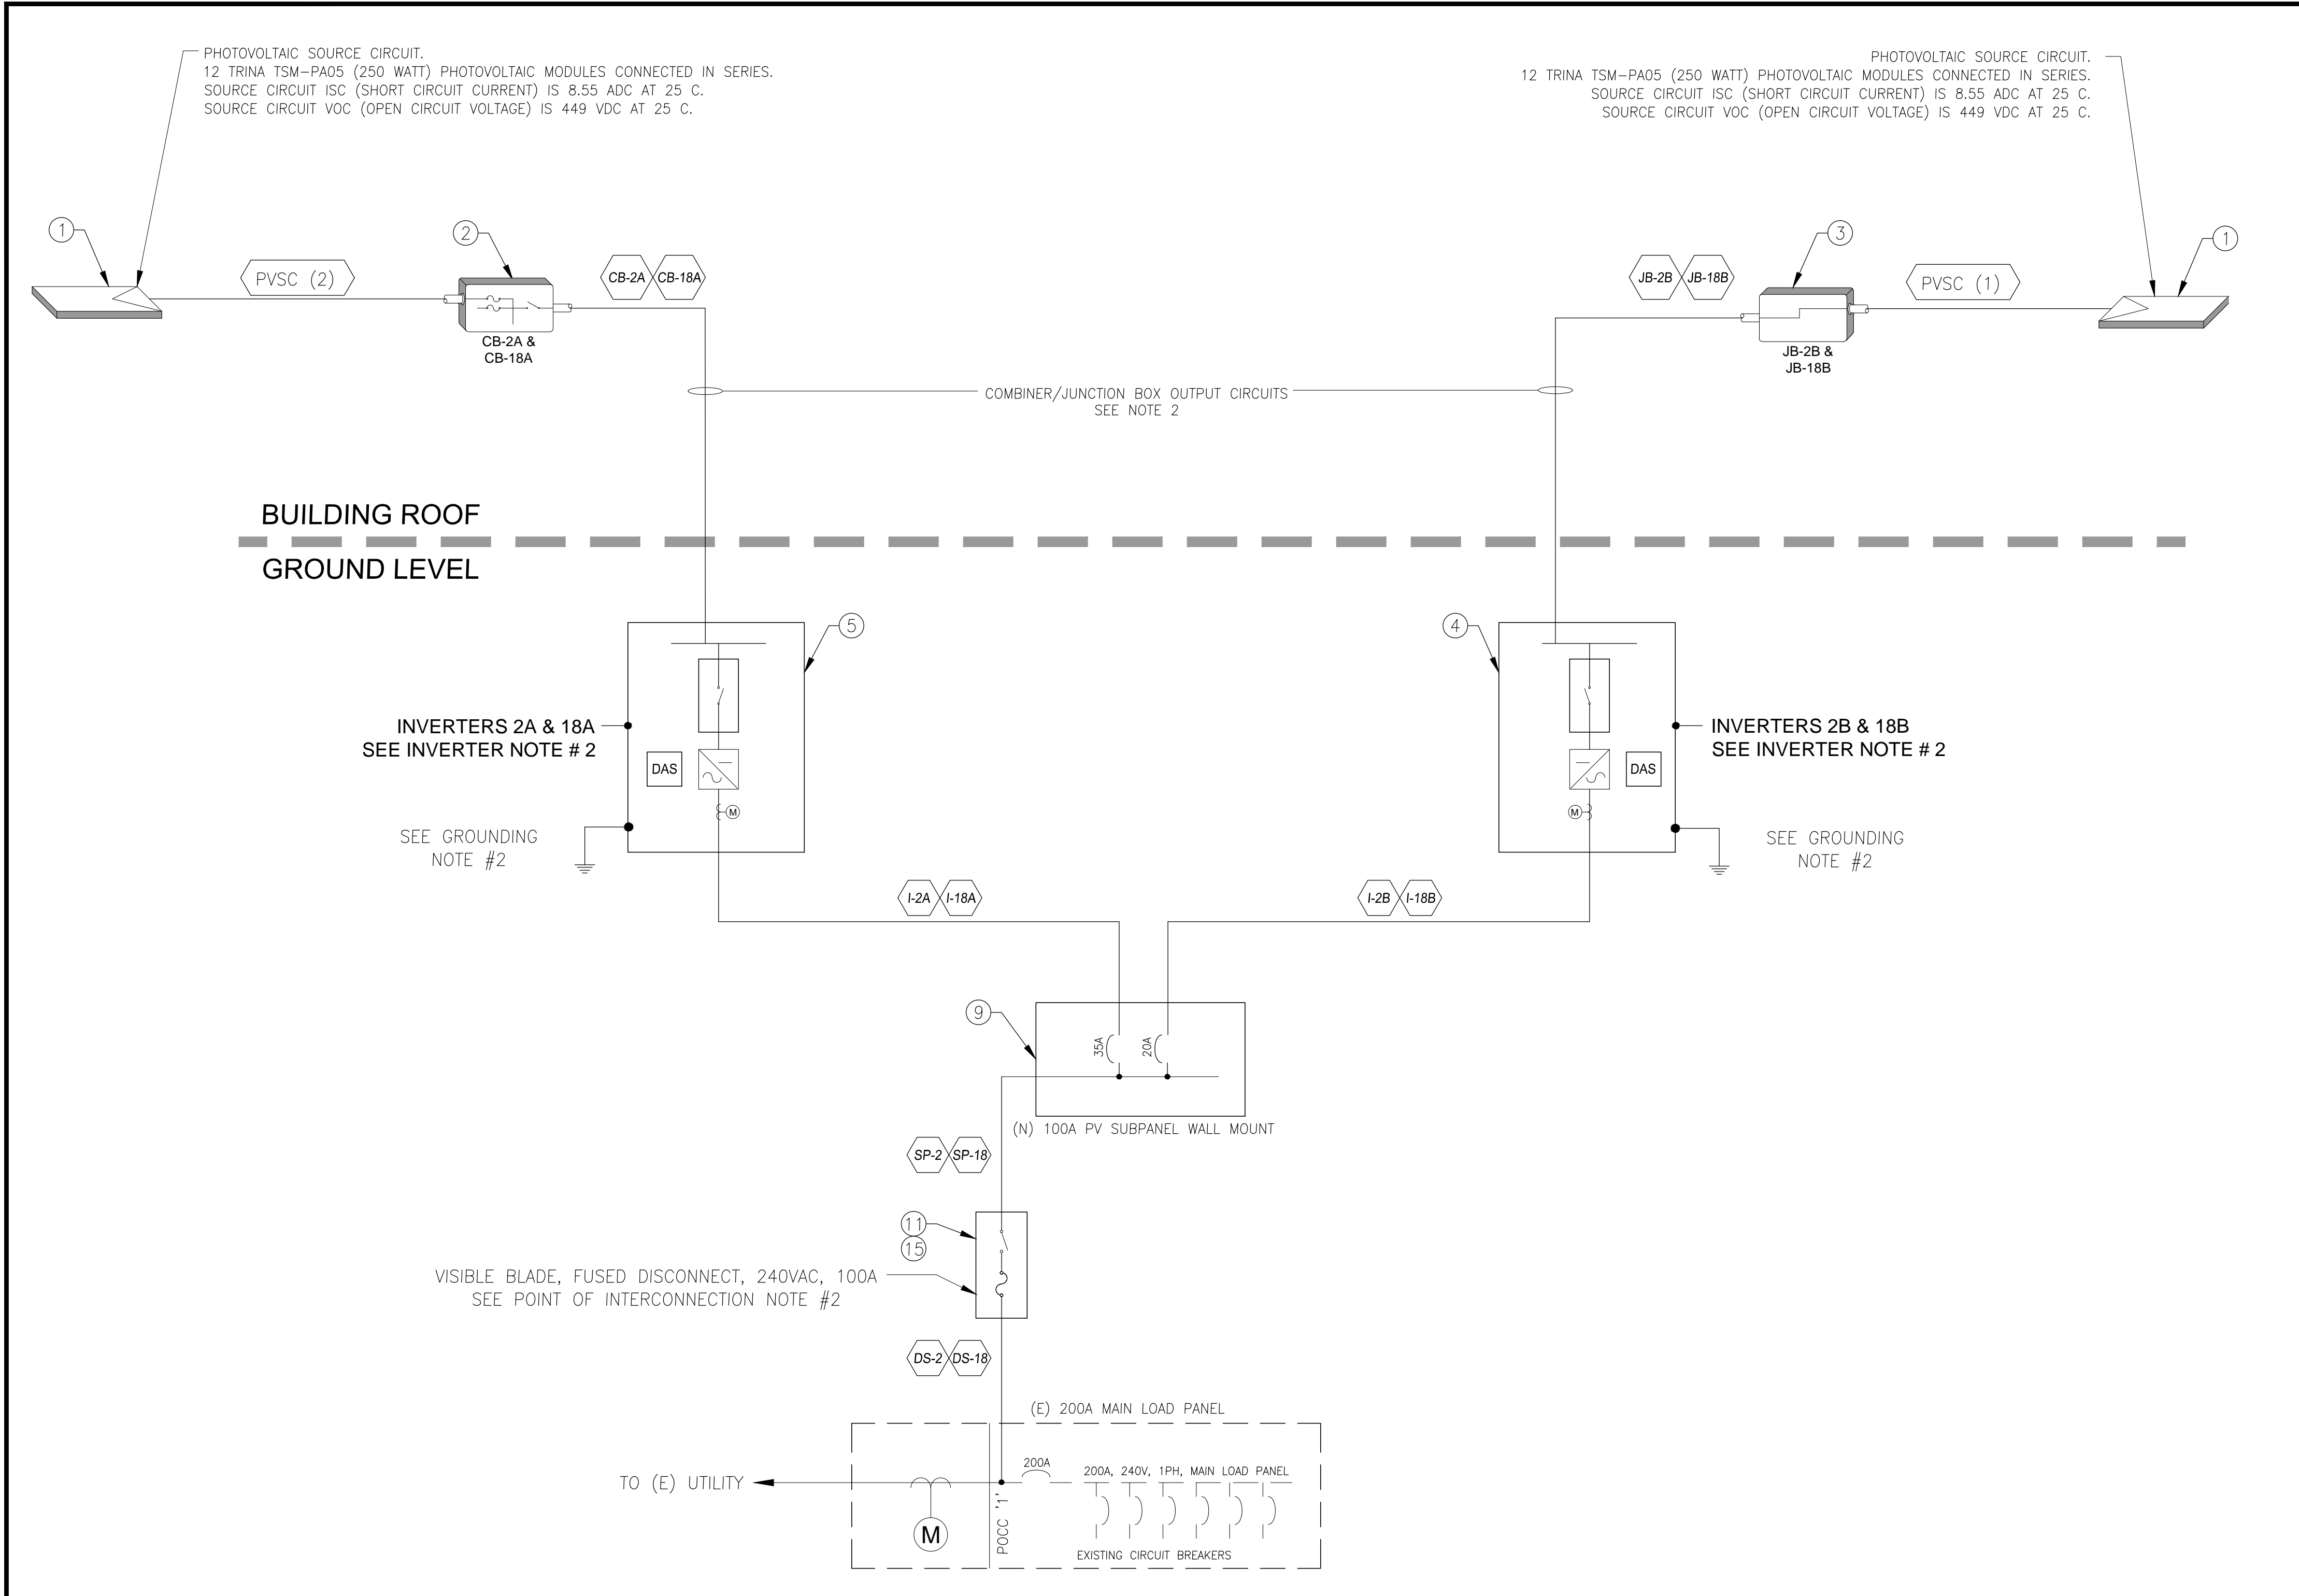

**SINGLE LINE DIAGRAM NOTES:**

1. ALL EQUIPMENT INSTALLED SHALL BE IN ACCORDANCE WITH ALL LOCAL AND ELECTRICAL BUILDING CODES. THE INSTALLATION SHALL CONFORM TO ALL LOCAL AND STATE SEISMIC REGULATIONS.
2. THE DC GROUNDING ELECTRODE CONDUCTOR SHALL BE BONDED WITH THE AC GROUNDING ELECTRODE.
3. COMBINER BOXES SHALL BE NEMA-4 ENCLOSURES OR BETTER.
4. ALL PV SOURCE CIRCUIT WIRES SHALL BE RHW/USE-2 SUNLIGHT RESISTANT OR XHHW-2.
5. #10-AWG BARE COPPER GROUND SHALL BE USED AS AN EQUIPMENT GROUND TO BOND THE MOUNTING SYSTEM TO THE OTHER PV SYSTEM EQUIPMENT AND TERMINATE IN THE COMBINER BOX. COMBINER BOX EQUIPMENT GROUND SHALL BE RUN IN SERIES AND TERMINATED IN THE INVERTER(S).

**GROUNDING NOTES:**

1. ALL BARE COPPER GROUND WIRING RUNNING BETWEEN ARRAYS SHALL BE PROTECTED FROM INADVERTENT DAMAGE BY BEING ROUTED INSIDE ACCEPTABLE CONDUIT OR WIREWAY. ALL CONDUITS OR WIREWAYS MUST BE NEATLY INSTALLED AND ATTACHED SECURELY TO THE MOUNTING SYSTEM.
2. THE GROUNDING ELECTRODE CONDUCTOR (GEC) ON THE AC SIDE OF THE SYSTEM SHALL BE TIED TO A CODE COMPLIANT GROUND ROD NEXT TO THE INVERTER OR AN EXISTING GEC POINT AT THE POCC.

**GENERAL EQUIPMENT NOTES:**

1. CIRCLE CALL-OUTS INDICATE BILL OF MATERIALS ITEM NUMBER AND IDENTIFY THE EQUIPMENT USED:
  - ② INDICATES ITEM 2, COMBINER BOX
  - ③ INDICATES ITEM 3, JUNCTION BOX
  - ④ THRU ⑧ INDICATES ITEMS 4-8, INVERTER
  - PVSC (3) INDICATES CIRCUIT TYPE AND NUMBER OF STRINGS
2. COMBINER/JUNCTION BOX OUTPUT CIRCUIT: EQUAL NUMBER OF CONDUCTORS FOR POSITIVE AND NEGATIVE COMBINER TERMINALS (1) 10-AWG GREEN EQUIPMENT GROUNDING CONDUCTOR (EGC) REFER TO TABLE 1A FOR OUTPUT CONDUCTOR AND CONDUIT SIZING
3. ALL CONDUCTORS ARE COPPER.
4. ALL ENCLOSURES ARE NEMA-4 UNLESS OTHERWISE NOTED.
5. EQUIPMENT SHALL BE INSTALLED IN ACCORDANCE WITH THE NEC AND ALL APPLICABLE REQUIREMENTS OF THE SERVING ELECTRICAL UTILITY COMPANY AND OF THE LOCAL AUTHORITY HAVING JURISDICTION.
6. COMBINER/JUNCTION BOXES ARE IDENTIFIED BY INVERTER DESIGNATION:
  - INVERTER 2A: CB-2A
  - INVERTER 2B: JB-2B
  - INVERTER 18A: CB-18A
  - INVERTER 18B: JB-18B
7. WHEN TRANSITIONING FROM RHW/USE-2 IN THE PV SOURCE CIRCUIT TO THHN/THWN-2, CONTRACTOR SHALL UTILIZE WATERTIGHT (NEMA-3R) JUNCTION BOX AND POLARIS CONNECTOR.

**INVERTER NOTES:**

1. INSTALLATION CONTRACTOR SHALL INSTALL COMBINER BOX OUTPUT CIRCUIT ON THE "COMBINED" INPUT CIRCUIT OF THE INVERTER. CONSULT INVERTER MANUAL FOR PROPER INSTALLATION OF REQUIRED CONNECTING DISTRIBUTORS.
2. INVERTERS ARE IDENTIFIED BY UNIT NUMBER AND LETTER. FOR UNITS 2 AND 18 INVERTER DESIGNATIONS ARE: INV 2A, 2B, 18A, AND 18B.

**POINT OF INTERCONNECTION NOTES:**

1. CONNECT FUSED DISCONNECT TO BUS BAR ON LINE SIDE OF SERVICE PANEL. THIS IS A LINE SIDE TAP.
2. ATTACH PLACARDS PER APPLICABLE PLACARD SHEET INSTRUCTIONS.

| TABLE 1A - DC CIRCUIT SCHEDULE |      |     |          |      |             |        |           |                     |      |        |      |                 |       |
|--------------------------------|------|-----|----------|------|-------------|--------|-----------|---------------------|------|--------|------|-----------------|-------|
| CURRENT CARRYING CONDUCTOR     |      |     |          |      |             |        | GROUNDING |                     |      | OCPD   |      | CONDUIT/RACEWAY |       |
| CIRCUIT #                      | TYPE | QTY | DISTANCE | SIZE | INSULATION  | V DROP | SIZE      | INSULATION          | TYPE | RATING | TYPE | SIZE / TYPE     | %FILL |
| Source                         | PVSC | 1   | 100      | 10   | RHW/USE-2   | 0.59%  | #10       | BARE                | EGC  | 15     | Fuse | BACK OF MODULE  |       |
| CB-2A                          | CBOC | 1   | 45       | 8    | THWN/THHN-2 | 0.33%  | #10       | THWN/THHN-2 (GREEN) | EGC  | -      | -    | 1" EMT          | 40    |
| JB-2B                          | CBOC | 1   | 70       | 10   | THWN/THHN-2 | 0.41%  | #10       | THWN/THHN-2 (GREEN) | EGC  | -      | -    | 1" EMT          | 40    |

| TABLE 2A - AC CIRCUIT SCHEDULE |      |     |          |      |             |        |           |             |      |        |      |                 |       |
|--------------------------------|------|-----|----------|------|-------------|--------|-----------|-------------|------|--------|------|-----------------|-------|
| CURRENT CARRYING CONDUCTOR     |      |     |          |      |             |        | GROUNDING |             |      | OCPD   |      | CONDUIT/RACEWAY |       |
| CIRCUIT #                      | TYPE | QTY | DISTANCE | SIZE | INSULATION  | V DROP | SIZE      | INSULATION  | TYPE | RATING | TYPE | SIZE / TYPE     | %FILL |
| I-2A                           | IOC  | 3   | 10       | 10   | THWN/THHN-2 | 0.24%  | 8         | THWN/THHN-2 | EGC  | 35     | CB   | 1" EMT          | 40    |
| I-2B                           | IOC  | 3   | 10       | 10   | THWN/THHN-2 | 0.12%  | 8         | THWN/THHN-2 | EGC  | 20     | CB   | 1" EMT          | 40    |
| SP-2                           | IOC  | 3   | 25       | 8    | THWN/THHN-2 | 0.57%  | 8         | THWN/THHN-2 | EGC  | 50     | CB   | 1" EMT          | 40    |
| DS-2                           | IOC  | 3   | 25       | 8    | THWN/THHN-2 | 0.57%  | 8         | THWN/THHN-2 | EGC  | 50     | CB   | 1" EMT          | 40    |

| TABLE 1A - DC CIRCUIT SCHEDULE |      |     |          |      |             |        |           |                     |      |        |      |                 |       |
|--------------------------------|------|-----|----------|------|-------------|--------|-----------|---------------------|------|--------|------|-----------------|-------|
| CURRENT CARRYING CONDUCTOR     |      |     |          |      |             |        | GROUNDING |                     |      | OCPE   |      | CONDUIT/RACEWAY |       |
| CIRCUIT #                      | TYPE | QTY | DISTANCE | SIZE | INSULATION  | V DROP | SIZE      | INSULATION          | TYPE | RATING | TYPE | SIZE / TYPE     | %FILL |
| Source                         | PVSC | 1   | 100      | 10   | RHW/USE-2   | 0.50%  | #10       | BARE                | EGC  | 15     | Fuse | BACK OF MODULE  |       |
| CB-10A                         | CBOC | 1   | 140      | 6    | THWN/THHN-2 | 0.83%  | #10       | THWN/THHN-2 (GREEN) | EGC  | -      | -    | 1" EMT          | 40    |
| CB-10B                         | CBOC | 1   | 70       | 6    | THWN/THHN-2 | 0.42%  | #10       | THWN/THHN-2 (GREEN) | EGC  | -      | -    | 1" EMT          | 40    |

| TABLE 2A - AC CIRCUIT SCHEDULE |      |     |          |      |             |        |           |             |      |        |      |                 |       |
|--------------------------------|------|-----|----------|------|-------------|--------|-----------|-------------|------|--------|------|-----------------|-------|
| CURRENT CARRYING CONDUCTOR     |      |     |          |      |             |        | GROUNDING |             |      | OCPD   |      | CONDUIT/RACEWAY |       |
| CIRCUIT #                      | TYPE | QTY | DISTANCE | SIZE | INSULATION  | V DROP | SIZE      | INSULATION  | TYPE | RATING | TYPE | SIZE / TYPE     | %FILL |
| I-10A                          | IOC  | 3   | 10       | 6    | THWN/THHN-2 | 0.16%  | 8         | THWN/THHN-2 | EGC  | 60     | CB   | 1" EMT          | 40    |
| I-10B                          | IOC  | 3   | 10       | 6    | THWN/THHN-2 | 0.16%  | 8         | THWN/THHN-2 | EGC  | 60     | CB   | 1" EMT          | 40    |
| SP-10                          | IOC  | 3   | 25       | 2    | THWN/THHN-2 | 0.32%  | 8         | THWN/THHN-2 | EGC  | 110    | CB   | 1-1/2" EMT      | 40    |
| DS-10                          | IOC  | 3   | 25       | 2    | THWN/THHN-2 | 0.32%  | 8         | THWN/THHN-2 | EGC  | 110    | CB   | 1-1/2" EMT      | 40    |

ENGINEER APPROVAL:

REGISTERED PROFESSIONAL ENGINEER  
ROBERTO RIVERA  
NO. 16743  
Exp. 9/30/12  
ELECTRICAL  
STATE OF CALIFORNIA

ROBERTO RIVERA, P.E. NO. 16743  
DATE: 09/10/12

100% CONSTRUCTION DRAWINGS

PREPARED BY:

6977 NAVAJO RD., SUITE 139  
SAN DIEGO, CA 92119  
PHONE: 858.270.9333  
FAX: 858.270.9334

THIS DOCUMENT IS CONSIDERED PROTECTED  
INTELLECTUAL PROPERTY AND CONTAINS PROPRIETARY  
INFORMATION UNDER UNITED STATES LAW. NO PORTION OR  
PART OF THIS DOCUMENT MAY BE REPRODUCED FOR ANY  
PURPOSE WITHOUT THE EXPLICIT WRITTEN PERMISSION OF  
SUSTINEO CORP.

OWNER/CLIENT:

MADONNA ROAD APARTMENTS  
1550 MADONNA ROAD  
SAN LUIS OBISPO, CA 93405

EVERYDAY ENERGY  
5865 AVENIDA ENCINAS,  
SUITE 142A  
CARLSBAD, CA, 92008  
P: (760) 607-7200

TITLE:

SINGLE LINE DIAGRAM - UNITS 2 & 18  
PHOTOVOLTAIC SYSTEM

PROJECT LOCATION:

1550 MADONNA ROAD  
SAN LUIS OBISPO, CA 93405

PROJECT NO.: 038 - 108  
APN: 140-040-003  
DATE: SEPTEMBER 10, 2012  
SHEET NO.: **E4.6**  
18 OF 30

100% CONSTRUCTION DRAWINGS



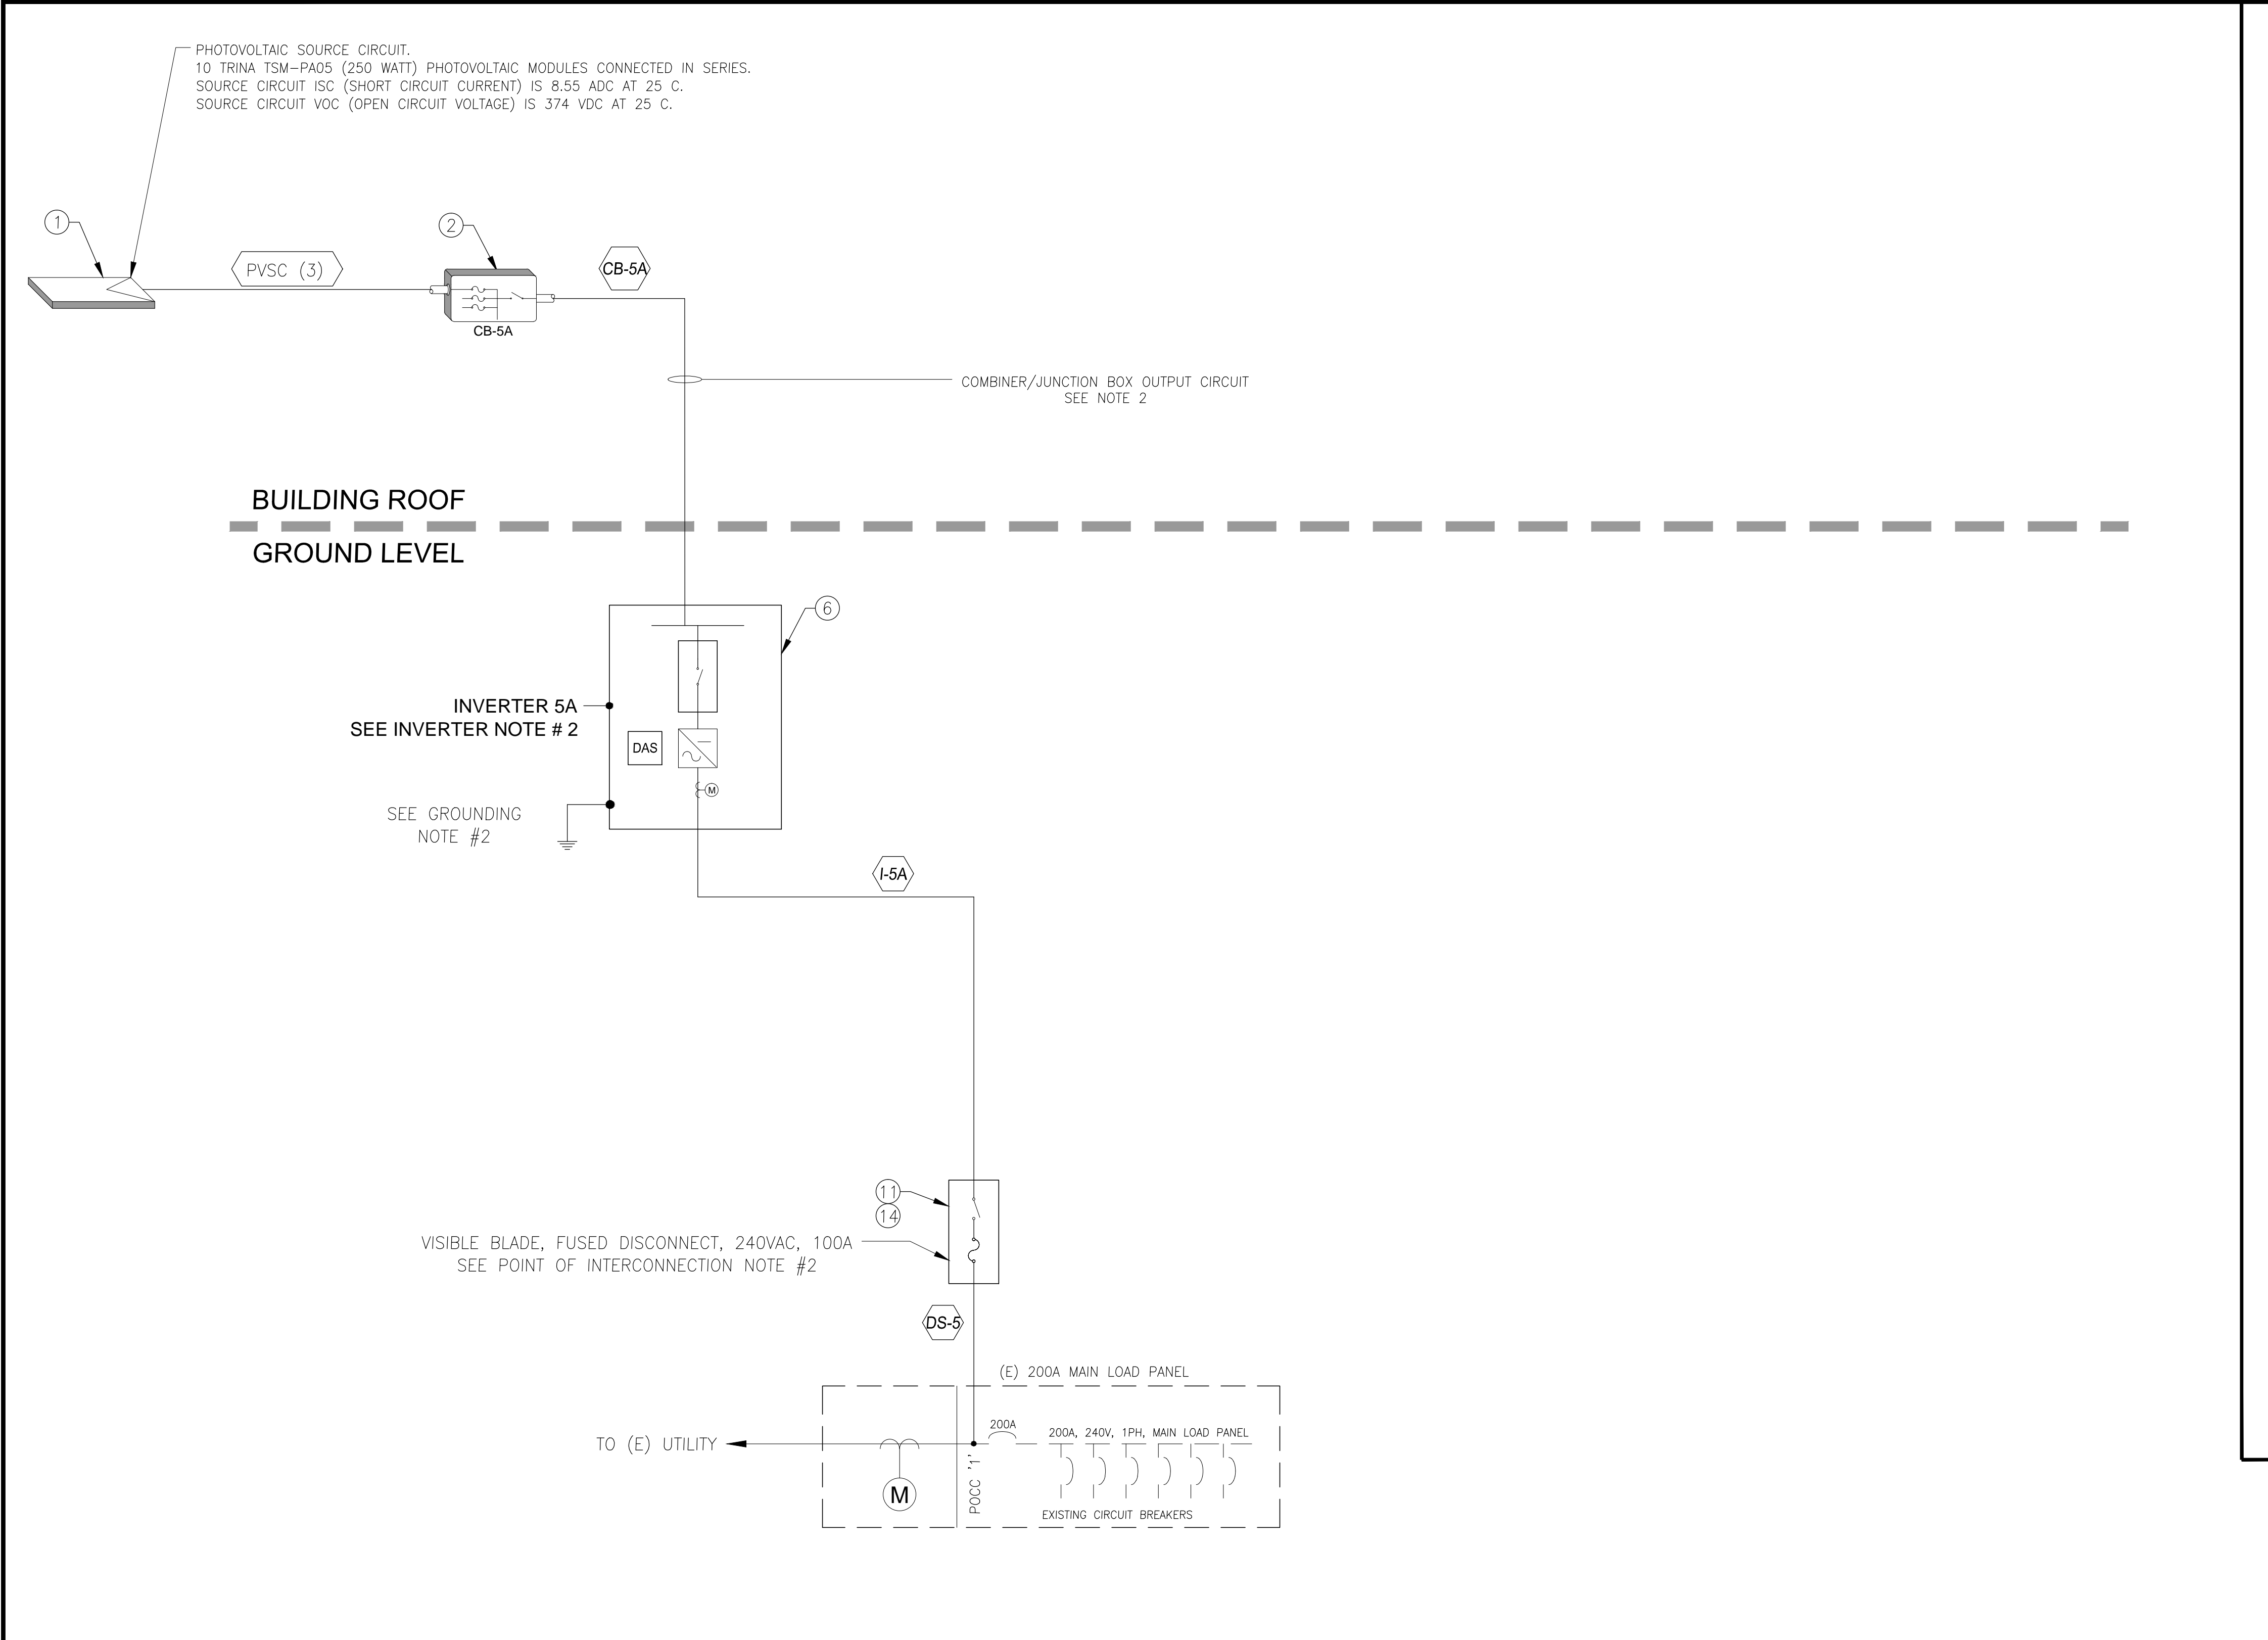


TABLE 1A - DC CIRCUIT SCHEDULE

| CURRENT CARRYING CONDUCTOR |      |     |          |      |             |        | GROUNDING |                     |      | OCPE   |      | CONDUIT/RACEWAY |       |
|----------------------------|------|-----|----------|------|-------------|--------|-----------|---------------------|------|--------|------|-----------------|-------|
| CIRCUIT #                  | TYPE | QTY | DISTANCE | SIZE | INSULATION  | V DROP | SIZE      | INSULATION          | TYPE | RATING | TYPE | SIZE /TYPE      | %FILL |
| Source                     | PVSC | 1   | 100      | 10   | RHW/USE-2   | 0.70%  | #10       | BARE                | EGC  | 15     | Fuse | BACK OF MODULE  |       |
| CB-5A                      | CBOC | 1   | 70       | 6    | THWN/THHN-2 | 0.58%  | #10       | THWN/THHN-2 (GREEN) | EGC  | -      | -    | 1" EMT          | 40    |

TABLE 2A - AC CIRCUIT SCHEDULE

| CURRENT CARRYING CONDUCTOR |      |     |          |      |             |        | GROUNDING |             |      | OCPD   |      | CONDUIT/RACEWAY |       |
|----------------------------|------|-----|----------|------|-------------|--------|-----------|-------------|------|--------|------|-----------------|-------|
| CIRCUIT #                  | TYPE | QTY | DISTANCE | SIZE | INSULATION  | V DROP | SIZE      | INSULATION  | TYPE | RATING | TYPE | SIZE /TYPE      | %FILL |
| I-5A                       | IOC  | 3   | 10       | 8    | THWN/THHN-2 | 0.19%  | 8         | THWN/THHN-2 | EGC  | 40     | CB   | 1" EMT          | 40    |
| DS-5                       | IOC  | 3   | 10       | 8    | THWN/THHN-2 | 0.19%  | 8         | THWN/THHN-2 | EGC  | 40     | CB   | 1" EMT          | 40    |

SINGLE LINE DIAGRAM NOTES:

- ALL EQUIPMENT INSTALLED SHALL BE IN ACCORDANCE WITH ALL LOCAL AND ELECTRICAL BUILDING CODES. THE INSTALLATION SHALL CONFORM TO ALL LOCAL AND STATE SEISMIC REGULATIONS.
- THE DC GROUNDING ELECTRODE CONDUCTOR SHALL BE BONDED WITH THE AC GROUNDING ELECTRODE.
- COMBINER BOXES SHALL BE NEMA-4 ENCLOSURES OR BETTER.
- ALL PV SOURCE CIRCUIT WIRES SHALL BE RHW/USE-2 SUNLIGHT RESISTANT OR XHHW-2.
- #10-AWG BARE COPPER GROUND SHALL BE USED AS AN EQUIPMENT GROUND TO BOND THE MOUNTING SYSTEM TO THE OTHER PV SYSTEM EQUIPMENT AND TERMINATE IN THE COMBINER BOX. COMBINER BOX EQUIPMENT GROUND SHALL BE RUN IN SERIES AND TERMINATED IN THE INVERTER(S).

GROUNDING NOTES:

- ALL BARE COPPER GROUND WIRING RUNNING BETWEEN ARRAYS SHALL BE PROTECTED FROM INADVERTENT DAMAGE BY BEING ROUTED INSIDE ACCEPTABLE CONDUIT OR WIREWAY. ALL CONDUITS OR WIREWAYS MUST BE NEATLY INSTALLED AND ATTACHED SECURELY TO THE MOUNTING SYSTEM.
- THE GROUNDING ELECTRODE CONDUCTOR (GEC) ON THE AC SIDE OF THE SYSTEM SHALL BE TIED TO A CODE COMPLIANT GROUND ROD NEXT TO THE INVERTER OR AN EXISTING GEC POINT AT THE POCC.

GENERAL EQUIPMENT NOTES:

- CIRCLE CALL-OUTS INDICATE BILL OF MATERIALS ITEM NUMBER AND IDENTIFY THE EQUIPMENT USED:

- 2 INDICATES ITEM 2, COMBINER BOX
- 3 INDICATES ITEM 3, JUNCTION BOX
- 4 THRU 8 INDICATES ITEMS 4-8, INVERTER
- PVSC (3) INDICATES CIRCUIT TYPE AND NUMBER OF STRINGS

- COMBINER/JUNCTION BOX OUTPUT CIRCUITS: EQUAL NUMBER OF CONDUCTORS FOR POSITIVE AND NEGATIVE COMBINER TERMINALS (1) 10-AWG GREEN EQUIPMENT GROUNDING CONDUCTOR (EGC) REFER TO TABLE 1A FOR OUTPUT CONDUCTOR AND CONDUIT SIZING
- ALL CONDUCTORS ARE COPPER.
- ALL ENCLOSURES ARE NEMA-4 UNLESS OTHERWISE NOTED.
- EQUIPMENT SHALL BE INSTALLED IN ACCORDANCE WITH THE NEC AND ALL APPLICABLE REQUIREMENTS OF THE SERVING ELECTRICAL UTILITY COMPANY AND OF THE LOCAL AUTHORITY HAVING JURISDICTION.
- COMBINER/JUNCTION BOXES ARE IDENTIFIED BY INVERTER DESIGNATION:  
INVERTER 5A: CB-5A  
INVERTER 5B: CB-5B
- WHEN TRANSITIONING FROM RHW/USE-2 IN THE PV SOURCE CIRCUIT TO THHN/THWN-2, CONTRACTOR SHALL UTILIZE WATERTIGHT (NEMA-3R) JUNCTION BOX AND POLARIS CONNECTOR.

INVERTER NOTES:

- INSTALLATION CONTRACTOR SHALL INSTALL COMBINER BOX OUTPUT CIRCUIT ON THE "COMBINED" INPUT CIRCUIT OF THE INVERTER. CONSULT INVERTER MANUAL FOR PROPER INSTALLATION OF REQUIRED CONNECTING DISTRIBUTORS.
- INVERTERS ARE IDENTIFIED BY UNIT NUMBER AND LETTER. FOR UNIT 5  
INVERTER DESIGNATION IS: INV 5A

POINT OF INTERCONNECTION NOTES:

- CONNECT FUSED DISCONNECT TO BUS BAR ON LINE SIDE OF SERVICE PANEL.  
THIS IS A LINE SIDE TAP.
- ATTACH PLACARDS PER APPLICABLE PLACARD SHEET INSTRUCTIONS.

ENGINEER APPROVAL:



Roberto Rivera

ROBERTO RIVERA, P.E. NO. 16743

09/10/12

DATE:

| REV | DATE    | DESCRIPTION                |
|-----|---------|----------------------------|
| 1   | 9/10/12 | 100% CONSTRUCTION DRAWINGS |

PREPARED BY:



6977 NAVAJO RD., SUITE 139  
SAN DIEGO, CA 92119  
PHONE: 858.270.9333  
FAX: 858.270.9334

THIS DOCUMENT IS CONSIDERED PROTECTED  
INTELLECTUAL PROPERTY AND CONTAINS PROPRIETARY  
INFORMATION UNDER UNITED STATES LAW. NO PORTION OR  
PART OF THIS DOCUMENT MAY BE REPRODUCED FOR ANY  
PURPOSE WITHOUT THE EXPLICIT WRITTEN PERMISSION OF  
SUSTINEO CORP.

OWNER/CLIENT:

MADONNA ROAD APARTMENTS  
1550 MADONNA ROAD  
SAN LUIS OBISPO, CA 93405



EVERYDAY ENERGY  
5865 AVENIDA ENCINAS,  
SUITE 142A  
CARLSBAD, CA, 92008  
P: (760) 607-7200

TITLE:

SINGLE LINE DIAGRAM - UNIT 5

PHOTOVOLTAIC SYSTEM

PROJECT LOCATION:

1550 MADONNA ROAD  
SAN LUIS OBISPO, CA 93405

PROJECT NO.:

038 - 108

APN:

140-040-003

DATE:


SEPTEMBER 10, 2012

SHEET NO.:

E4.7

19 OF 30



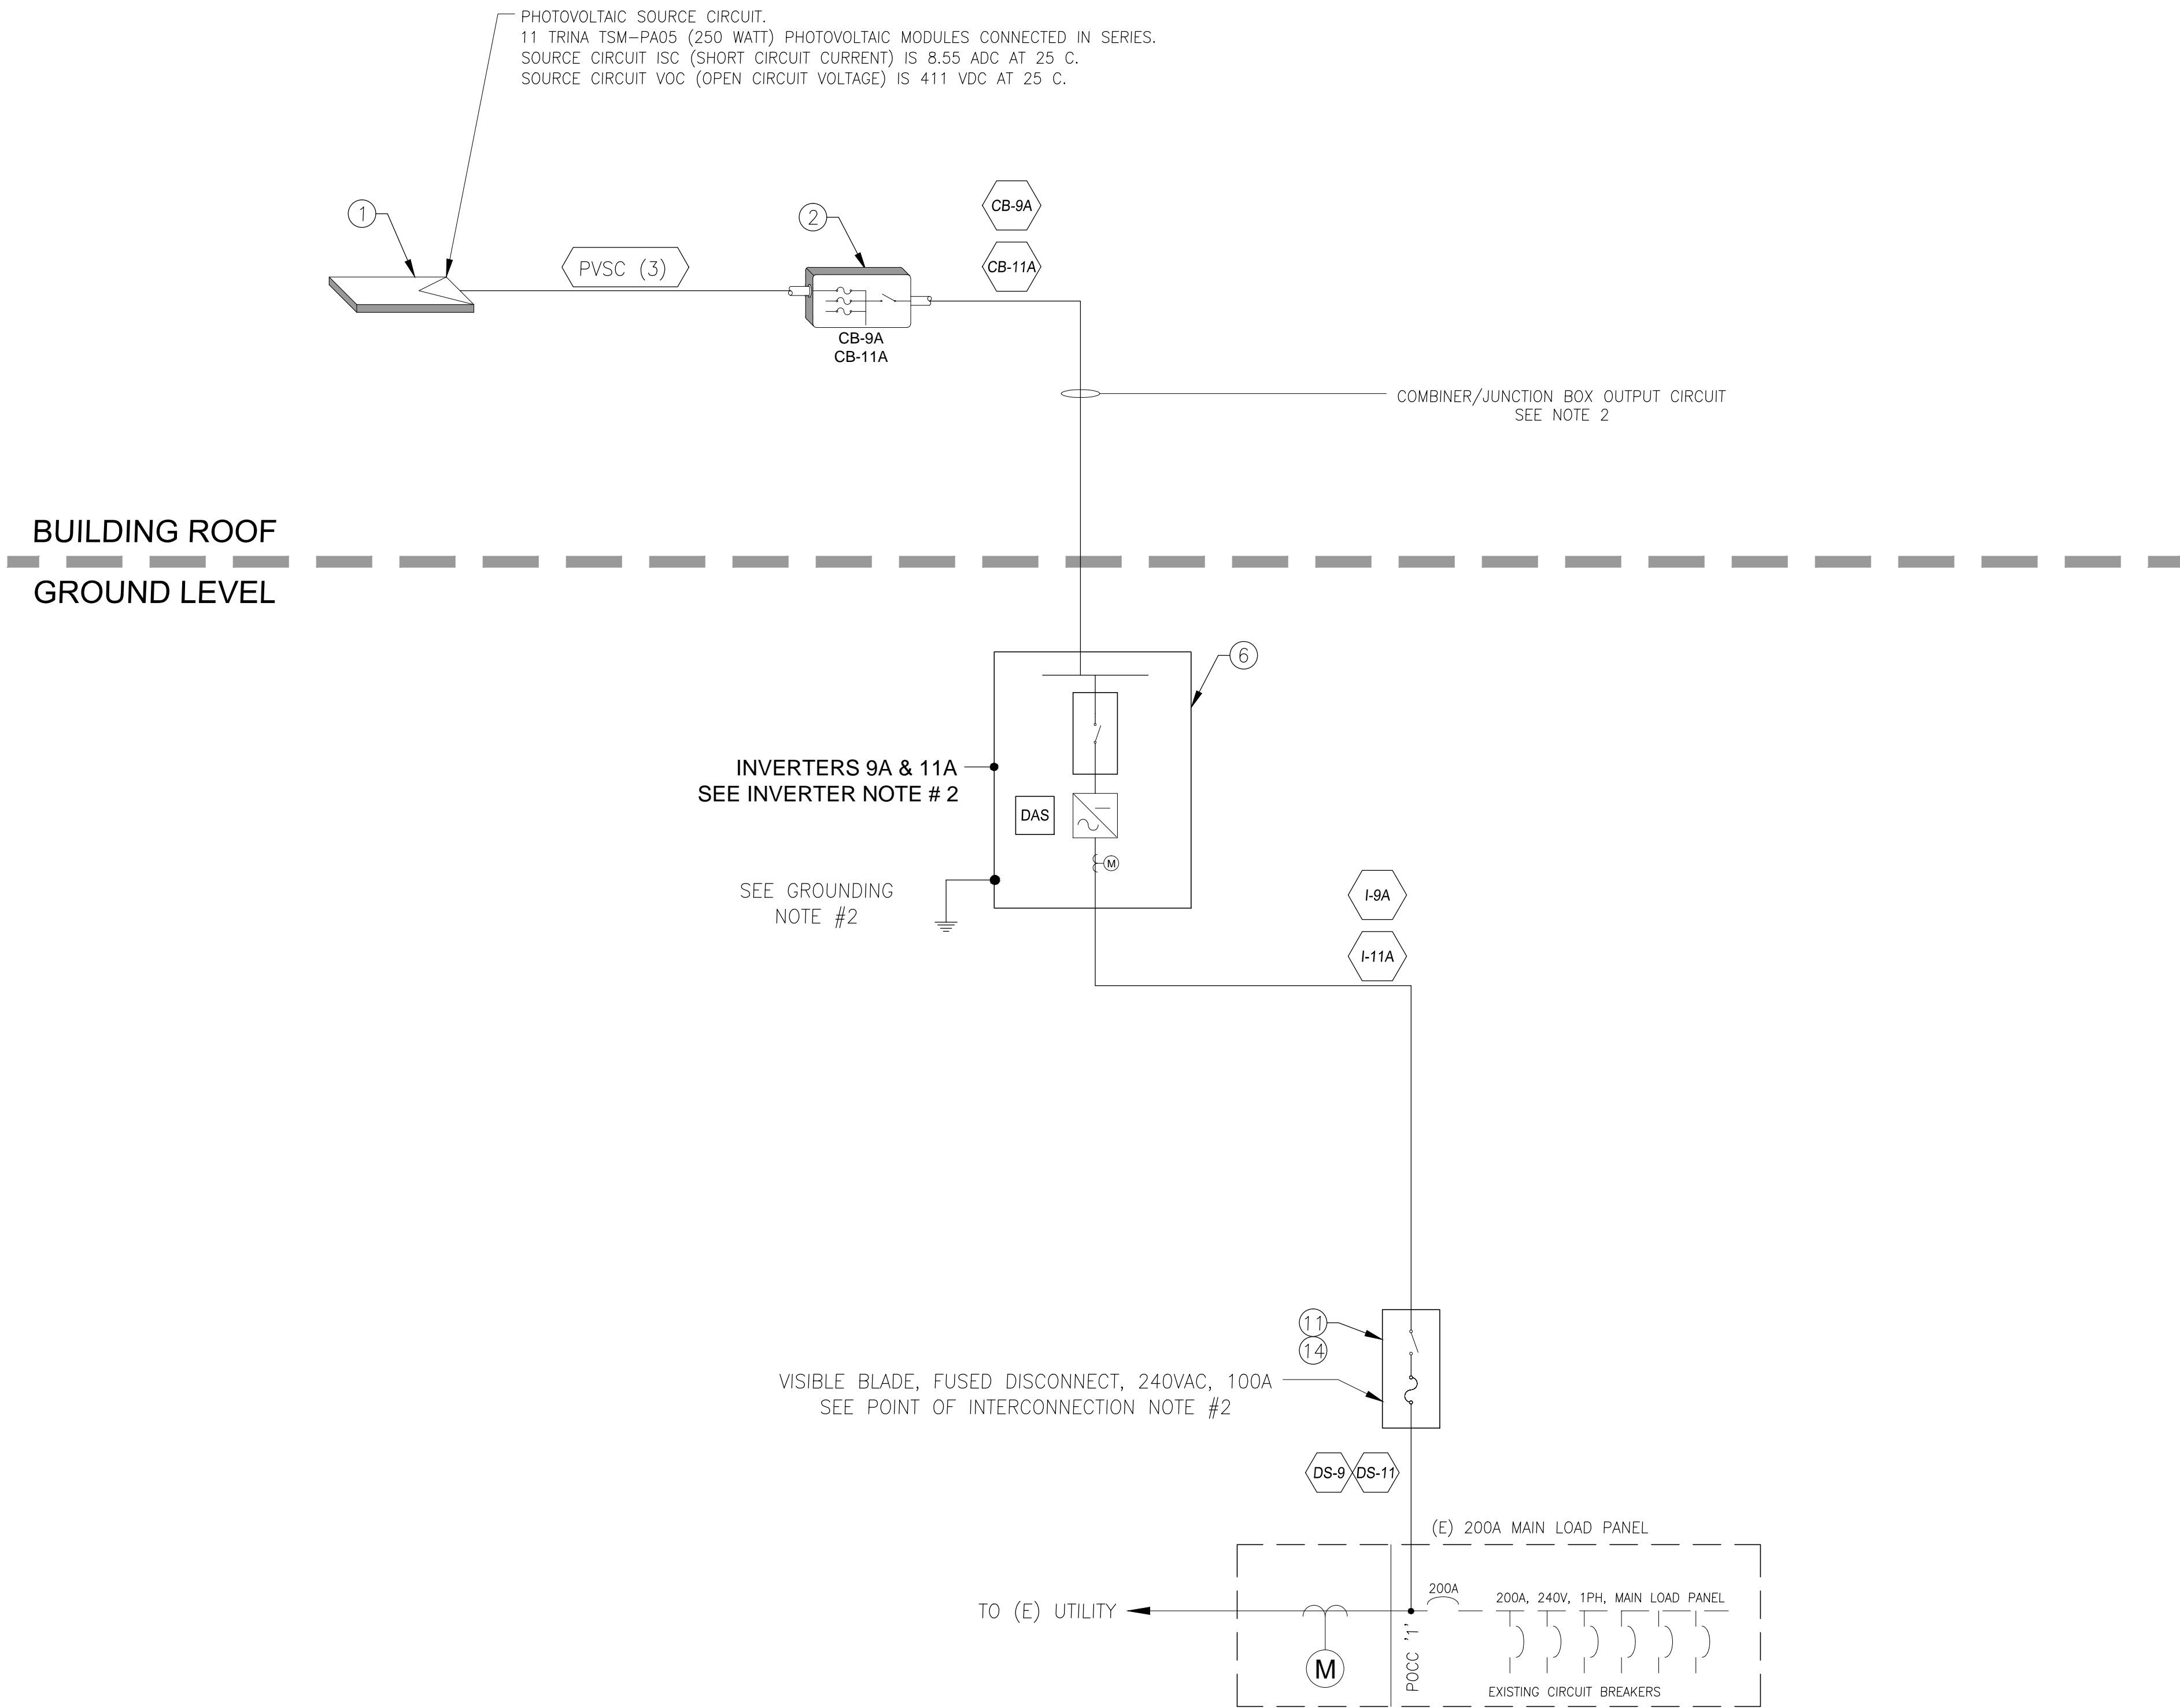

SINGLE LINE DIAGRAM NOTES:

1. ALL EQUIPMENT INSTALLED SHALL BE IN ACCORDANCE WITH ALL LOCAL AND ELECTRICAL BUILDING CODES. THE INSTALLATION SHALL CONFORM TO ALL LOCAL AND STATE SEISMIC REGULATIONS.
2. THE DC GROUNDING ELECTRODE CONDUCTOR SHALL BE BONDED WITH THE AC GROUNDING ELECTRODE.
3. COMBINER BOXES SHALL BE NEMA-4 ENCLOSURES OR BETTER.
4. ALL PV SOURCE CIRCUIT WIRES SHALL BE RHW/USE-2 SUNLIGHT RESISTANT OR XHHW-2.
5. #10-AWG BARE COPPER GROUND SHALL BE USED AS AN EQUIPMENT GROUND TO BOND THE MOUNTING SYSTEM TO THE OTHER PV SYSTEM EQUIPMENT AND TERMINATE IN THE COMBINER BOX. COMBINER BOX EQUIPMENT GROUND SHALL BE RUN IN SERIES AND TERMINATED IN THE INVERTER(S).

GROUNDING NOTES:

1. ALL BARE COPPER GROUND WIRING RUNNING BETWEEN ARRAYS SHALL BE PROTECTED FROM INADVERTENT DAMAGE BY BEING ROUTED INSIDE ACCEPTABLE CONDUIT OR WIREWAY. ALL CONDUITS OR WIREWAYS MUST BE NEATLY INSTALLED AND ATTACHED SECURELY TO THE MOUNTING SYSTEM.
2. THE GROUNDING ELECTRODE CONDUCTOR (GEC) ON THE AC SIDE OF THE SYSTEM SHALL BE TIED TO A CODE COMPLIANT GROUND ROD NEXT TO THE INVERTER OR AN EXISTING GEC POINT AT THE POCC.

GENERAL EQUIPMENT NOTES:

1. CIRCLE CALL-OUTS INDICATE BILL OF MATERIALS ITEM NUMBER AND IDENTIFY THE EQUIPMENT USED:  

2 INDICATES ITEM 2, COMBINER BOX

3 INDICATES ITEM 3, JUNCTION BOX

4 THRU 8 INDICATES ITEMS 4-8, INVERTER

PVSC (3) INDICATES CIRCUIT TYPE AND NUMBER OF STRINGS
2. COMBINER/JUNCTION BOX OUTPUT CIRCUITS: EQUAL NUMBER OF CONDUCTORS FOR POSITIVE AND NEGATIVE COMBINER TERMINALS (1) 10-AWG GREEN EQUIPMENT GROUNDING CONDUCTOR (EGC) REFER TO TABLE 1A FOR OUTPUT CONDUCTOR AND CONDUIT SIZING
3. ALL CONDUCTORS ARE COPPER.
4. ALL ENCLOSURES ARE NEMA-4 UNLESS OTHERWISE NOTED.
5. EQUIPMENT SHALL BE INSTALLED IN ACCORDANCE WITH THE NEC AND ALL APPLICABLE REQUIREMENTS OF THE SERVING ELECTRICAL UTILITY COMPANY AND OF THE LOCAL AUTHORITY HAVING JURISDICTION.
6. COMBINER/JUNCTION BOXES ARE IDENTIFIED BY INVERTER DESIGNATION:  
INVERTERS 9A AND 11A: CB-9A AND CB-11A  
INVERTER 9B AND 11B: CB-9B AND CB-11B
7. WHEN TRANSITIONING FROM RHW/USE-2 IN THE PV SOURCE CIRCUIT TO THHN/THWN-2, CONTRACTOR SHALL UTILIZE WATERTIGHT (NEMA-3R) JUNCTION BOX AND POLARIS CONNECTOR.

INVERTER NOTES:

1. INSTALLATION CONTRACTOR SHALL INSTALL COMBINER BOX OUTPUT CIRCUIT ON THE "COMBINED" INPUT CIRCUIT OF THE INVERTER. CONSULT INVERTER MANUAL FOR PROPER INSTALLATION OF REQUIRED CONNECTING DISTRIBUTORS.
2. INVERTERS ARE IDENTIFIED BY UNIT NUMBER AND LETTER. FOR UNITS 9 & 11 INVERTER DESIGNATION IS: INV 9A AND 11A

POINT OF INTERCONNECTION NOTES:

1. CONNECT FUSED DISCONNECT TO BUS BAR ON LINE SIDE OF SERVICE PANEL. THIS IS A LINE SIDE TAP.
2. ATTACH PLACARDS PER APPLICABLE PLACARD SHEET INSTRUCTIONS.

TABLE 1A - DC CIRCUIT SCHEDULE

| CURRENT CARRYING CONDUCTOR |      |     |          |      |             |        | GROUNDING |                     |      | OCPE   |      | CONDUIT/RACEWAY |       |
|----------------------------|------|-----|----------|------|-------------|--------|-----------|---------------------|------|--------|------|-----------------|-------|
| CIRCUIT #                  | TYPE | QTY | DISTANCE | SIZE | INSULATION  | V DROP | SIZE      | INSULATION          | TYPE | RATING | TYPE | SIZE /TYPE      | %FILL |
| Source                     | PVSC | 1   | 100      | 10   | RHW/USE-2   | 0.64%  | #10       | BARE                | EGC  | 15     | Fuse | BACK OF MODULE  |       |
| CB-9A                      | CBOC | 1   | 40       | 8    | THWN/THHN-2 | 0.48%  | #10       | THWN/THHN-2 (GREEN) | EGC  | -      | -    | 1" EMT          | 40    |

TABLE 2A - AC CIRCUIT SCHEDULE

| CURRENT CARRYING CONDUCTOR |      |     |          |      |             |        | GROUNDING |             |      | OCPD   |      | CONDUIT/RACEWAY |       |
|----------------------------|------|-----|----------|------|-------------|--------|-----------|-------------|------|--------|------|-----------------|-------|
| CIRCUIT #                  | TYPE | QTY | DISTANCE | SIZE | INSULATION  | V DROP | SIZE      | INSULATION  | TYPE | RATING | TYPE | SIZE /TYPE      | %FILL |
| I-9A                       | IOC  | 3   | 10       | 8    | THWN/THHN-2 | 0.19%  | 8         | THWN/THHN-2 | EGC  | 40     | CB   | 1" EMT          | 40    |
| DS-9                       | IOC  | 3   | 10       | 8    | THWN/THHN-2 | 0.19%  | 8         | THWN/THHN-2 | EGC  | 40     | CB   | 1" EMT          | 40    |

TABLE 1A - DC CIRCUIT SCHEDULE

| CURRENT CARRYING CONDUCTOR |      |     |          |      |             |        | GROUNDING |                     |      | OCPE   |      | CONDUIT/RACEWAY |       |
|----------------------------|------|-----|----------|------|-------------|--------|-----------|---------------------|------|--------|------|-----------------|-------|
| CIRCUIT #                  | TYPE | QTY | DISTANCE | SIZE | INSULATION  | V DROP | SIZE      | INSULATION          | TYPE | RATING | TYPE | SIZE /TYPE      | %FILL |
| Source                     | PVSC | 1   | 100      | 10   | RHW/USE-2   | 0.64%  | #10       | BARE                | EGC  | 15     | Fuse | BACK OF MODULE  |       |
| CB-11A                     | CBOC | 1   | 50       | 8    | THWN/THHN-2 | 0.60%  | #10       | THWN/THHN-2 (GREEN) | EGC  | -      | -    | 1" EMT          | 40    |

TABLE 2A - AC CIRCUIT SCHEDULE

| CURRENT CARRYING CONDUCTOR |      |     |          |      |             |        | GROUNDING |             |      | OCPD   |      | CONDUIT/RACEWAY |       |
|----------------------------|------|-----|----------|------|-------------|--------|-----------|-------------|------|--------|------|-----------------|-------|
| CIRCUIT #                  | TYPE | QTY | DISTANCE | SIZE | INSULATION  | V DROP | SIZE      | INSULATION  | TYPE | RATING | TYPE | SIZE /TYPE      | %FILL |
| I-11A                      | IOC  | 3   | 10       | 8    | THWN/THHN-2 | 0.19%  | 8         | THWN/THHN-2 | EGC  | 40     | CB   | 1" EMT          | 40    |
| DS-11                      | IOC  | 3   | 10       | 8    | THWN/THHN-2 | 0.19%  | 8         | THWN/THHN-2 | EGC  | 40     | CB   | 1" EMT          | 40    |

ENGINEER APPROVAL:



Roberto Rivera

ROBERTO RIVERA, P.E. NO. 16743

09/10/12

DATE:

DESCRIPTION:  
DATE:  
REV:

100% CONSTRUCTION DRAWINGS  
9/10/12  
1

PREPARED BY:



6977 NAVAJO RD., SUITE 139  
SAN DIEGO, CA 92119  
PHONE: 858.270.9333  
FAX: 858.270.9334

THIS DOCUMENT IS CONSIDERED PROTECTED  
INTELLECTUAL PROPERTY AND CONTAINS PROPRIETARY  
INFORMATION UNDER UNITED STATES LAW. NO PORTION OR  
PART OF THIS DOCUMENT MAY BE REPRODUCED FOR ANY  
PURPOSE WITHOUT THE EXPLICIT WRITTEN PERMISSION OF  
SUSTINEO CORP.

OWNER/CLIENT:

MADONNA ROAD APARTMENTS  
1550 MADONNA ROAD  
SAN LUIS OBISPO, CA 93405



EVERYDAY ENERGY  
5865 AVENIDA ENCINAS,  
SUITE 142A  
CARLSBAD, CA, 92008  
P: (760) 607-7200

SINGLE LINE DIAGRAM - UNITS 9 & 11

PHOTOVOLTAIC SYSTEM

PROJECT LOCATION:

1550 MADONNA ROAD  
SAN LUIS OBISPO, CA 93405

PROJECT NO.:

038 - 108

APN:

140-040-003

DATE:


SEPTEMBER 10, 2012

SHEET NO.:

E4.8

20 OF 30



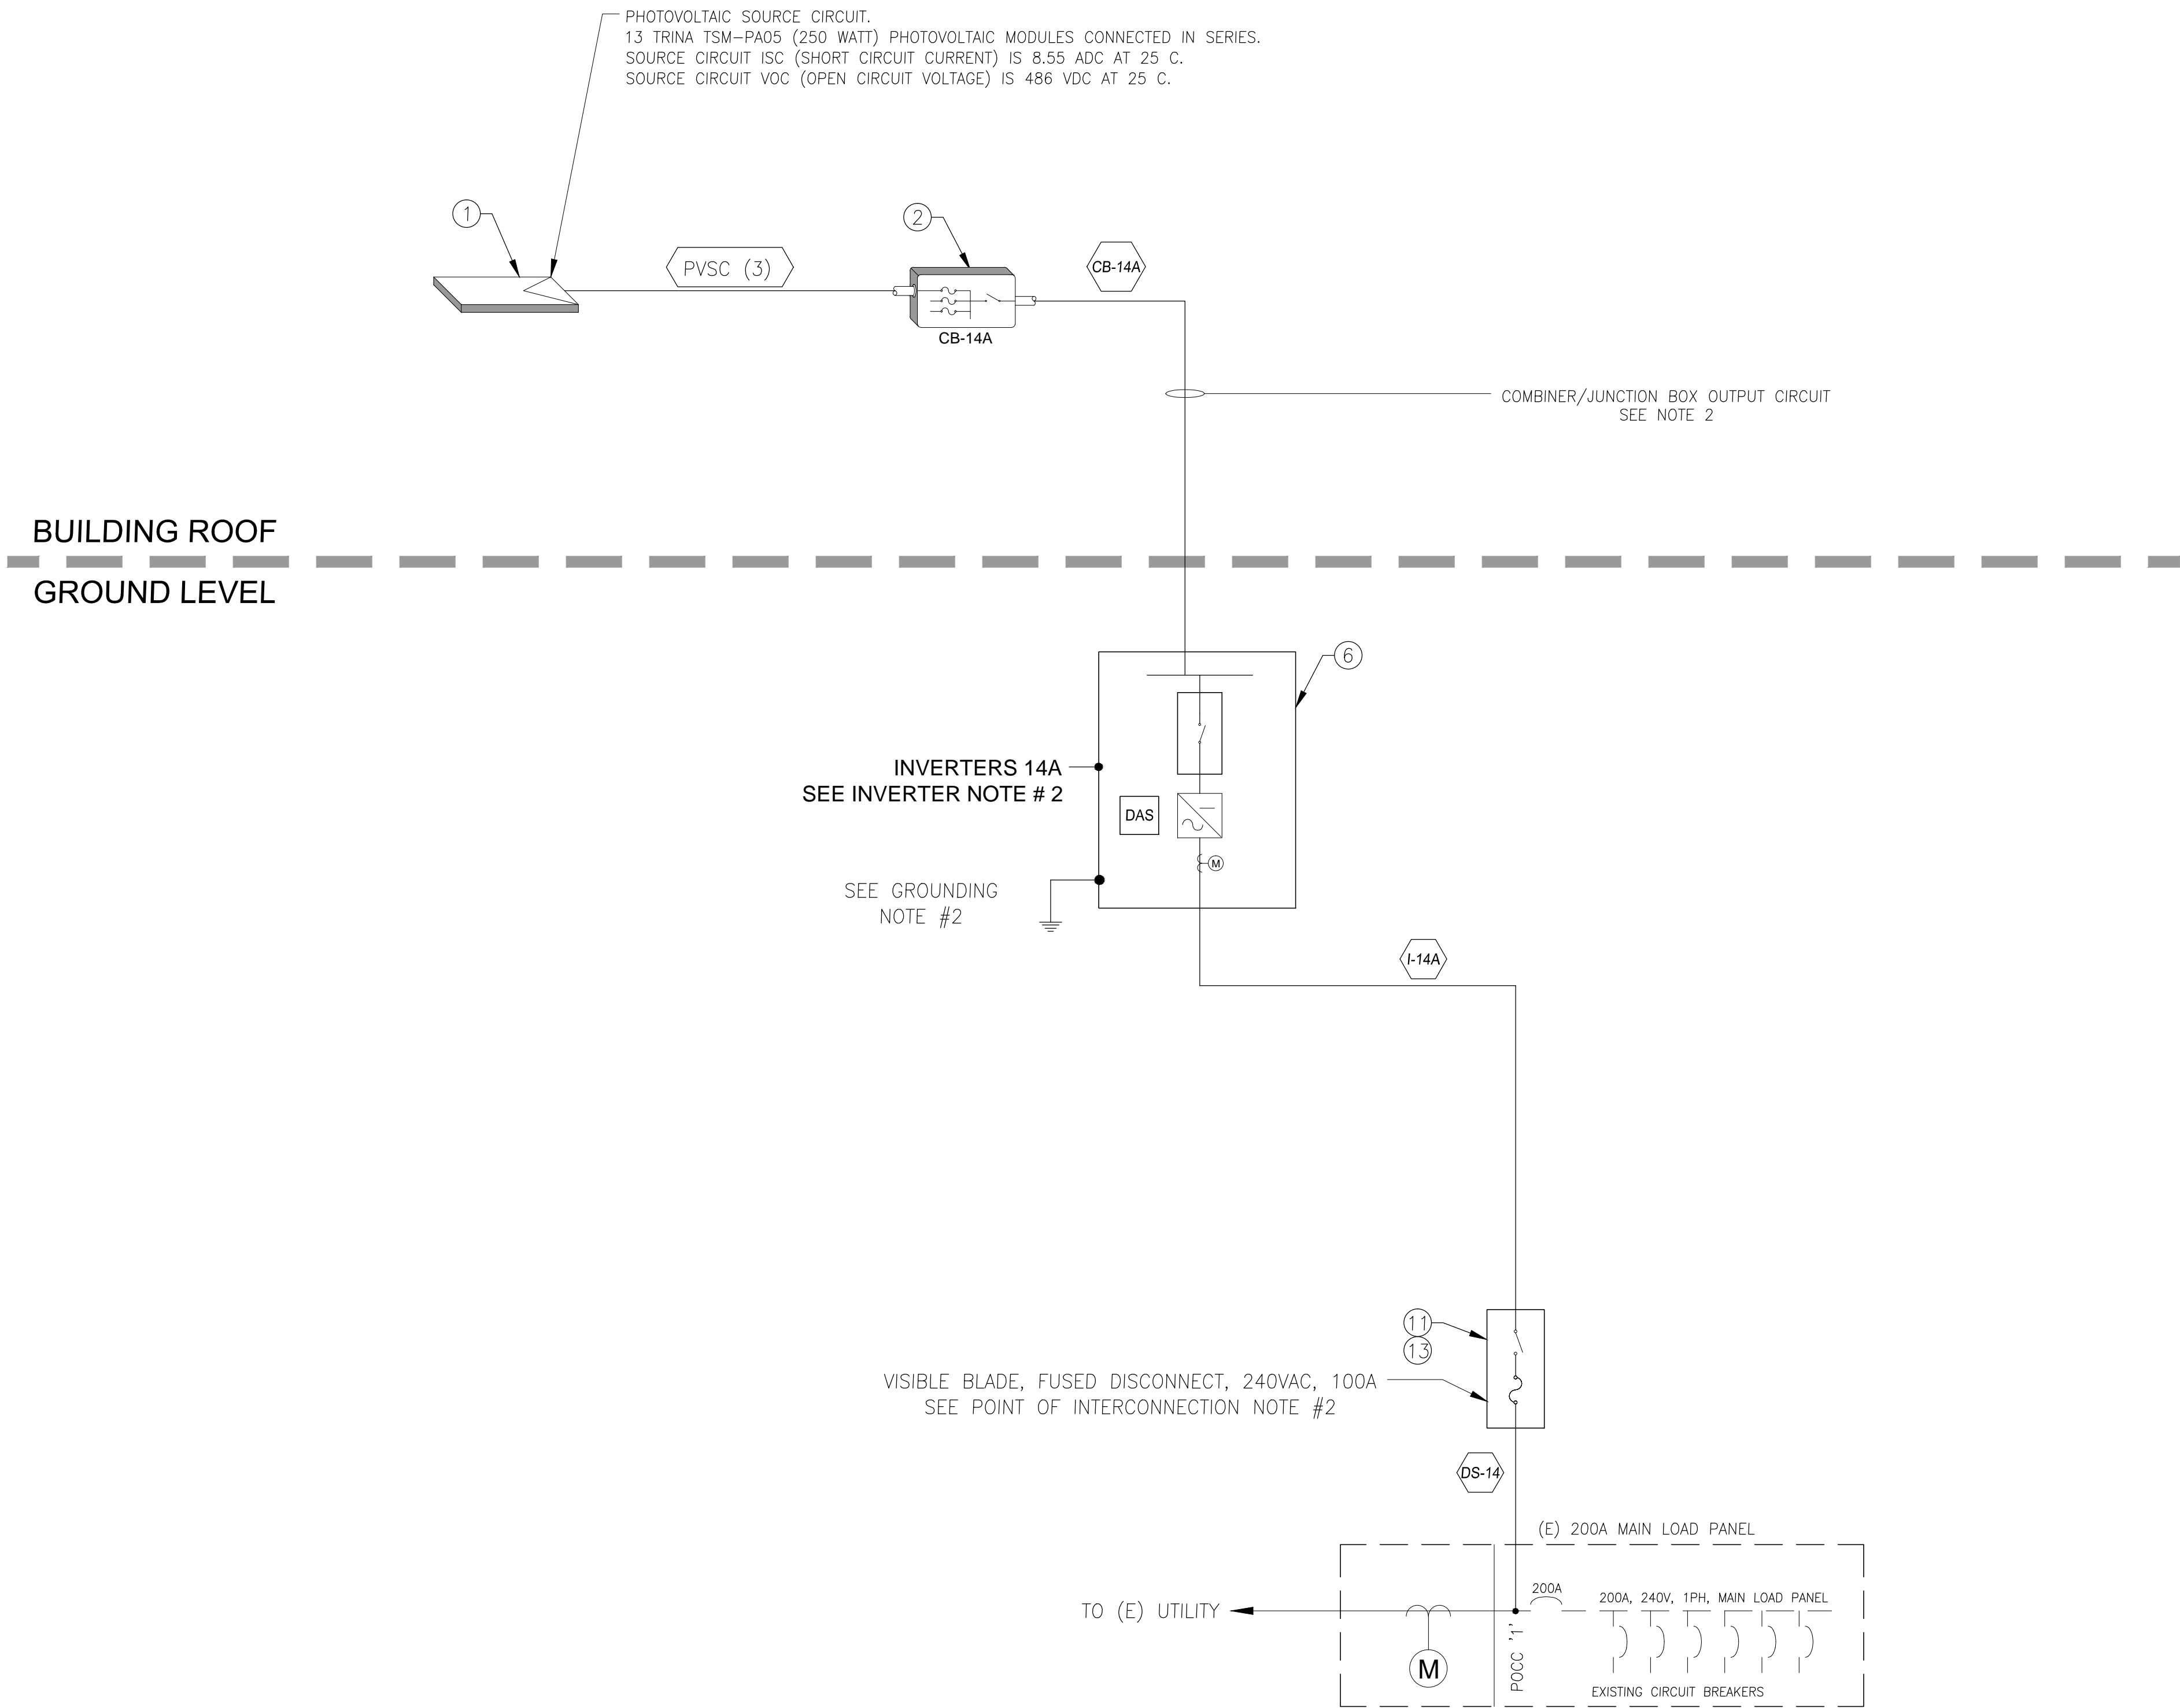

SINGLE LINE DIAGRAM NOTES:

1. ALL EQUIPMENT INSTALLED SHALL BE IN ACCORDANCE WITH ALL LOCAL AND ELECTRICAL BUILDING CODES. THE INSTALLATION SHALL CONFORM TO ALL LOCAL AND STATE SEISMIC REGULATIONS.
2. THE DC GROUNDING ELECTRODE CONDUCTOR SHALL BE BONDED WITH THE AC GROUNDING ELECTRODE.
3. COMBINER BOXES SHALL BE NEMA-4 ENCLOSURES OR BETTER.
4. ALL PV SOURCE CIRCUIT WIRES SHALL BE RHW/USE-2 SUNLIGHT RESISTANT OR XHHW-2.
5. #10-AWG BARE COPPER GROUND SHALL BE USED AS AN EQUIPMENT GROUND TO BOND THE MOUNTING SYSTEM TO THE OTHER PV SYSTEM EQUIPMENT AND TERMINATE IN THE COMBINER BOX. COMBINER BOX EQUIPMENT GROUND SHALL BE RUN IN SERIES AND TERMINATED IN THE INVERTER(S).

GROUNDING NOTES:

1. ALL BARE COPPER GROUND WIRING RUNNING BETWEEN ARRAYS SHALL BE PROTECTED FROM INADVERTENT DAMAGE BY BEING ROUTED INSIDE ACCEPTABLE CONDUIT OR WIREWAY. ALL CONDUITS OR WIREWAYS MUST BE NEATLY INSTALLED AND ATTACHED SECURELY TO THE MOUNTING SYSTEM.
2. THE GROUNDING ELECTRODE CONDUCTOR (GEC) ON THE AC SIDE OF THE SYSTEM SHALL BE TIED TO A CODE COMPLIANT GROUND ROD NEXT TO THE INVERTER OR AN EXISTING GEC POINT AT THE POCC.

GENERAL EQUIPMENT NOTES:

1. CIRCLE CALL-OUTS INDICATE BILL OF MATERIALS ITEM NUMBER AND IDENTIFY THE EQUIPMENT USED:
  - 2 INDICATES ITEM 2, COMBINER BOX
  - 3 INDICATES ITEM 3, JUNCTION BOX
  - 4 THRU 8 INDICATES ITEMS 4-8, INVERTER
  - PVSC (3) INDICATES CIRCUIT TYPE AND NUMBER OF STRINGS
2. COMBINER/JUNCTION BOX OUTPUT CIRCUITS: EQUAL NUMBER OF CONDUCTORS FOR POSITIVE AND NEGATIVE COMBINER TERMINALS (1) 10-AWG GREEN EQUIPMENT GROUNDING CONDUCTOR (EGC) REFER TO TABLE 1A FOR OUTPUT CONDUCTOR AND CONDUIT SIZING
3. ALL CONDUCTORS ARE COPPER.
4. ALL ENCLOSURES ARE NEMA-4 UNLESS OTHERWISE NOTED.
5. EQUIPMENT SHALL BE INSTALLED IN ACCORDANCE WITH THE NEC AND ALL APPLICABLE REQUIREMENTS OF THE SERVING ELECTRICAL UTILITY COMPANY AND OF THE LOCAL AUTHORITY HAVING JURISDICTION.
6. COMBINER/JUNCTION BOXES ARE IDENTIFIED BY INVERTER DESIGNATION:  
INVERTER 14A: CB-14A
7. WHEN TRANSITIONING FROM RHW/USE-2 IN THE PV SOURCE CIRCUIT TO THHN/THWN-2, CONTRACTOR SHALL UTILIZE WATERTIGHT (NEMA-3R) JUNCTION BOX AND POLARIS CONNECTOR.

INVERTER NOTES:

1. INSTALLATION CONTRACTOR SHALL INSTALL COMBINER BOX OUTPUT CIRCUIT ON THE "COMBINED" INPUT CIRCUIT OF THE INVERTER. CONSULT INVERTER MANUAL FOR PROPER INSTALLATION OF REQUIRED CONNECTING DISTRIBUTORS.
2. INVERTERS ARE IDENTIFIED BY UNIT NUMBER AND LETTER. FOR UNIT 14  
INVERTER DESIGNATION IS: INV 14A

POINT OF INTERCONNECTION NOTES:

1. CONNECT FUSED DISCONNECT TO BUS BAR ON LINE SIDE OF SERVICE PANEL.  
THIS IS A LINE SIDE TAP.
2. ATTACH PLACARDS PER APPLICABLE PLACARD SHEET INSTRUCTIONS.

| TABLE 1A - DC CIRCUIT SCHEDULE |      |     |          |      |             |        |           |                     |      |        |      |                 |       |
|--------------------------------|------|-----|----------|------|-------------|--------|-----------|---------------------|------|--------|------|-----------------|-------|
| CURRENT CARRYING CONDUCTOR     |      |     |          |      |             |        | GROUNDING |                     |      | OCPD   |      | CONDUIT/RACEWAY |       |
| CIRCUIT #                      | TYPE | QTY | DISTANCE | SIZE | INSULATION  | V DROP | SIZE      | INSULATION          | TYPE | RATING | TYPE | SIZE /TYPE      | %FILL |
| Source                         | PVSC | 1   | 100      | 10   | RHW/USE-2   | 0.54%  | #10       | BARE                | EGC  | 15     | Fuse | BACK OF MODULE  |       |
| CB-14A                         | CBOC | 1   | 70       | 8    | THWN/THHN-2 | 0.47%  | #10       | THWN/THHN-2 (GREEN) | EGC  | -      | -    | 1" EMT          | 40    |

| TABLE 2A - AC CIRCUIT SCHEDULE |      |     |          |      |             |        |           |             |      |        |      |                 |       |
|--------------------------------|------|-----|----------|------|-------------|--------|-----------|-------------|------|--------|------|-----------------|-------|
| CURRENT CARRYING CONDUCTOR     |      |     |          |      |             |        | GROUNDING |             |      | OCPD   |      | CONDUIT/RACEWAY |       |
| CIRCUIT #                      | TYPE | QTY | DISTANCE | SIZE | INSULATION  | V DROP | SIZE      | INSULATION  | TYPE | RATING | TYPE | SIZE /TYPE      | %FILL |
| I-14A                          | IOC  | 3   | 10       | 8    | THWN/THHN-2 | 0.15%  | 8         | THWN/THHN-2 | EGC  | 35     | CB   | 1" EMT          | 40    |
| DS-14                          | IOC  | 3   | 10       | 8    | THWN/THHN-2 | 0.15%  | 8         | THWN/THHN-2 | EGC  | 35     | CB   | 1" EMT          | 40    |

ENGINEER APPROVAL:



09/10/12  
ROBERTO RIVERA, P.E. NO. 16743  
DATE:

| REV. | DATE    | DESCRIPTION                |
|------|---------|----------------------------|
| 1    | 9/10/12 | 100% CONSTRUCTION DRAWINGS |

PREPARED BY:



6977 NAVAJO RD., SUITE 139  
SAN DIEGO, CA 92119  
PHONE: 858.270.9333  
FAX: 858.270.9334

THIS DOCUMENT IS CONSIDERED PROTECTED  
INTELLECTUAL PROPERTY AND CONTAINS PROPRIETARY  
INFORMATION UNDER UNITED STATES LAW. NO PORTION OR  
PART OF THIS DOCUMENT MAY BE REPRODUCED FOR ANY  
PURPOSE WITHOUT THE EXPRESS WRITTEN PERMISSION OF  
SUSTINEO CORP.

OWNER/CLIENT:

MADONNA ROAD APARTMENTS  
1550 MADONNA ROAD  
SAN LUIS OBISPO, CA 93405



EVERYDAY ENERGY  
5865 AVENIDA ENCINAS,  
SUITE 142A  
CARLSBAD, CA, 92008  
P: (760) 607-7200

SINGLE LINE DIAGRAM - UNIT 14

PHOTOVOLTAIC SYSTEM

1550 MADONNA ROAD  
SAN LUIS OBISPO, CA 93405

TITLE:

PROJECT NO.:

038 - 108

APN:

140-040-003


DATE:

SEPTEMBER 10, 2012

SHEET NO.:

E4.9  
21 OF 30



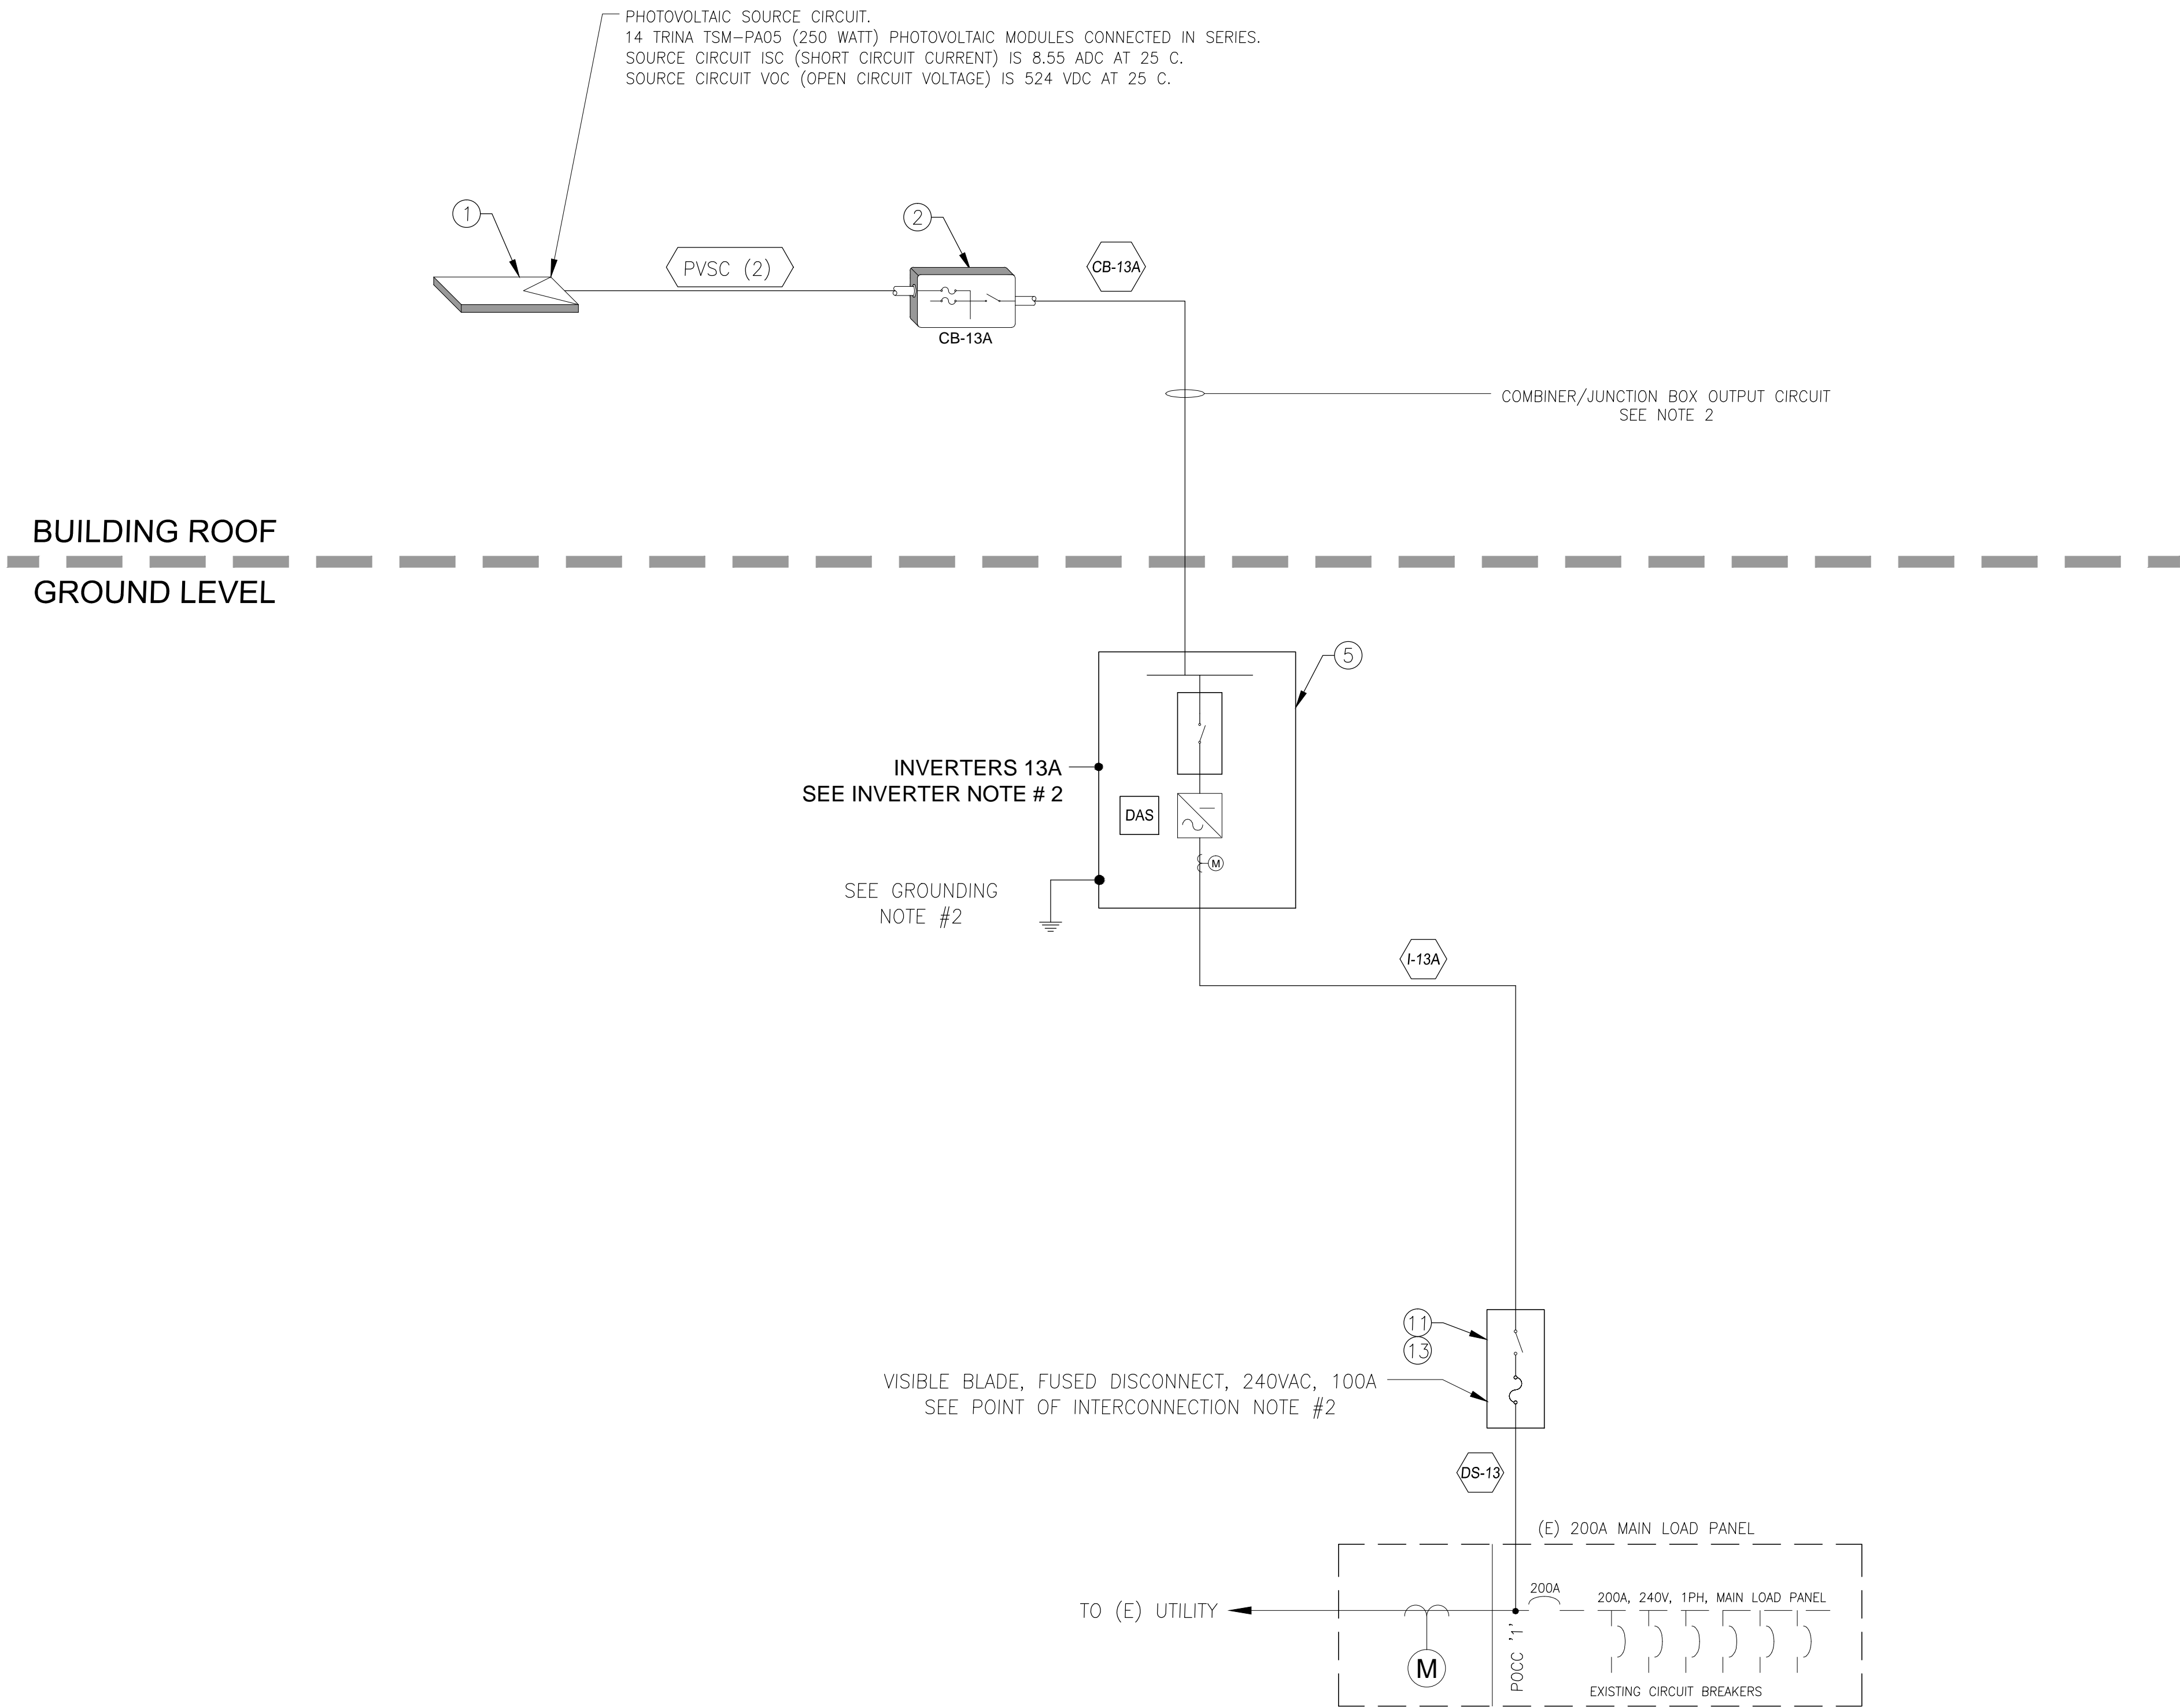

SINGLE LINE DIAGRAM NOTES:

1. ALL EQUIPMENT INSTALLED SHALL BE IN ACCORDANCE WITH ALL LOCAL AND ELECTRICAL BUILDING CODES. THE INSTALLATION SHALL CONFORM TO ALL LOCAL AND STATE SEISMIC REGULATIONS.
2. THE DC GROUNDING ELECTRODE CONDUCTOR SHALL BE BONDED WITH THE AC GROUNDING ELECTRODE.
3. COMBINER BOXES SHALL BE NEMA-4 ENCLOSURES OR BETTER.
4. ALL PV SOURCE CIRCUIT WIRES SHALL BE RHW/USE-2 SUNLIGHT RESISTANT OR XHHW-2.
5. #10-AWG BARE COPPER GROUND SHALL BE USED AS AN EQUIPMENT GROUND TO BOND THE MOUNTING SYSTEM TO THE OTHER PV SYSTEM EQUIPMENT AND TERMINATE IN THE COMBINER BOX. COMBINER BOX EQUIPMENT GROUND SHALL BE RUN IN SERIES AND TERMINATED IN THE INVERTER(S).

GROUNDING NOTES:

1. ALL BARE COPPER GROUND WIRING RUNNING BETWEEN ARRAYS SHALL BE PROTECTED FROM INADVERTENT DAMAGE BY BEING ROUTED INSIDE ACCEPTABLE CONDUIT OR WIREWAY. ALL CONDUITS OR WIREWAYS MUST BE NEATLY INSTALLED AND ATTACHED SECURELY TO THE MOUNTING SYSTEM.
2. THE GROUNDING ELECTRODE CONDUCTOR (GEC) ON THE AC SIDE OF THE SYSTEM SHALL BE TIED TO A CODE COMPLIANT GROUND ROD NEXT TO THE INVERTER OR AN EXISTING GEC POINT AT THE POCC.

GENERAL EQUIPMENT NOTES:

1. CIRCLE CALL-OUTS INDICATE BILL OF MATERIALS ITEM NUMBER AND IDENTIFY THE EQUIPMENT USED:

- 2 INDICATES ITEM 2, COMBINER BOX
- 3 INDICATES ITEM 3, JUNCTION BOX
- 4 THRU 8 INDICATES ITEMS 4-8, INVERTER
- PVSC (3) INDICATES CIRCUIT TYPE AND NUMBER OF STRINGS

2. COMBINER/JUNCTION BOX OUTPUT CIRCUITS: EQUAL NUMBER OF CONDUCTORS FOR POSITIVE AND NEGATIVE COMBINER TERMINALS (1) 10-AWG GREEN EQUIPMENT GROUNDING CONDUCTOR (EGC) REFER TO TABLE 1A FOR OUTPUT CONDUCTOR AND CONDUIT SIZING
3. ALL CONDUCTORS ARE COPPER.
4. ALL ENCLOSURES ARE NEMA-4 UNLESS OTHERWISE NOTED.
5. EQUIPMENT SHALL BE INSTALLED IN ACCORDANCE WITH THE NEC AND ALL APPLICABLE REQUIREMENTS OF THE SERVING ELECTRICAL UTILITY COMPANY AND OF THE LOCAL AUTHORITY HAVING JURISDICTION.
6. COMBINER/JUNCTION BOXES ARE IDENTIFIED BY INVERTER DESIGNATION:  
INVERTER 13A: CB-13A
7. WHEN TRANSITIONING FROM RHW/USE-2 IN THE PV SOURCE CIRCUIT TO THHN/THWN-2, CONTRACTOR SHALL UTILIZE WATERTIGHT (NEMA-3R) JUNCTION BOX AND POLARIS CONNECTOR.

INVERTER NOTES:

1. INSTALLATION CONTRACTOR SHALL INSTALL COMBINER BOX OUTPUT CIRCUIT ON THE "COMBINED" INPUT CIRCUIT OF THE INVERTER. CONSULT INVERTER MANUAL FOR PROPER INSTALLATION OF REQUIRED CONNECTING DISTRIBUTORS.
2. INVERTERS ARE IDENTIFIED BY UNIT NUMBER AND LETTER FOR UNIT 13  
INVERTER DESIGNATION IS: INV 13A

POINT OF INTERCONNECTION NOTES:

1. CONNECT FUSED DISCONNECT TO BUS BAR ON LINE SIDE OF SERVICE PANEL.  
THIS IS A LINE SIDE TAP.
2. ATTACH PLACARDS PER APPLICABLE PLACARD SHEET INSTRUCTIONS.

TABLE 1A - DC CIRCUIT SCHEDULE

| CURRENT CARRYING CONDUCTOR |      |     |          |      |             |        | GROUNDING |                     |      | OCPD   |      | CONDUIT/RACEWAY |       |
|----------------------------|------|-----|----------|------|-------------|--------|-----------|---------------------|------|--------|------|-----------------|-------|
| CIRCUIT #                  | TYPE | QTY | DISTANCE | SIZE | INSULATION  | V DROP | SIZE      | INSULATION          | TYPE | RATING | TYPE | SIZE/TYPE       | %FILL |
| Source                     | PVSC | 1   | 100      | 10   | RHW/USE-2   | 0.50%  | #10       | BARE                | EGC  | 15     | Fuse | BACK OF MODULE  |       |
| CB-13A                     | CBOC | 1   | 70       | 8    | THWN/THHN-2 | 0.44%  | #10       | THWN/THHN-2 (GREEN) | EGC  | -      | -    | 1" EMT          | 40    |

TABLE 2A - AC CIRCUIT SCHEDULE

| CURRENT CARRYING CONDUCTOR |      |     |          |      |             |        | GROUNDING |             |      | OCPD   |      | CONDUIT/RACEWAY |       |
|----------------------------|------|-----|----------|------|-------------|--------|-----------|-------------|------|--------|------|-----------------|-------|
| CIRCUIT #                  | TYPE | QTY | DISTANCE | SIZE | INSULATION  | V DROP | SIZE      | INSULATION  | TYPE | RATING | TYPE | SIZE /TYPE      | %FILL |
| I-13A                      | IOC  | 3   | 10       | 10   | THWN/THHN-2 | 0.24%  | 8         | THWN/THHN-2 | EGC  | 35     | CB   | 1" EMT          | 40    |
| DS-13                      | IOC  | 3   | 10       | 10   | THWN/THHN-2 | 0.24%  | 8         | THWN/THHN-2 | EGC  | 35     | CB   | 1" EMT          | 40    |

ENGINEER APPROVAL:



ROBERTO RIVERA, P.E. NO. 16743

09/10/12

DATE:

| REV | DATE    | DESCRIPTION                |
|-----|---------|----------------------------|
| 1   | 9/10/12 | 100% CONSTRUCTION DRAWINGS |

PREPARED BY:



6977 NAVAJO RD., SUITE 139  
SAN DIEGO, CA 92119  
PHONE: 858.270.9333  
FAX: 858.270.9334

THIS DOCUMENT IS CONSIDERED PROTECTED  
INTELLECTUAL PROPERTY AND CONTAINS PROPRIETARY  
INFORMATION UNDER UNITED STATES LAW. NO PORTION OR  
PART OF THIS DOCUMENT MAY BE REPRODUCED FOR ANY  
PURPOSE WITHOUT THE EXPRESS WRITTEN PERMISSION OF  
SUSTINEO CORP.

OWNER/CLIENT:

MADONNA ROAD APARTMENTS  
1550 MADONNA ROAD  
SAN LUIS OBISPO, CA 93405



EVERYDAY ENERGY  
5865 AVENIDA ENCINAS,  
SUITE 142A  
CARLSBAD, CA, 92008  
P: (760) 607-7200

SINGLE LINE DIAGRAM - UNIT 13

PHOTOVOLTAIC SYSTEM

1550 MADONNA ROAD  
SAN LUIS OBISPO, CA 93405

TITLE:

PROJECT LOCATION:

PROJECT NO.:

038 - 108

APN:

140-040-003

DATE:


SEPTEMBER 10, 2012

SHEET NO.:

E4.10

22 OF 30



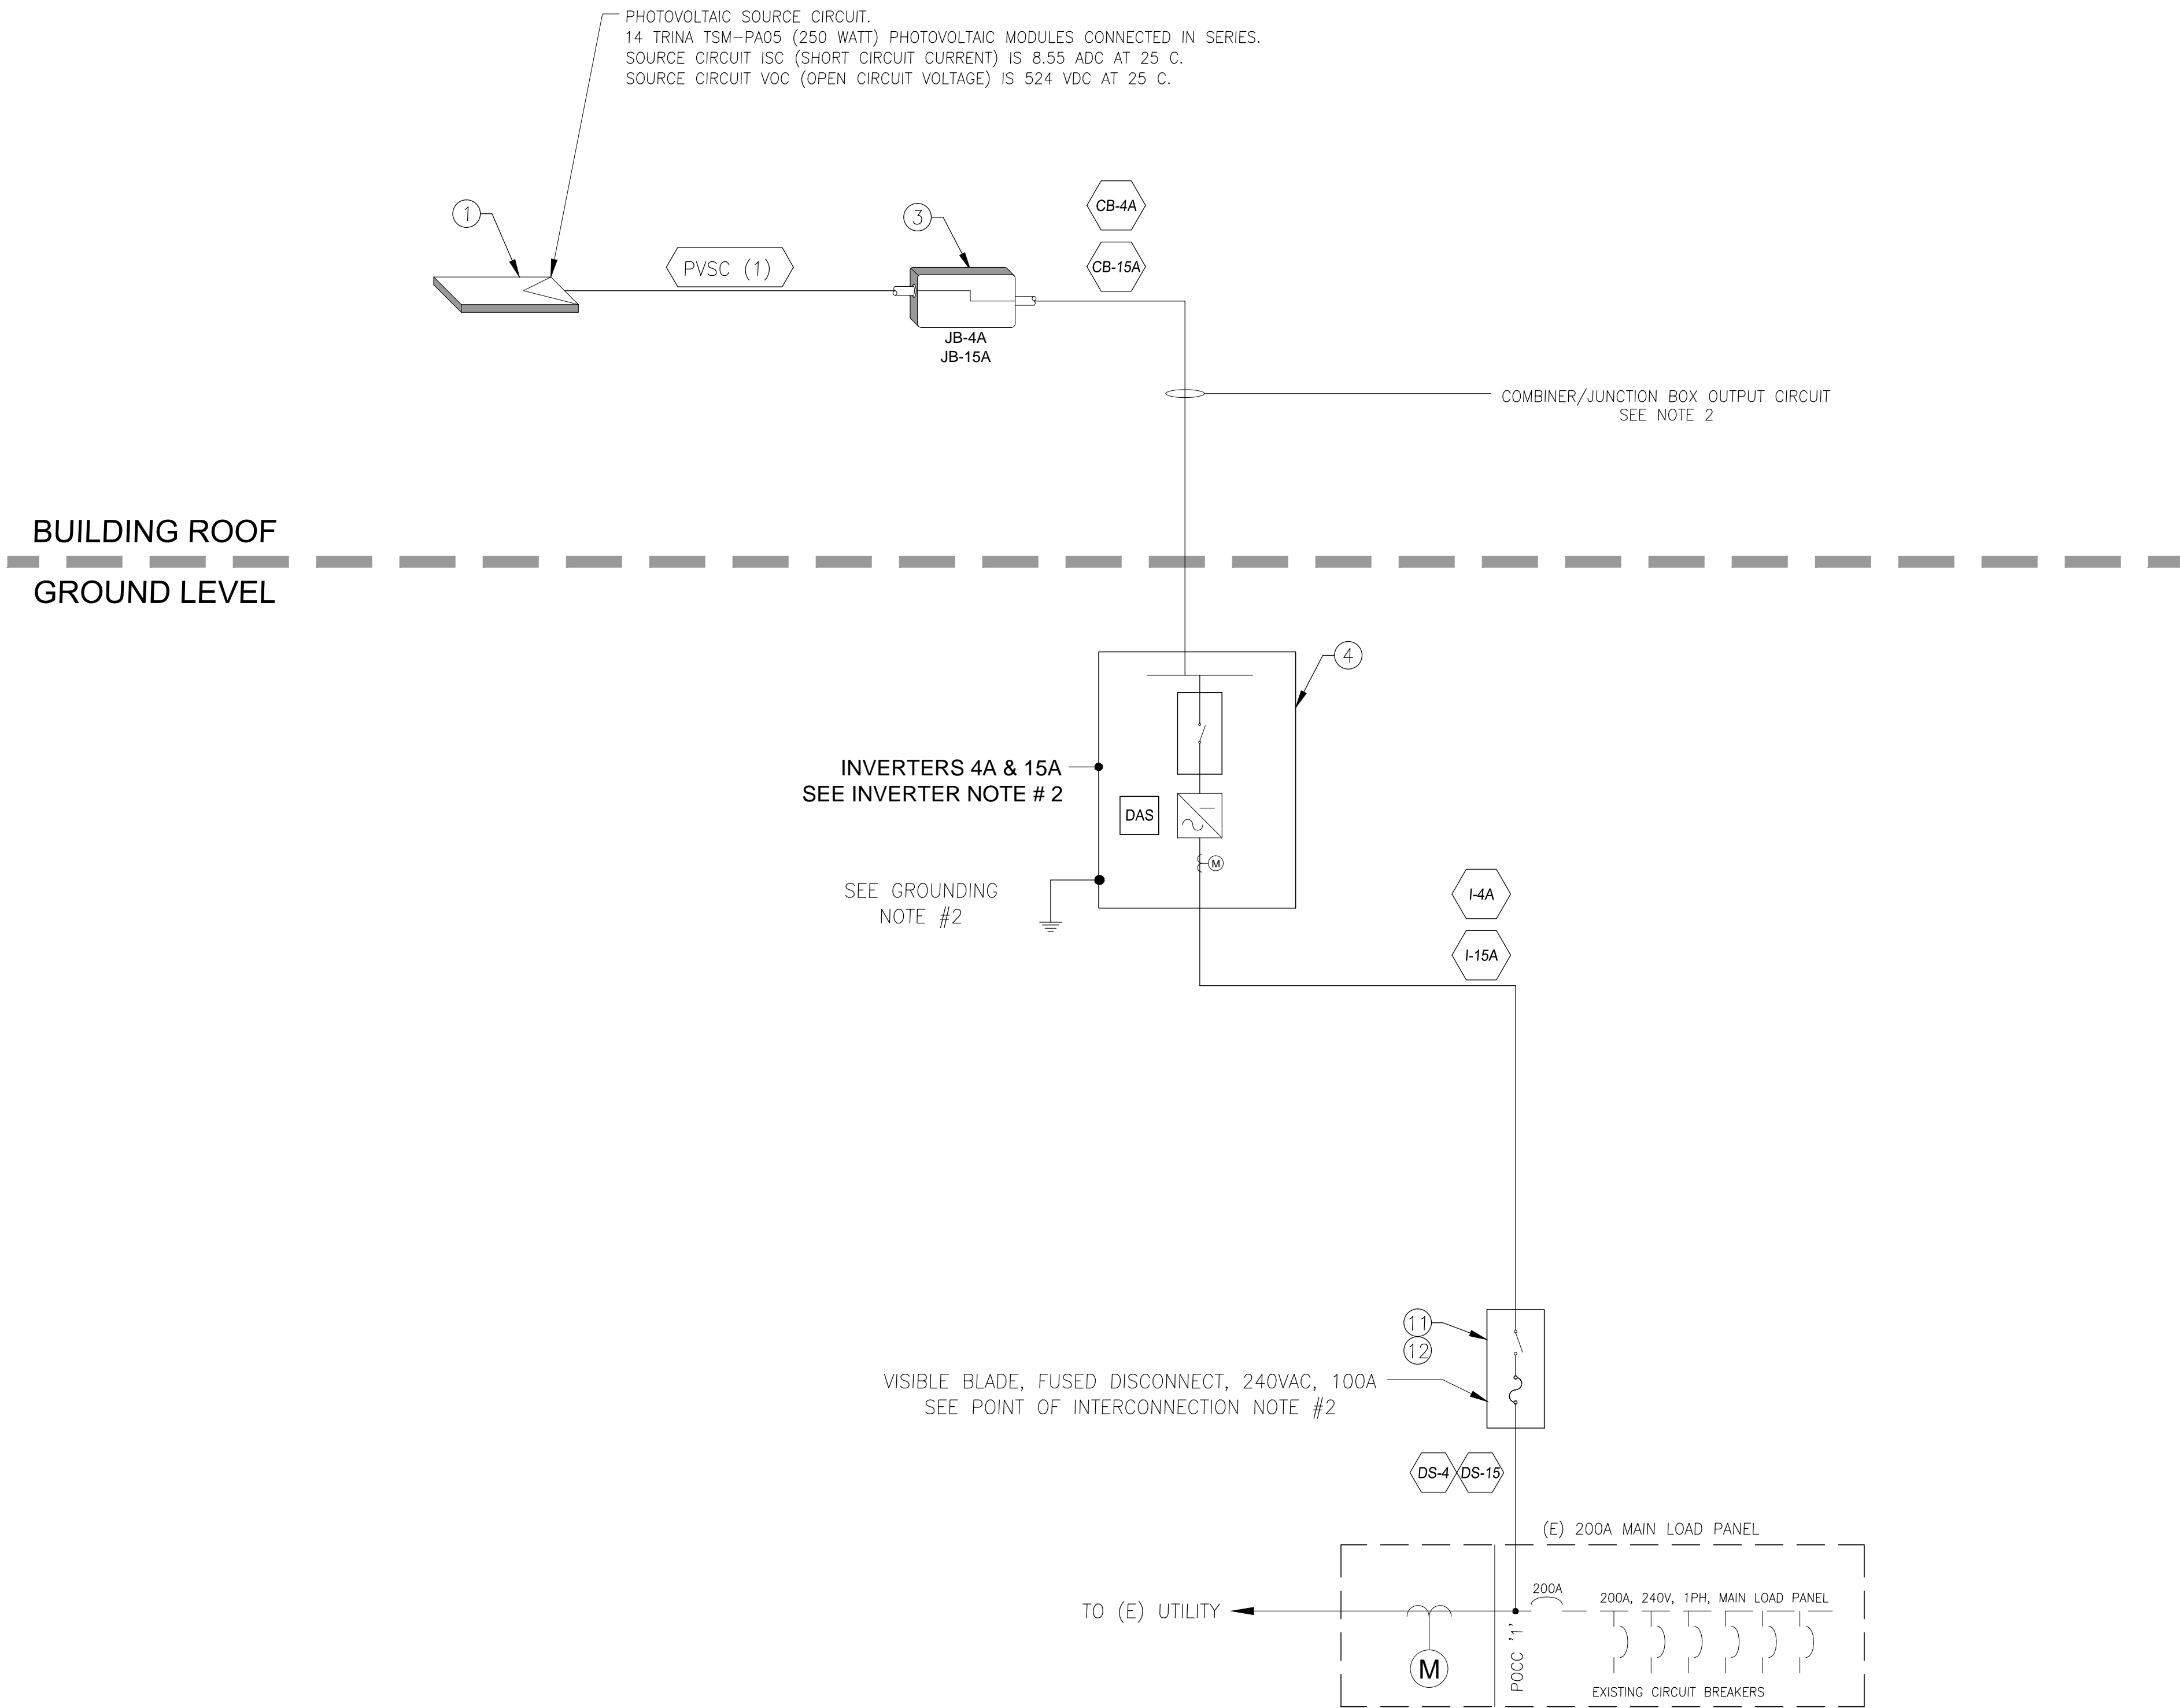

SINGLE LINE DIAGRAM NOTES:

1. ALL EQUIPMENT INSTALLED SHALL BE IN ACCORDANCE WITH ALL LOCAL AND ELECTRICAL BUILDING CODES. THE INSTALLATION SHALL CONFORM TO ALL LOCAL AND STATE SEISMIC REGULATIONS.
2. THE DC GROUNDING ELECTRODE CONDUCTOR SHALL BE BONDED WITH THE AC GROUNDING ELECTRODE.
3. COMBINER BOXES SHALL BE NEMA-4 ENCLOSURES OR BETTER.
4. ALL PV SOURCE CIRCUIT WIRES SHALL BE RHW/USE-2 SUNLIGHT RESISTANT OR XHHW-2.
5. #10-AWG BARE COPPER GROUND SHALL BE USED AS AN EQUIPMENT GROUND TO BOND THE MOUNTING SYSTEM TO THE OTHER PV SYSTEM EQUIPMENT AND TERMINATE IN THE COMBINER BOX. COMBINER BOX EQUIPMENT GROUND SHALL BE RUN IN SERIES AND TERMINATED IN THE INVERTER(S).

GROUNDING NOTES:

1. ALL BARE COPPER GROUND WIRING RUNNING BETWEEN ARRAYS SHALL BE PROTECTED FROM INADVERTENT DAMAGE BY BEING ROUTED INSIDE ACCEPTABLE CONDUIT OR WIREWAY. ALL CONDUITS OR WIREWAYS MUST BE NEATLY INSTALLED AND ATTACHED SECURELY TO THE MOUNTING SYSTEM.
2. THE GROUNDING ELECTRODE CONDUCTOR (GEC) ON THE AC SIDE OF THE SYSTEM SHALL BE TIED TO A CODE COMPLIANT GROUND ROD NEXT TO THE INVERTER OR AN EXISTING GEC POINT AT THE POCC.

GENERAL EQUIPMENT NOTES:

1. CIRCLE CALL-OUTS INDICATE BILL OF MATERIALS ITEM NUMBER AND IDENTIFY THE EQUIPMENT USED:

- 2 INDICATES ITEM 2, COMBINER BOX
- 3 INDICATES ITEM 3, JUNCTION BOX
- 4 THRU 8 INDICATES ITEMS 4-8, INVERTER
- PVSC (3) INDICATES CIRCUIT TYPE AND NUMBER OF STRINGS

2. COMBINER/JUNCTION BOX OUTPUT CIRCUITS: EQUAL NUMBER OF CONDUCTORS FOR POSITIVE AND NEGATIVE COMBINER TERMINALS (1) 10-AWG GREEN EQUIPMENT GROUNDING CONDUCTOR (EGC) REFER TO TABLE 1A FOR OUTPUT CONDUCTOR AND CONDUIT SIZING
3. ALL CONDUCTORS ARE COPPER.
4. ALL ENCLOSURES ARE NEMA-4 UNLESS OTHERWISE NOTED.
5. EQUIPMENT SHALL BE INSTALLED IN ACCORDANCE WITH THE NEC AND ALL APPLICABLE REQUIREMENTS OF THE SERVING ELECTRICAL UTILITY COMPANY AND OF THE LOCAL AUTHORITY HAVING JURISDICTION.
6. COMBINER/JUNCTION BOXES ARE IDENTIFIED BY INVERTER DESIGNATION:  
INVERTER 4A: JB-4A  
INVERTER 15A: JB-15A
7. WHEN TRANSITIONING FROM RHW/USE-2 IN THE PV SOURCE CIRCUIT TO THHN/THWN-2, CONTRACTOR SHALL UTILIZE WATERTIGHT (NEMA-3R) JUNCTION BOX AND POLARIS CONNECTOR.

INVERTER NOTES:

1. INSTALLATION CONTRACTOR SHALL INSTALL COMBINER BOX OUTPUT CIRCUIT ON THE "COMBINED" INPUT CIRCUIT OF THE INVERTER. CONSULT INVERTER MANUAL FOR PROPER INSTALLATION OF REQUIRED CONNECTING DISTRIBUTORS.
2. INVERTERS ARE IDENTIFIED BY UNIT NUMBER AND LETTER. FOR UNITS 4 & 15 INVERTER DESIGNATION IS: INV 4A AND 15A

POINT OF INTERCONNECTION NOTES:

1. CONNECT FUSED DISCONNECT TO BUS BAR ON LINE SIDE OF SERVICE PANEL. THIS IS A LINE SIDE TAP.
2. ATTACH PLACARDS PER APPLICABLE PLACARD SHEET INSTRUCTIONS.

TABLE 1A - DC CIRCUIT SCHEDULE

| CURRENT CARRYING CONDUCTOR |      |     |          |      |             |        | GROUNDING |                     | OCPD |        | CONDUIT/RACEWAY |                |       |
|----------------------------|------|-----|----------|------|-------------|--------|-----------|---------------------|------|--------|-----------------|----------------|-------|
| CIRCUIT #                  | TYPE | QTY | DISTANCE | SIZE | INSULATION  | V DROP | SIZE      | INSULATION          | TYPE | RATING | TYPE            | SIZE /TYPE     | %FILL |
| Source                     | PVSC | 1   | 100      | 10   | RHW/USE-2   | 0.50%  | #10       | BARE                | EGC  | 15     | Fuse            | BACK OF MODULE |       |
| JB-4A                      | CBOC | 1   | 75       | 10   | THWN/THHN-2 | 0.38%  | #10       | THWN/THHN-2 (GREEN) | EGC  | -      | -               | 1" EMT         | 40    |

TABLE 2A - AC CIRCUIT SCHEDULE

| CURRENT CARRYING CONDUCTOR |      |     |          |      |             |        | GROUNDING |             | OCPD |        | CONDUIT/RACEWAY |            |       |
|----------------------------|------|-----|----------|------|-------------|--------|-----------|-------------|------|--------|-----------------|------------|-------|
| CIRCUIT #                  | TYPE | QTY | DISTANCE | SIZE | INSULATION  | V DROP | SIZE      | INSULATION  | TYPE | RATING | TYPE            | SIZE /TYPE | %FILL |
| I-4A                       | IOC  | 3   | 10       | 10   | THWN/THHN-2 | 0.12%  | 8         | THWN/THHN-2 | EGC  | 20     | CB              | 1" EMT     | 40    |
| DS-4                       | IOC  | 3   | 10       | 10   | THWN/THHN-2 | 0.12%  | 8         | THWN/THHN-2 | EGC  | 20     | CB              | 1" EMT     | 40    |

TABLE 1A - DC CIRCUIT SCHEDULE

| CURRENT CARRYING CONDUCTOR |      |     |          |      |             |        | GROUNDING |                     | OCPE |        | CONDUIT/RACEWAY |                |       |
|----------------------------|------|-----|----------|------|-------------|--------|-----------|---------------------|------|--------|-----------------|----------------|-------|
| CIRCUIT #                  | TYPE | QTY | DISTANCE | SIZE | INSULATION  | V DROP | SIZE      | INSULATION          | TYPE | RATING | TYPE            | SIZE /TYPE     | %FILL |
| Source                     | PVSC | 1   | 100      | 10   | RHW/USE-2   | 0.50%  | #10       | BARE                | EGC  | 15     | Fuse            | BACK OF MODULE |       |
| JB-15A                     | CBOC | 1   | 50       | 10   | THWN/THHN-2 | 0.25%  | #10       | THWN/THHN-2 (GREEN) | EGC  | -      | -               | 1" EMT         | 40    |

TABLE 2A - AC CIRCUIT SCHEDULE

| CURRENT CARRYING CONDUCTOR |      |     |          |      |             |        | GROUNDING |             | OCPD |        | CONDUIT/RACEWAY |            |       |
|----------------------------|------|-----|----------|------|-------------|--------|-----------|-------------|------|--------|-----------------|------------|-------|
| CIRCUIT #                  | TYPE | QTY | DISTANCE | SIZE | INSULATION  | V DROP | SIZE      | INSULATION  | TYPE | RATING | TYPE            | SIZE /TYPE | %FILL |
| I-15A                      | IOC  | 3   | 10       | 10   | THWN/THHN-2 | 0.12%  | 8         | THWN/THHN-2 | EGC  | 20     | CB              | 1" EMT     | 40    |
| DS-15                      | IOC  | 3   | 10       | 10   | THWN/THHN-2 | 0.12%  | 8         | THWN/THHN-2 | EGC  | 20     | CB              | 1" EMT     | 40    |

ENGINEER APPROVAL:



ROBERTO RIVERA, P.E. NO. 16743

09/10/12

DATE:

REVISIONS

DATE: 9/10/12

DESCRIPTION: 100% CONSTRUCTION DRAWINGS

REV. 1

PREPARED BY:



6977 NAVAJO RD., SUITE 139  
SAN DIEGO, CA 92119  
PHONE: 858.270.9333  
FAX: 858.270.9334

THIS DOCUMENT IS CONSIDERED PROTECTED  
INTELLECTUAL PROPERTY AND CONTAINS PROPRIETARY  
INFORMATION UNDER UNITED STATES LAW. NO PORTION OR  
PART OF THIS DOCUMENT MAY BE REPRODUCED FOR ANY  
PURPOSE WITHOUT THE EXPLICIT WRITTEN PERMISSION OF  
SUSTINEO CORP.

OWNER/CLIENT:

MADONNA ROAD APARTMENTS  
1550 MADONNA ROAD  
SAN LUIS OBISPO, CA 93405



EVERYDAY ENERGY  
5865 AVENIDA ENCINAS,  
SUITE 142A  
CARLSBAD, CA, 92008  
P: (760) 607-7200

SINGLE LINE DIAGRAM - UNITS 4 & 15

PHOTOVOLTAIC SYSTEM

1550 MADONNA ROAD  
SAN LUIS OBISPO, CA 93405

PROJECT LOCATION:

PROJECT NO.:

038 - 108

APN:

140-040-003


DATE:

SEPTEMBER 10, 2012

SHEET NO.:

E4.11




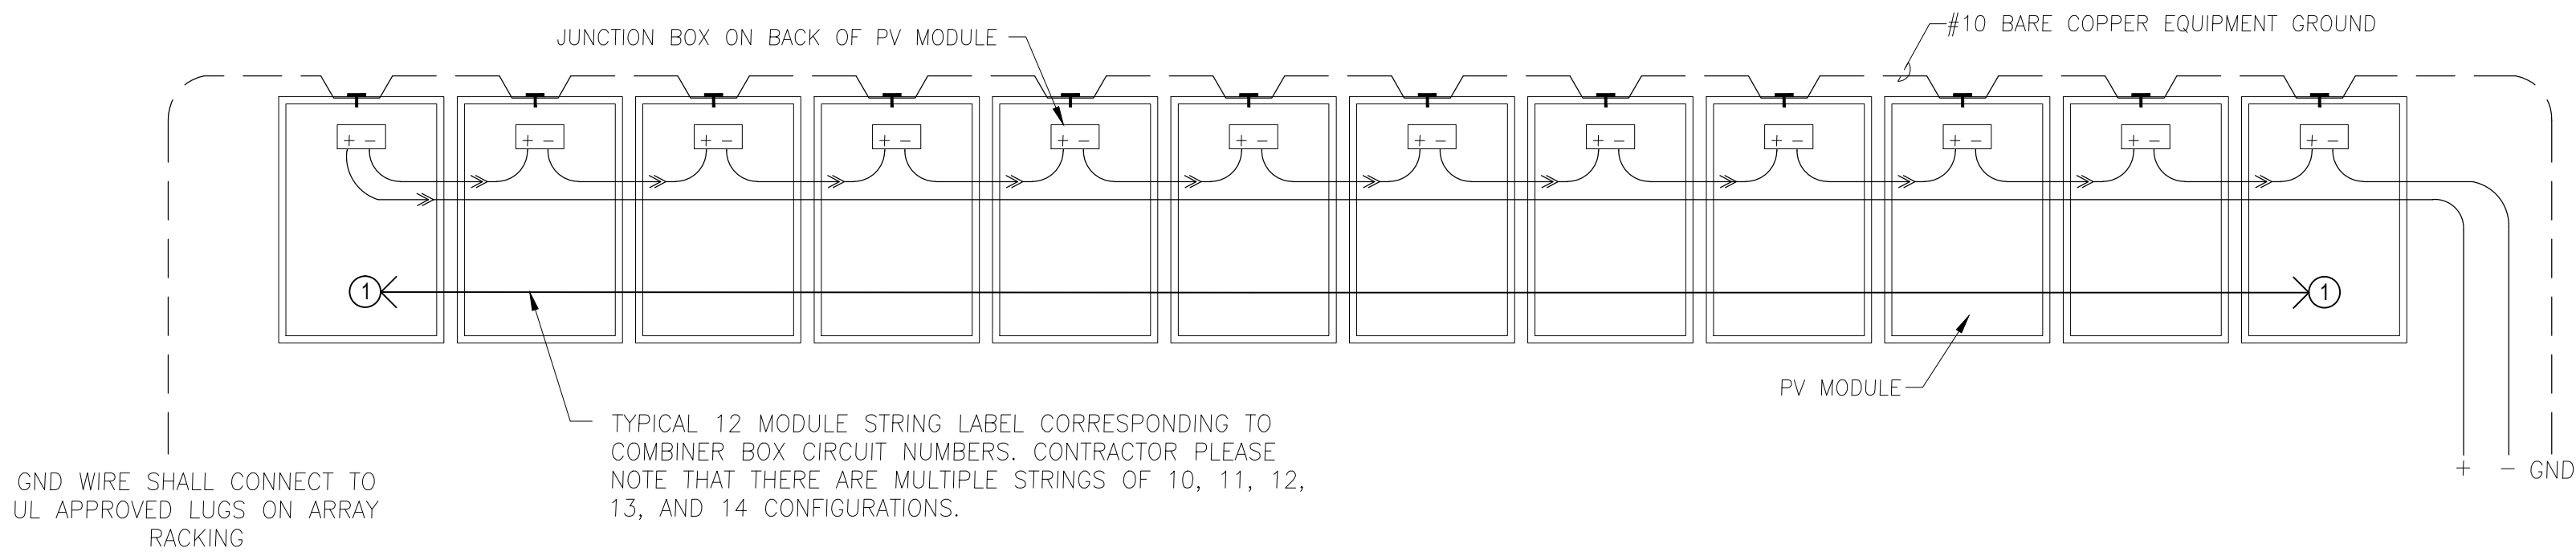


TYPICAL 12 STRING WIRING DETAIL  
NOT TO SCALE

GROUNDING NOTES:


1. A SCREW IS ADDED TO EACH MODULE ALONG THE ARRAY.
2. (1) ADDITIONAL GROUNDING POINT IS TO BE ADDED TO THE RAILS TO PROVIDE EQUIPMENT GROUNDING OF THE ARRAY.
3. REFER TO PANEL CLAW ASSEMBLY INSTRUCTIONS FOR EQUIPMENT GROUNDING.
4. GROUNDING ELECTRODE SYSTEM SHALL BE PROVIDED IN ACCORDANCE WITH NEC 250.166 AND GROUNDING ELECTRODE CONDUCTOR SHALL BE INSTALLED IN ACCORDANCE WITH NEC 250.64.
5. PANEL CLAW HAS A UL LISTED GROUND SYSTEM INTEGRATED INTO ITS RACKING SYSTEM. MODULE AND RACKING GROUNDING SYSTEM SHALL BE INSTALLED TO MANUFACTURER SPECIFICATIONS.

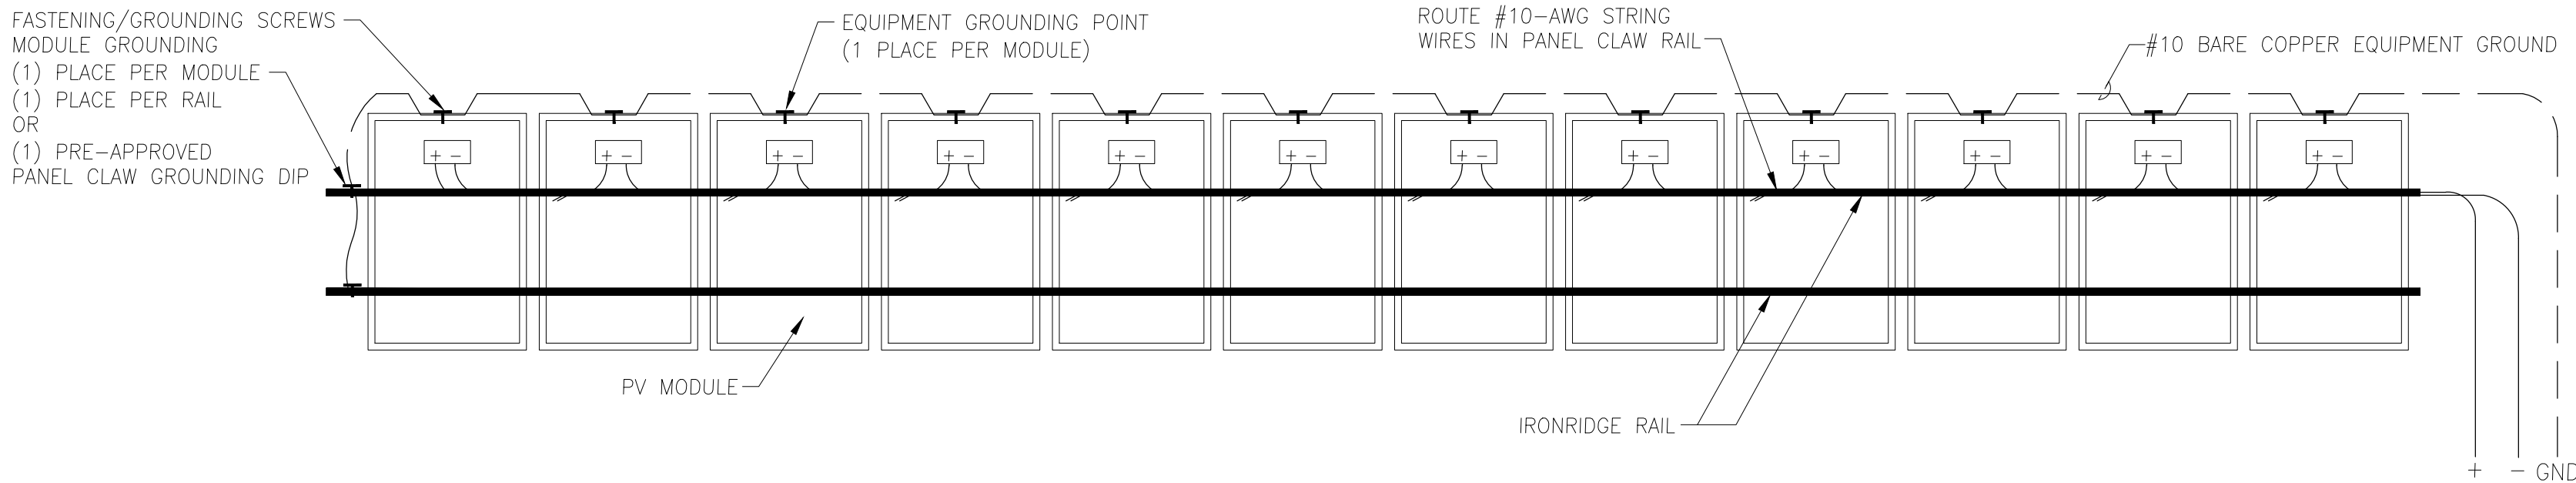


TYPICAL MODULE GROUNDING DETAIL  
NOT TO SCALE

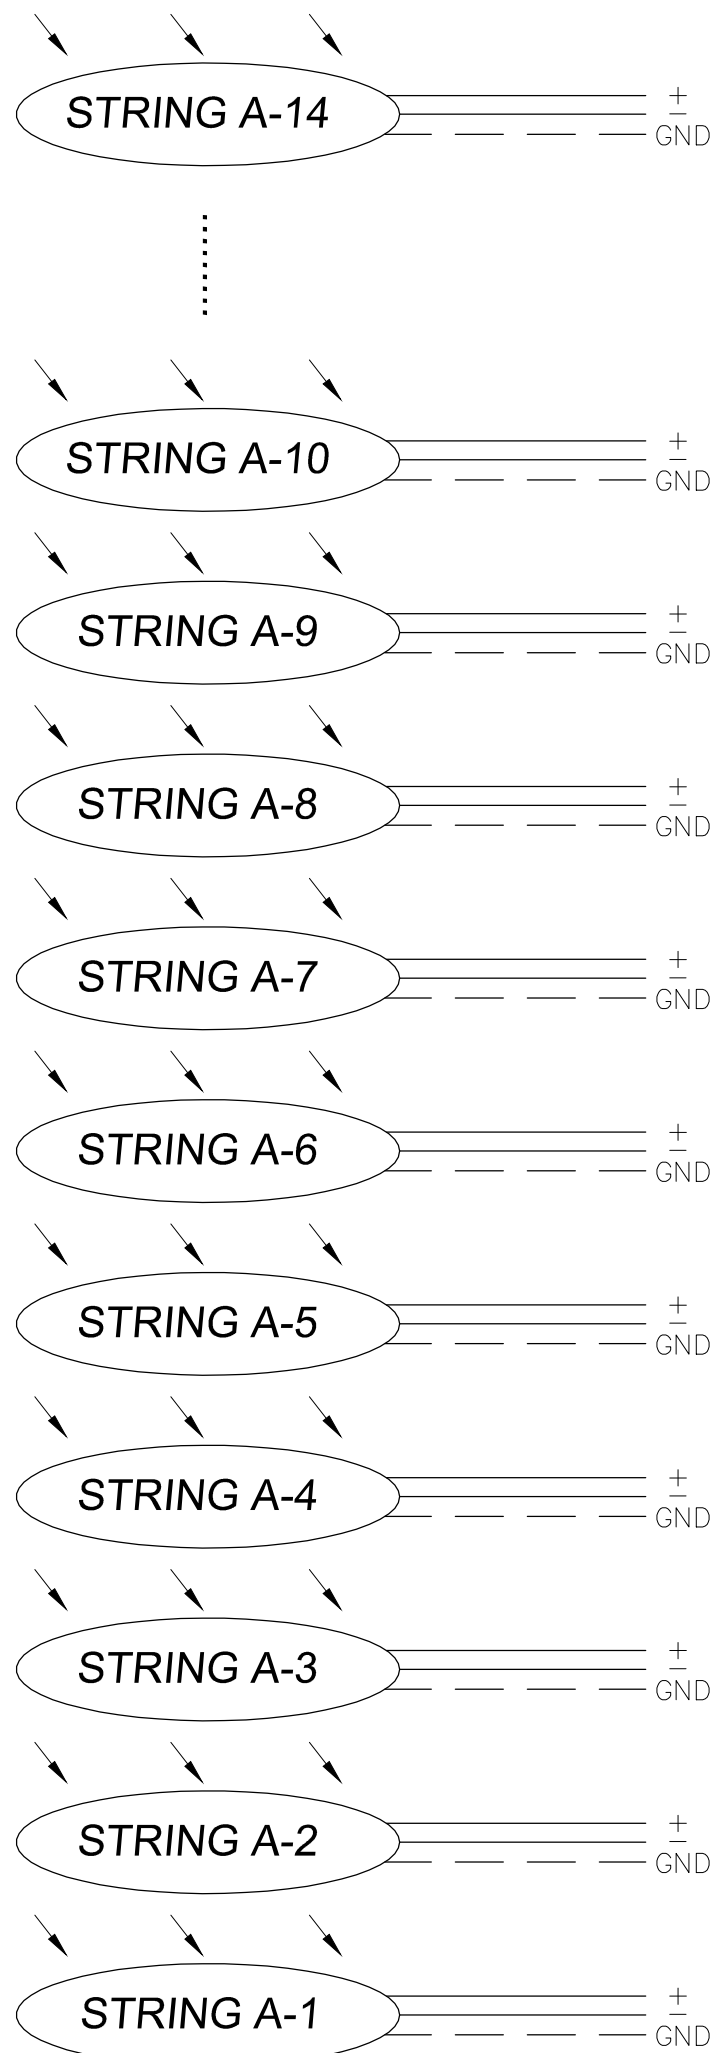


TYPICAL 10, 11, 12, 13, 14 STRING WIRING DETAIL  
NOT TO SCALE

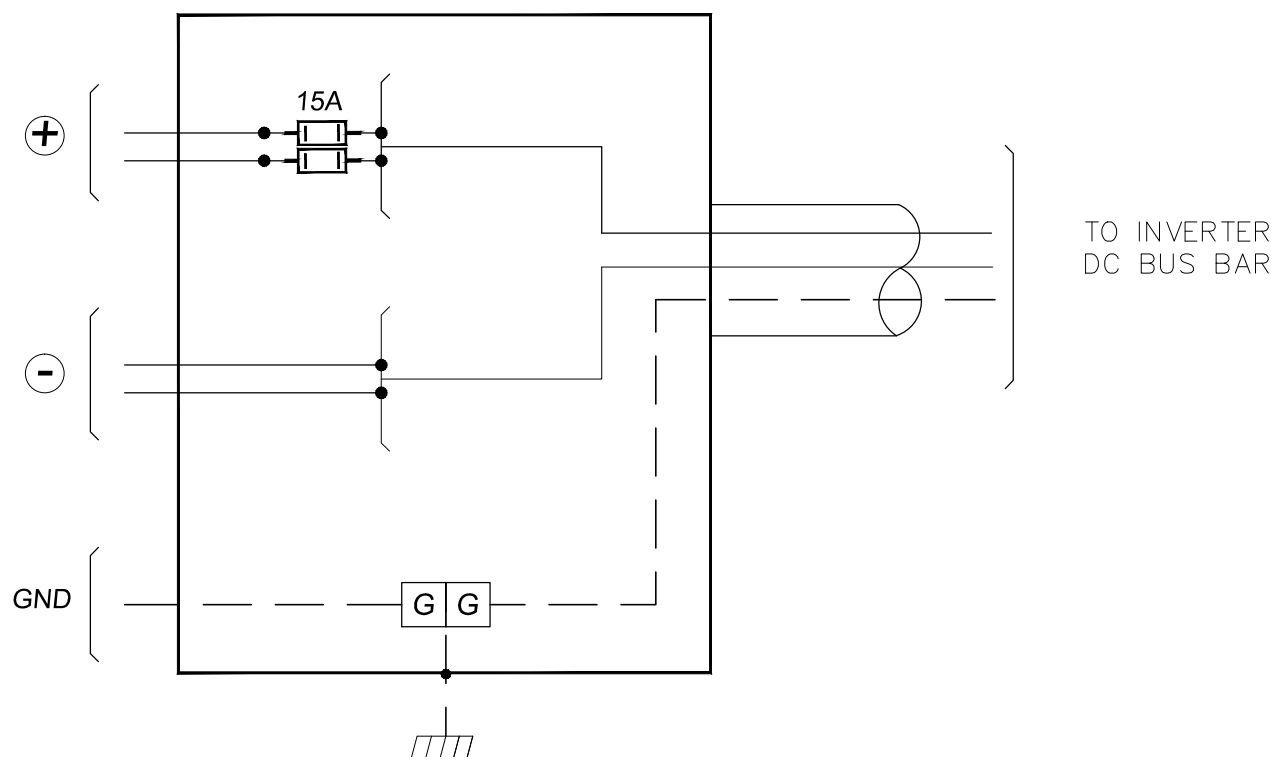


TYPICAL 2-CIRCUIT COMBINER BOX DETAIL  
NOT TO SCALE

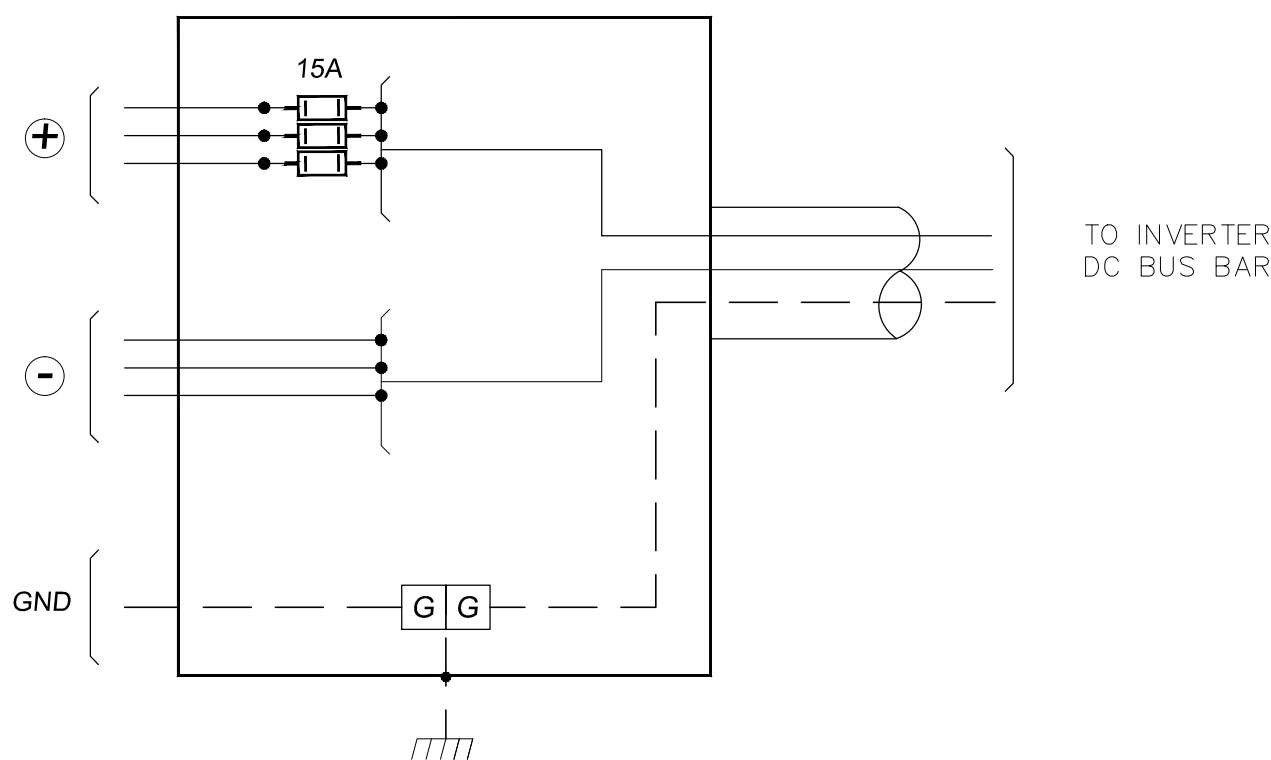

TYPICAL 3-CIRCUIT COMBINER BOX DETAIL  
NOT TO SCALE

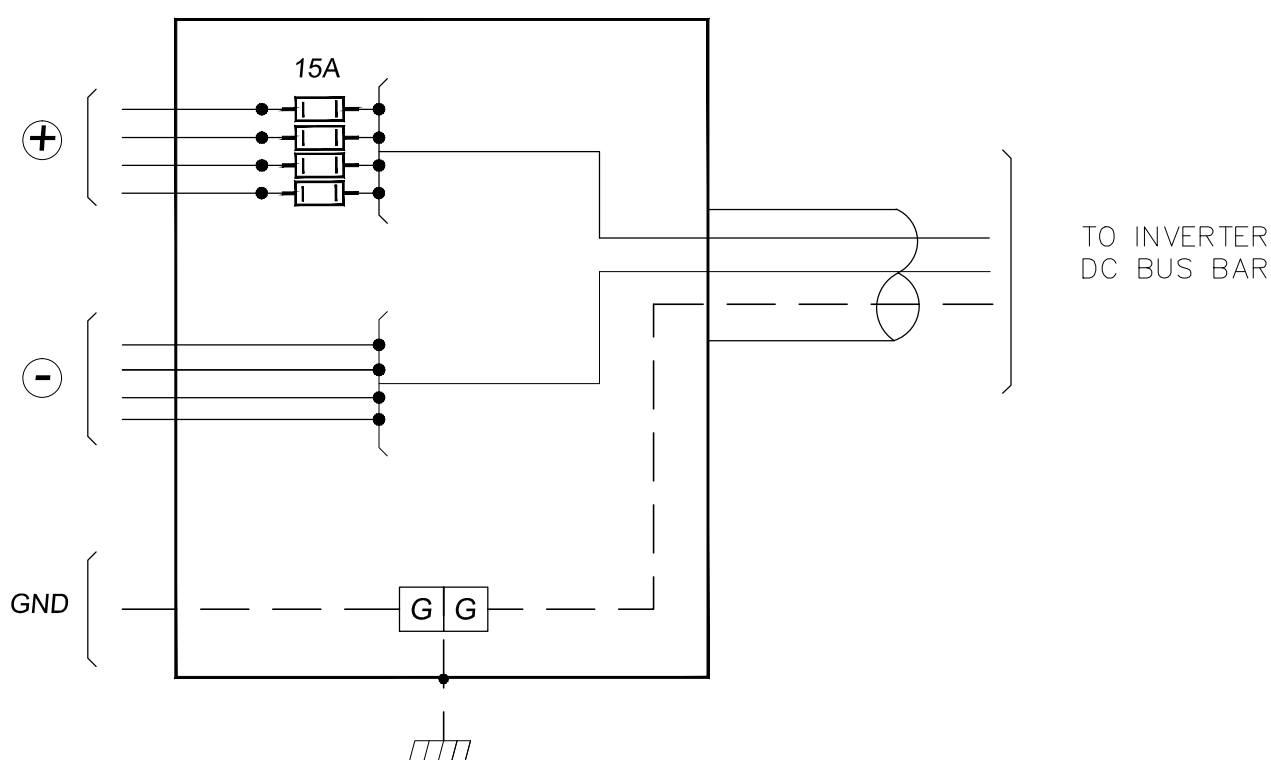

TYPICAL 4-CIRCUIT COMBINER BOX DETAIL  
NOT TO SCALE

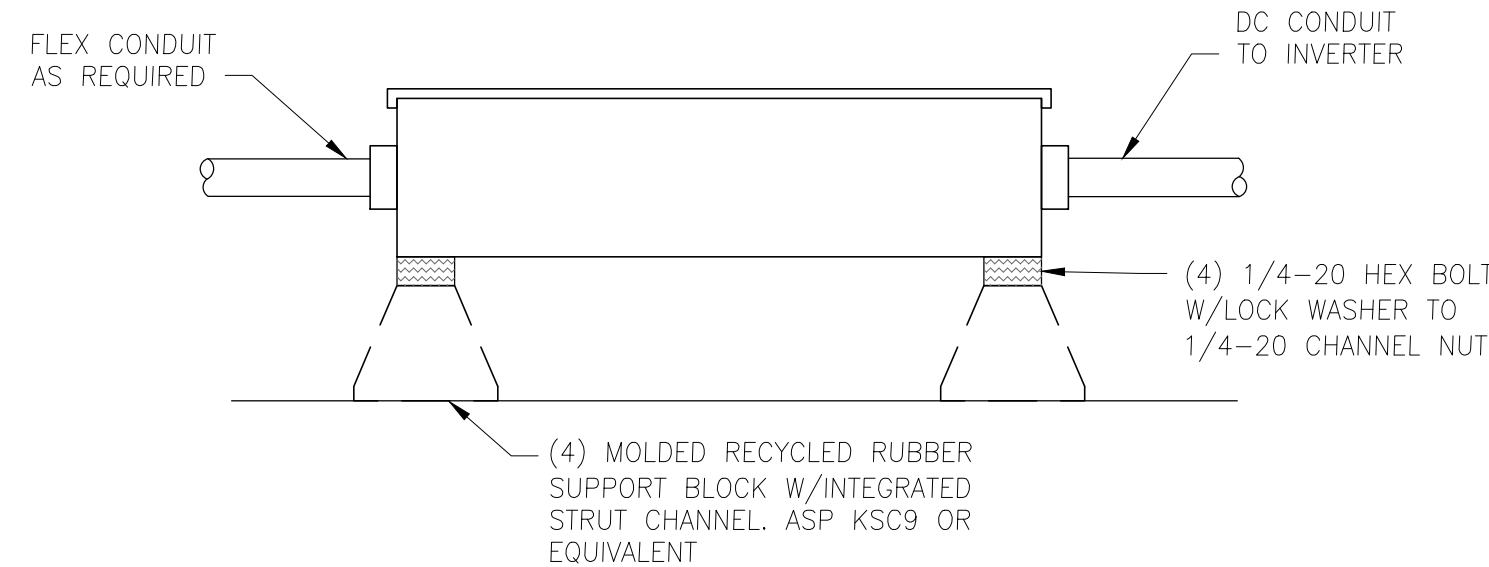

TYPICAL DC COMBINER BOX SUPPORT DETAIL  
NOT TO SCALE

DC WIRING DETAILS  
NOT TO SCALE

ENGINEER APPROVAL:



Roberto Rivera

ROBERTO RIVERA, P.E. NO. 16743

09/10/12

DATE:

| REV. | DATE     | DESCRIPTION                |
|------|----------|----------------------------|
| 1    | 9/10/12  | 100% CONSTRUCTION DRAWINGS |
| 4    | 04/09/11 | AS-BUILTS                  |

PREPARED BY:



6977 NAVAJO RD., SUITE 139  
SAN DIEGO, CA 92119  
PHONE: 858.270.9333  
FAX: 858.270.9334

THIS DOCUMENT IS CONSIDERED PROPRIETARY  
INTELLECTUAL PROPERTY AND CONTAINS PROPRIETARY  
INFORMATION. IT IS THE PROPERTY OF SUSTINEO. NO PART OF  
THIS DOCUMENT MAY BE REPRODUCED FOR ANY  
PURPOSE WITHOUT THE EXPRESS WRITTEN PERMISSION OF  
SUSTINEO CORP.

OWNER/CLIENT:

MADONNA ROAD APARTMENTS  
1550 MADONNA ROAD  
SAN LUIS OBISPO, CA 93405



EVERYDAY ENERGY  
5865 AVENIDA ENCINAS,  
SUITE 142A  
CARLSBAD, CA 92008  
P: (760) 607-7200

DC WIRING DETAILS

PHOTOVOLTAIC SYSTEM

1550 MADONNA ROAD  
SAN LUIS OBISPO, CA 93405

TITLE:

PROJECT NO.:

038 - 108

APN:

140-040-003

DATE:

SEPTEMBER 10, 2012

SHEET NO.:

E4.12

24 OF 30



MonoMultiSolutions

TSM-PC05  
TSM-PA05  
THE UNIVERSAL SOLUTION

15.3%  
MAX EFFICIENCY

250W  
MAX POWER OUTPUT

10 YEAR  
PRODUCT WARRANTY

25 YEAR  
LINEAR POWER WARRANTY

Module can bear snow loads up to 5400Pa and wind loads up to 2400Pa

Guaranteed power output 0~+3%

High performance under low light conditions  
Cloudy days, mornings and evenings

Independently certified by international certification bodies  
IEC61215, IEC61730, UL1703, TUV Safety Class II, CE

Manufactured according to International Quality and Environment Management System Standards  
ISO9001, ISO14001

Founded in 1997, Trina Solar is a vertically integrated PV manufacturer involved in the production of ingots, wafers and cells to the assembly of high quality modules, using both mono and multicrystalline technologies. As of July 2011, the Company has already achieved an annualized monocrystalline module capacity of approximately 15GW. Trina Solar's wide range of products are used in residential, commercial, industrial and public utility applications throughout the world.

Only by matching an efficient cell structure with proven performance will we as an industry achieve grid parity. And at Trina Solar, we have both.

Trina Solar Limited  
www.trinasolar.com

TrinaSolar  
The power behind the panel

LINEAR PERFORMANCE WARRANTY  
10 Year Product Warranty + 25 Year Linear Power Warranty

Guaranteed Power (W)

Additional value from Trina Solar's linear warranty

Years

Inducement created

Time Solar

panelclaw  
Securing a Brighter Future

LOWEST LIFE-CYCLE COST  
CUTTING-EDGE ENGINEERING  
WORLD-CLASS SERVICE  
ENVIRONMENTAL RESPONSIBILITY

GRIZZLY BEAR® FR Gen II  
10 Degree

PanelClaw delivers mounting and balance-of-system solutions to accelerate the adoption of photovoltaics worldwide.

SOLARBOS  
310 Stealth Court, Livermore, CA 94551  
925.456.7744 | www.solarbos.com

Compact Combiners, Fuse Boxes and Junction Boxes

SolarBOS Compact Solutions can be configured as combiners, pass-through fuse boxes or junction boxes. All three products are ETL listed to UL 1741 for 600 VDC photovoltaic systems and use compact NEMA-4X polycarbonate enclosures. They provide a low-cost and space-saving solution for residential and small commercial solar systems and can be shipped with pre-installed Multi-Contact or Tyco solar connectors.

SolarBOS Compact Combiner with Multi-Contact leads  
CCS-04-15-4XP

PRODUCT FEATURES:

• ETL listed to UL-1741

• 2 to 6 input circuits

• NEMA-4X Polycarbonate Enclosures

• Rated for 600 VDC and continuous duty

• Touch-safe fuse holders

• Can be configured with pre-installed MC or Tyco connectors

• Can be configured as combiners, pass through fuse boxes, or junction boxes

• Ground blocks included

• External mounting feet included

Made in California

SolarBOS products are designed and manufactured with the system integrator in mind, using the highest quality components to ensure long-term field reliability. All products are assembled in our ETL certified facility in Livermore, California, and we guarantee customer satisfaction.

Configure your BOS Solutions Online:  
www.solarbos.com

BALANCE OF SYSTEM PRODUCTS FOR THE SOLAR INDUSTRY

TSM-PC05 / TSM-PA05 THE UNIVERSAL SOLUTION

DIMENSIONS OF PV MODULE TSM-PC/PA 05

1460mm

660mm

34mm

4mm

3.4

1460mm

660mm

34mm

4mm

3.4

146



Maximum energy harvest – cloudy or clear

Fronius

POWERING YOUR FUTURE

Fronius IG Plus PV Inverter

The first complete solution. Reliable. Proven. Smart.

An outstanding addition to the family: The next generation Fronius IG Plus inverter builds on a successful model with multiple enhancements, including maximum power harvest, a built-in six circuit string combiner, integrated, lockable DC Disconnect, significantly improved efficiency, and unbeatable reliability. Now, larger power stages expand the proven Fronius IG family from 2 to 12 kW in a single inverter.

| INPUT DATA   | Fronius IG Plus | 3.0-1 <sub>inv</sub>  | 3.8-1 <sub>inv</sub> | 5.0-1 <sub>inv</sub>  | 6.0-1 <sub>inv</sub> | 7.5-1 <sub>inv</sub>      | 10.0-1 <sub>inv</sub> | 11.4-1 <sub>inv</sub> | 11.4-3 <sub>inv</sub> | 12.0-3 <sub>inv</sub> |
|--|-----------------|---|----------------------|-----------------------|----------------------|---------------------------|-----------------------|-----------------------|-----------------------|-----------------------|
| Recommended PV Power (Wp)  |                 | 2500-3450   | 3200-4400            | 4250-5750             | 5100-6900            | 6350-8600                 | 8500-11500            | 9700-13100            | 9700-13100            | 10200-13800           |
| MPPPT Voltage Range  |                 | 230 – 500 V   |                      |                       |                      |                           |                       |                       |                       |                       |
| DC Startup Voltage   |                 | 245 V   |                      |                       |                      |                           |                       |                       |                       |                       |
| Max. Input Voltage (at 1000 W/m²)  |                 | 600 V   |                      |                       |                      |                           |                       |                       |                       |                       |
| 147°F (+70°C) in open circuit operation  |                 |   |                      |                       |                      |                           |                       |                       |                       |                       |
| Nominal Input Current  |                 | 8.3 A   | 10.5 A               | 13.8 A                | 16.6 A               | 20.7 A                    | 27.6 A                | 31.4 A                | 31.4 A                | 33.1 A                |
| Max. usable Input Current  |                 | 14.0 A  | 17.8 A               | 23.4 A                | 28.1 A               | 35.1 A                    | 46.7 A                | 53.3 A                | 53.3 A                | 56.1 A                |
| Admissible conductor size (DC)   |                 | No. 14 – 6 AWG  |                      |                       |                      |                           |                       |                       |                       |                       |
| Number of DC Input Terminals   |                 | 6   |                      |                       |                      |                           |                       |                       |                       |                       |
| Max. Current per DC Input Terminal   |                 | 20 A; Bus bar available for higher input currents   |                      |                       |                      |                           |                       |                       |                       |                       |
| OUTPUT DATA  | Fronius IG Plus | 3.0-1 <sub>inv</sub>  | 3.8-1 <sub>inv</sub> | 5.0-1 <sub>inv</sub>  | 6.0-1 <sub>inv</sub> | 7.5-1 <sub>inv</sub>      | 10.0-1 <sub>inv</sub> | 11.4-1 <sub>inv</sub> | 11.4-3 <sub>inv</sub> | 12.0-3 <sub>inv</sub> |
| Nominal output power (P <sub>rated</sub> )   |                 | 3000 W  | 3800 W               | 5000 W                | 6000 W               | 7500 W                    | 9900 W                | 11400 W               | 11400 W               | 12000 W               |
| Max. continuous output power   |                 | 3000 W  | 3800 W               | 5000 W                | 6000 W               | 7500 W                    | 9900 W                | 11400 W               | 11400 W               | 12000 W               |
| 100% (60°C) 208 V / 240 V / 277 V  |                 | 3000 W  | 3800 W               | 5000 W                | 6000 W               | 7500 W                    | 9900 W                | 11400 W               | 11400 W               | 12000 W               |
| Nominal AC output voltage  |                 | 208 V / 240 V / 277 V   |                      |                       |                      |                           |                       |                       |                       |                       |
| Operating AC voltage range   | 208 V           |   |                      |                       |                      | 183 – 229 V (-12 / +10 %) |                       |                       |                       |                       |
| (default)  | 240 V           |   |                      |                       |                      | 211 – 264 V (-12 / +10 %) |                       |                       |                       |                       |
|  | 277 V           |   |                      |                       |                      | 244 – 305 V (-12 / +10 %) |                       |                       |                       |                       |
| Max. continuous output current   | 208 V           | 14.4 A  | 18.3 A               | 24.0 A                | 28.8 A               | 35.1 A                    | 48.1 A                | 54.8 A                | 54.8 A**              | n.a.                  |
| 240 V  | 12.5 A          | 15.8 A  | 20.8 A               | 25.0 A                | 31.3 A               | 41.7 A                    | 47.5 A                | 47.5 A**              |                       |                       |
| 277 V  | 10.8 A          | 13.7 A  | 18.1 A               | 21.7 A                | 27.1 A               | 36.1 A                    | 41.2 A                | n.a.                  | 14.4 A**              |                       |
| Admissible conductor size (AC)   |                 | No. 14 – 4 AWG  |                      |                       |                      |                           |                       |                       |                       |                       |
| Max. continuous utility back-feed current  |                 | 0 A   |                      |                       |                      |                           |                       |                       |                       |                       |
| Nominal output frequency   |                 | 60 Hz   |                      |                       |                      |                           |                       |                       |                       |                       |
| Operating frequency range  |                 | 59.3 – 60.5 Hz  |                      |                       |                      |                           |                       |                       |                       |                       |
| Total harmonic distortion  |                 | < 3 %   |                      |                       |                      |                           |                       |                       |                       |                       |
| Power factor   |                 | 1   |                      |                       |                      |                           |                       |                       |                       |                       |
| GENERAL DATA   | Fronius IG Plus | 3.0-1 <sub>inv</sub>  | 3.8-1 <sub>inv</sub> | 5.0-1 <sub>inv</sub>  | 6.0-1 <sub>inv</sub> | 7.5-1 <sub>inv</sub>      | 10.0-1 <sub>inv</sub> | 11.4-1 <sub>inv</sub> | 11.4-3 <sub>inv</sub> | 12.0-3 <sub>inv</sub> |
| Max. Efficiency  |                 | 96.2 %  |                      |                       |                      |                           |                       |                       |                       |                       |
| CEC Efficiency   | 208 V           | 95.0 %  | 95.0 %               | 95.5 %                | 95.5 %               | 95.0 %                    | 95.5 %                | 95.5 %                | 95.0 %                | n.a.                  |
|  | 240 V           | 95.5 %  | 95.5 %               | 95.5 %                | 96.0 %               | 95.5 %                    | 96.0 %                | 96.0 %                | 95.5 %                | n.a.                  |
|  | 277 V           | 95.5 %  | 95.5 %               | 96.0 %                | 96.0 %               | 96.0 %                    | 96.0 %                | 96.0 %                | n.a.                  | 96.0 %                |
| Consumption in standby (night)   |                 | < 1 W   |                      |                       |                      |                           |                       |                       |                       |                       |
| Consumption during operation   |                 | 8 W   |                      | 15 W                  |                      | 22 W                      |                       |                       |                       |                       |
| Cooling  |                 | Controlled forced ventilation, variable fan speed   |                      |                       |                      |                           |                       |                       |                       |                       |
| Enclosure type   |                 | NEMA 3R   |                      |                       |                      |                           |                       |                       |                       |                       |
| Unit Dimensions (W x H x D)  |                 | 17.1 x 24.8 x 9.6 in.   |                      | 17.1 x 38.4 x 9.6 in. |                      | 17.1 x 48.1 x 9.6 in.     |                       |                       |                       |                       |
| Power Slack Weight   |                 | 31 lbs. (14 kg)   |                      | 57 lbs. (26 kg)       |                      | 82 lbs. (37 kg)           |                       |                       |                       |                       |
| Wiring Compartment Weight  |                 | 24 lbs. (11 kg)   |                      | 26 lbs. (12 kg)       |                      | 26 lbs. (12 kg)           |                       |                       |                       |                       |
| Admissible ambient operating temperature   |                 | -41...+122°F (-20...+50°C)  |                      |                       |                      |                           |                       |                       |                       |                       |
| Compliance   |                 | UL 1741-2005, IEEE 1547-2003, IEEE 1547.1/ANSI/IEEE C92.41, FCC Part 15 A&B, NEC Article 690, C22.2 No. 107.1-01 (Sept. 2001) |                      |                       |                      |                           |                       |                       |                       |                       |
| PROTECTION DEVICES   | Fronius IG Plus | 3.0-1 <sub>inv</sub>  | 3.8-1 <sub>inv</sub> | 5.0-1 <sub>inv</sub>  | 6.0-1 <sub>inv</sub> | 7.5-1 <sub>inv</sub>      | 10.0-1 <sub>inv</sub> | 11.4-1 <sub>inv</sub> | 11.4-3 <sub>inv</sub> | 12.0-3 <sub>inv</sub> |
| Ground fault protection  |                 | Internal GFDI (Ground Fault Detector/Interrupter) in accordance with UL 1741-2005 and NEC Art. 690                            |                      |                       |                      |                           |                       |                       |                       |                       |
| DC reverse polarity protection   |                 | Internal diode  |                      |                       |                      |                           |                       |                       |                       |                       |
| Islanding protection   |                 | Internal; in accordance with UL 1741-2005, IEEE 1547-2003 and NEC   |                      |                       |                      |                           |                       |                       |                       |                       |
| Over temperature   |                 | Output power derating / active cooling  |                      |                       |                      |                           |                       |                       |                       |                       |
| * Complies with Canadian standard C22.2 No. 107.1-01 (Sept. 2001).   |                 |   |                      |                       |                      |                           |                       |                       |                       |                       |
| ** per Phase   |                 |   |                      |                       |                      |                           |                       |                       |                       |                       |
| <div><div><div><div><div></div><div>Fronius</div></div><div>POWERING YOUR FUTURE</div></div><div><div>Fronius USA LLC Solar Electronic Division</div><div>10421 Citation Drive, Suite 1100, Brighton, Michigan, 48116</div><div>E-Mail: pv-usa@fronius.com</div><div>www.fronius-usa.com</div></div></div></div> |                 |   |                      |                       |                      |                           |                       |                       |                       |                       |

www.fronius-usa.com

Connecting combined solar module strings using connecting distributors

General

If several solar module strings are combined outside of the inverter into one solar module string, the current of the solar module string can be higher than the current permitted for a DC terminal (20 A).  
  
In this case, you have the option of connecting the DC cables to the inverter using a connecting distributor.

Additional components required

The following components are required for connecting DC cables via a connecting distributor:  

- 2 connecting distributors (available from Fronius as an option)
- Cable lugs
- Select the cable lugs according to the available DC cables
- Hexagon screws
- Hexagon nuts
- that fit the cable lugs

Solar module ground

The inverter is designed for a solar module ground at the negative pole. The solar module ground is carried out via a fuse in the inverter.  
  
Solar module ground at negative pole with fuse:

Locus Energy

Product Datasheet

LGate 50

RESIDENTIAL SOLAR MONITORING SOLUTION

Locus Energy's LGate 50 is a web-enabled datalogger for monitoring residential solar photovoltaic and thermal systems. It is designed to collect, store and upload a wide array of energy data allowing both system installers and owners to efficiently manage solar assets.

The LGate 50 can be configured to monitor nearly any type of solar energy system. It has a variety of digital and analog inputs enabling direct communication with third-party devices such as inverters and solar hot water controllers/sensors. Additionally, the LGate 50 features two energy meters which measure electric loads as well as non-revenue grade AC solar generation. Performance data is aggregated and uploaded automatically to the Locus Energy Smart Monitoring website which provides custom tools and analytics to all project stakeholders.

ABOUT LOCUS

Locus Energy develops web-based asset management software for renewable energy systems. We provide monitoring, analytics and data services for deployments of solar photovoltaic and solar thermal technology. By leveraging Locus' products, renewable finance companies and integrators can drive down the cost and complexity of energy monitoring while making it much easier to maintain and service an installed client base. Founded in 2007, Locus is based in New York City and serves clientele across the world.

SOLUTIONS

Locus Energy offers Smart Monitoring software services tailored to the following groups to help maximize the performance of renewable assets:

- Installers
- Financiers
- Utilities
- OEMs
- Regulators

DATA COLLECTION

The LGate measures data from up to 15 third-party devices which is collected via RS232/485 and Modbus RTU protocols. The datalogger's energy meters measure power through feeds from current transformers combined with an inferred voltage reference from its power supply. For thermal systems, there are 6 temperature sensor inputs. All data feeds are stored in non-volatile memory and then uploaded with unique identifiers to provide maximum flexibility as to how the data is presented online.

NETWORK CONNECTIVITY

The LGate 50 is a plug and play device supporting a multitude of connectivity options. It can communicate over Ethernet, powerline carrier, or cellular networks. Data is transmitted only in outbound sessions over open ports requiring no additional network or firewall configuration. The connection and commissioning process is further simplified by the LGate's LED lights which indicate communication status without installers having to log in or call home.

DIAGRAM – TYPICAL CONFIGURATION

DIMENSIONS

SPECIFICATIONS

DATALOGGER

Processor: ARM9 embedded CPU  
OS: Custom version of Linux 2.6; OTA firmware updates  
Memory: 128 MB RAM  
Logging interval: 1 to 60 minutes, user selectable (default 5 minutes)  
Display: USB-based handheld LCD (optional)

I/O

RS485: 2 wire and 4 wire terminals  
Modbus  
RS232: serial port  
USB  
KTY Pulse  
4-20 mA analog

COMMUNICATIONS

LAN: RJ45 10/100 Ethernet, full half duplex, auto polarity  
Cellular: GSM/GPRS  
WLAN: 802.11 b/g/n, ZigBee  
Networking: DHCP or static IP

POWER METER

Voltage inputs: 120 VAC  
Phase: Single phase, Split phase at 50 or 60 Hz  
Current inputs: mV full scale output, CTs, mA output, solid/gpdt, core CTs

COMPLIANCE

IEC 61010 (Safety)  
FCC IS Part B

PHYSICAL

Enclosure: NEMA 3R Type (optional)  
Weight: 2 lbs 12 oz  
Dimensions: 6.5" L x 4" W x 2.3" H  
Environment: -20 to 60°C, 95% RH, non-condensing

ENGINEER APPROVAL:

REGISTERED PROFESSIONAL ENGINEER

ROBERTO RIVERA

NO. 16743

Exp. 9/30/12

ELECTRICAL

STATE OF CALIFORNIA

Robt Rivera

09/10/12

ROBERTO RIVERA, P.E., NO. 16743

DATE:

DESCRIPTION:

100% CONSTRUCTION DRAWINGS

DATE:

9/10/12

REV:

1

PREPARED BY:

6977 NAVAJO RD., SUITE 139  
SAN DIEGO, CA 92119  
PHONE: 858.270.9333  
FAX: 858.270.9334

THIS DOCUMENT IS CONSIDERED PROTECTED INTELLECTUAL PROPERTY AND CONTAINS PROPRIETARY INFORMATION UNDER FEDERAL STATE LAW. NO PORTION OR PART OF THIS DOCUMENT MAY BE REPRODUCED FOR ANY PURPOSE WITHOUT THE EXPRESS WRITTEN PERMISSION OF SUSTINEO CORP.

OWNER/CLIENT:

MADONNA ROAD APARTMENTS  
1550 MADONNA ROAD  
SAN LUIS OBISPO, CA 93405

EVERYDAY ENERGY

SAVE MONEY. SAVE THE PLANET.

EVERYDAY ENERGY  
5865 AVENIDA ENCINAS,  
SUITE 142A  
CARLSBAD, CA, 92008  
P: (760) 607-7200

TITLE:

PV SYSTEM DATA SHEETS

PHOTOVOLTAIC SYSTEM

PROJECT NO.:

038 – 108

APN:

140-040-003

DATE:

SEPTEMBER 10, 2012

SHEET NO.:

D5.2

26 OF 30

PROJECT LOCATION:

1550 MADONNA ROAD  
SAN LUIS OBISPO, CA 93405

100% CONSTRUCTION DRAWINGS

INVERTER DATA SHEETS

INVERTER CONNECTOR W/ COMBINER BOX

DAS MONITORING DATA SHEETS



1

6" (TYP.)

4" (TYP.)

BLACK SIGNAGE  
W/ WHITE 1/4" FONT

RED SIGNAGE  
W/ WHITE 5/16" FONT

WHITE 3/16" FONT

WHITE 1/8" FONT

DC FUSED COMBINER BOX  
'CB 1A'

WARNING

ELECTRIC SHOCK HAZARD  
DC CONDUCTORS OF THIS PV SYSTEM ARE  
UNGROUNDING AND MAY BE ENERGIZED.  
Do Not Touch, Energized Parts  
Do Not Open, Energized Parts  
Do Not Close, Energized Parts  
Do Not Short, Energized Parts  
Do Not Ground, Energized Parts

DC FUSED COMBINER BOX  
'CB 1B'

WARNING

ELECTRIC SHOCK HAZARD  
DC CONDUCTORS OF THIS PV SYSTEM ARE  
UNGROUNDING AND MAY BE ENERGIZED.  
Do Not Touch, Energized Parts  
Do Not Open, Energized Parts  
Do Not Close, Energized Parts  
Do Not Short, Energized Parts  
Do Not Ground, Energized Parts

DC FUSED COMBINER BOX  
'CB 2A'

WARNING

ELECTRIC SHOCK HAZARD  
DC CONDUCTORS OF THIS PV SYSTEM ARE  
UNGROUNDING AND MAY BE ENERGIZED.  
Do Not Touch, Energized Parts  
Do Not Open, Energized Parts  
Do Not Close, Energized Parts  
Do Not Short, Energized Parts  
Do Not Ground, Energized Parts

DC FUSED COMBINER BOX  
'CB 2B'

WARNING

ELECTRIC SHOCK HAZARD  
DC CONDUCTORS OF THIS PV SYSTEM ARE  
UNGROUNDING AND MAY BE ENERGIZED.  
Do Not Touch, Energized Parts  
Do Not Open, Energized Parts  
Do Not Close, Energized Parts  
Do Not Short, Energized Parts  
Do Not Ground, Energized Parts

DC FUSED COMBINER BOX  
'CB 3A'

WARNING

ELECTRIC SHOCK HAZARD  
DC CONDUCTORS OF THIS PV SYSTEM ARE  
UNGROUNDING AND MAY BE ENERGIZED.  
Do Not Touch, Energized Parts  
Do Not Open, Energized Parts  
Do Not Close, Energized Parts  
Do Not Short, Energized Parts  
Do Not Ground, Energized Parts

DC FUSED COMBINER BOX  
'CB 3B'

WARNING

ELECTRIC SHOCK HAZARD  
DC CONDUCTORS OF THIS PV SYSTEM ARE  
UNGROUNDING AND MAY BE ENERGIZED.  
Do Not Touch, Energized Parts  
Do Not Open, Energized Parts  
Do Not Close, Energized Parts  
Do Not Short, Energized Parts  
Do Not Ground, Energized Parts

DC FUSED COMBINER BOX  
'CB 5A'

WARNING

ELECTRIC SHOCK HAZARD  
DC CONDUCTORS OF THIS PV SYSTEM ARE  
UNGROUNDING AND MAY BE ENERGIZED.  
Do Not Touch, Energized Parts  
Do Not Open, Energized Parts  
Do Not Close, Energized Parts  
Do Not Short, Energized Parts  
Do Not Ground, Energized Parts

DC FUSED COMBINER BOX  
'CB 6A'

WARNING

ELECTRIC SHOCK HAZARD  
DC CONDUCTORS OF THIS PV SYSTEM ARE  
UNGROUNDING AND MAY BE ENERGIZED.  
Do Not Touch, Energized Parts  
Do Not Open, Energized Parts  
Do Not Close, Energized Parts  
Do Not Short, Energized Parts  
Do Not Ground, Energized Parts

DC FUSED COMBINER BOX  
'CB 6B'

WARNING

ELECTRIC SHOCK HAZARD  
DC CONDUCTORS OF THIS PV SYSTEM ARE  
UNGROUNDING AND MAY BE ENERGIZED.  
Do Not Touch, Energized Parts  
Do Not Open, Energized Parts  
Do Not Close, Energized Parts  
Do Not Short, Energized Parts  
Do Not Ground, Energized Parts

DC FUSED COMBINER BOX  
'CB 7A'

WARNING

ELECTRIC SHOCK HAZARD  
DC CONDUCTORS OF THIS PV SYSTEM ARE  
UNGROUNDING AND MAY BE ENERGIZED.  
Do Not Touch, Energized Parts  
Do Not Open, Energized Parts  
Do Not Close, Energized Parts  
Do Not Short, Energized Parts  
Do Not Ground, Energized Parts

DC FUSED COMBINER BOX  
'CB 7B'

WARNING

ELECTRIC SHOCK HAZARD  
DC CONDUCTORS OF THIS PV SYSTEM ARE  
UNGROUNDING AND MAY BE ENERGIZED.  
Do Not Touch, Energized Parts  
Do Not Open, Energized Parts  
Do Not Close, Energized Parts  
Do Not Short, Energized Parts  
Do Not Ground, Energized Parts

DC FUSED COMBINER BOX  
'CB 9A'

WARNING

ELECTRIC SHOCK HAZARD  
DC CONDUCTORS OF THIS PV SYSTEM ARE  
UNGROUNDING AND MAY BE ENERGIZED.  
Do Not Touch, Energized Parts  
Do Not Open, Energized Parts  
Do Not Close, Energized Parts  
Do Not Short, Energized Parts  
Do Not Ground, Energized Parts

DC FUSED COMBINER BOX  
'CB 10A'

WARNING

ELECTRIC SHOCK HAZARD  
DC CONDUCTORS OF THIS PV SYSTEM ARE  
UNGROUNDING AND MAY BE ENERGIZED.  
Do Not Touch, Energized Parts  
Do Not Open, Energized Parts  
Do Not Close, Energized Parts  
Do Not Short, Energized Parts  
Do Not Ground, Energized Parts

DC FUSED COMBINER BOX  
'CB 10B'

WARNING

ELECTRIC SHOCK HAZARD  
DC CONDUCTORS OF THIS PV SYSTEM ARE  
UNGROUNDING AND MAY BE ENERGIZED.  
Do Not Touch, Energized Parts  
Do Not Open, Energized Parts  
Do Not Close, Energized Parts  
Do Not Short, Energized Parts  
Do Not Ground, Energized Parts

DC FUSED COMBINER BOX  
'CB 11A'

WARNING

ELECTRIC SHOCK HAZARD  
DC CONDUCTORS OF THIS PV SYSTEM ARE  
UNGROUNDING AND MAY BE ENERGIZED.  
Do Not Touch, Energized Parts  
Do Not Open, Energized Parts  
Do Not Close, Energized Parts  
Do Not Short, Energized Parts  
Do Not Ground, Energized Parts

DC FUSED COMBINER BOX  
'CB 12A'

WARNING

ELECTRIC SHOCK HAZARD  
DC CONDUCTORS OF THIS PV SYSTEM ARE  
UNGROUNDING AND MAY BE ENERGIZED.  
Do Not Touch, Energized Parts  
Do Not Open, Energized Parts  
Do Not Close, Energized Parts  
Do Not Short, Energized Parts  
Do Not Ground, Energized Parts

DC FUSED COMBINER BOX  
'CB 12B'

WARNING

ELECTRIC SHOCK HAZARD  
DC CONDUCTORS OF THIS PV SYSTEM ARE  
UNGROUNDING AND MAY BE ENERGIZED.  
Do Not Touch, Energized Parts  
Do Not Open, Energized Parts  
Do Not Close, Energized Parts  
Do Not Short, Energized Parts  
Do Not Ground, Energized Parts

DC FUSED COMBINER BOX  
'CB 13A'

WARNING

ELECTRIC SHOCK HAZARD  
DC CONDUCTORS OF THIS PV SYSTEM ARE  
UNGROUNDING AND MAY BE ENERGIZED.  
Do Not Touch, Energized Parts  
Do Not Open, Energized Parts  
Do Not Close, Energized Parts  
Do Not Short, Energized Parts  
Do Not Ground, Energized Parts

DC FUSED COMBINER BOX  
'CB 14A'

WARNING

ELECTRIC SHOCK HAZARD  
DC CONDUCTORS OF THIS PV SYSTEM ARE  
UNGROUNDING AND MAY BE ENERGIZED.  
Do Not Touch, Energized Parts  
Do Not Open, Energized Parts  
Do Not Close, Energized Parts  
Do Not Short, Energized Parts  
Do Not Ground, Energized Parts

DC FUSED COMBINER BOX  
'CB 16A'

WARNING

ELECTRIC SHOCK HAZARD  
DC CONDUCTORS OF THIS PV SYSTEM ARE  
UNGROUNDING AND MAY BE ENERGIZED.  
Do Not Touch, Energized Parts  
Do Not Open, Energized Parts  
Do Not Close, Energized Parts  
Do Not Short, Energized Parts  
Do Not Ground, Energized Parts

DC FUSED COMBINER BOX  
'CB 16B'

WARNING

ELECTRIC SHOCK HAZARD  
DC CONDUCTORS OF THIS PV SYSTEM ARE  
UNGROUNDING AND MAY BE ENERGIZED.  
Do Not Touch, Energized Parts  
Do Not Open, Energized Parts  
Do Not Close, Energized Parts  
Do Not Short, Energized Parts  
Do Not Ground, Energized Parts

DC FUSED COMBINER BOX  
'CB 17A'

WARNING

ELECTRIC SHOCK HAZARD  
DC CONDUCTORS OF THIS PV SYSTEM ARE  
UNGROUNDING AND MAY BE ENERGIZED.  
Do Not Touch, Energized Parts  
Do Not Open, Energized Parts  
Do Not Close, Energized Parts  
Do Not Short, Energized Parts  
Do Not Ground, Energized Parts

DC FUSED COMBINER BOX  
'CB 17B'

WARNING

ELECTRIC SHOCK HAZARD  
DC CONDUCTORS OF THIS PV SYSTEM ARE  
UNGROUNDING AND MAY BE ENERGIZED.  
Do Not Touch, Energized Parts  
Do Not Open, Energized Parts  
Do Not Close, Energized Parts  
Do Not Short, Energized Parts  
Do Not Ground, Energized Parts

DC FUSED COMBINER BOX  
'CB 18A'

WARNING

ELECTRIC SHOCK HAZARD  
DC CONDUCTORS OF THIS PV SYSTEM ARE  
UNGROUNDING AND MAY BE ENERGIZED.  
Do Not Touch, Energized Parts  
Do Not Open, Energized Parts  
Do Not Close, Energized Parts  
Do Not Short, Energized Parts  
Do Not Ground, Energized Parts

DC FUSED COMBINER BOX  
'CB 18B'

WARNING

ELECTRIC SHOCK HAZARD  
DC CONDUCTORS OF THIS PV SYSTEM ARE  
UNGROUNDING AND MAY BE ENERGIZED.  
Do Not Touch, Energized Parts  
Do Not Open, Energized Parts  
Do Not Close, Energized Parts  
Do Not Short, Energized Parts  
Do Not Ground, Energized Parts

DC FUSED COMBINER BOX  
'CB 19A'

WARNING

ELECTRIC SHOCK HAZARD  
DC CONDUCTORS OF THIS PV SYSTEM ARE  
UNGROUNDING AND MAY BE ENERGIZED.  
Do Not Touch, Energized Parts  
Do Not Open, Energized Parts  
Do Not Close, Energized Parts  
Do Not Short, Energized Parts  
Do Not Ground, Energized Parts

DC FUSED COMBINER BOX  
'CB 19B'

WARNING

ELECTRIC SHOCK HAZARD  
DC CONDUCTORS OF THIS PV SYSTEM ARE  
UNGROUNDING AND MAY BE ENERGIZED.  
Do Not Touch, Energized Parts  
Do Not Open, Energized Parts  
Do Not Close, Energized Parts  
Do Not Short, Energized Parts  
Do Not Ground, Energized Parts

DC COMBINER BOX IDENTIFICATION PLACARDS

12" TYP.

8" TYP.

BLACK SIGNAGE  
W/ WHITE 3/8" FONT

RED SIGNAGE  
W/ WHITE 3/4" FONT

WHITE 5/16" FONT

WHITE 3/16" FONT

INVERTER ASSEMBLY  
'1A'

DANGER

HIGH VOLTAGE  
RISK OF ELECTRIC SHOCK  
Authorized Service Personnel Only.

Interactive System Point of Interconnection:  
Rated AC Output Current: 42 A  
Nominal Operating AC Voltage: 240 V  
Maximum AC Continuous Power: 10.0 kW

INVERTER ASSEMBLY  
'1B'

DANGER

HIGH VOLTAGE  
RISK OF ELECTRIC SHOCK  
Authorized Service Personnel Only.

Interactive System Point of Interconnection:  
Rated AC Output Current: 31 A  
Nominal Operating AC Voltage: 240 V  
Maximum AC Continuous Power: 7.5 kW

INVERTER ASSEMBLY  
'2A'

DANGER

HIGH VOLTAGE  
RISK OF ELECTRIC SHOCK  
Authorized Service Personnel Only.

Interactive System Point of Interconnection:  
Rated AC Output Current: 25 A  
Nominal Operating AC Voltage: 240 V  
Maximum AC Continuous Power: 6.0 kW

INVERTER ASSEMBLY  
'2B'

DANGER

HIGH VOLTAGE  
RISK OF ELECTRIC SHOCK  
Authorized Service Personnel Only.

Interactive System Point of Interconnection:  
Rated AC Output Current: 13 A  
Nominal Operating AC Voltage: 240 V  
Maximum AC Continuous Power: 3.0 kW

INVERTER ASSEMBLY  
'3A'

DANGER

HIGH VOLTAGE  
RISK OF ELECTRIC SHOCK  
Authorized Service Personnel Only.

Interactive System Point of Interconnection:  
Rated AC Output Current: 31 A  
Nominal Operating AC Voltage: 240 V  
Maximum AC Continuous Power: 7.5 kW

INVERTER ASSEMBLY  
'3B'

DANGER

HIGH VOLTAGE  
RISK OF ELECTRIC SHOCK  
Authorized Service Personnel Only.

Interactive System Point of Interconnection:  
Rated AC Output Current: 25 A  
Nominal Operating AC Voltage: 240 V  
Maximum AC Continuous Power: 6.0 kW

INVERTER ASSEMBLY  
'4A'

DANGER

HIGH VOLTAGE  
RISK OF ELECTRIC SHOCK  
Authorized Service Personnel Only.

Interactive System Point of Interconnection:  
Rated AC Output Current: 13 A  
Nominal Operating AC Voltage: 240 V  
Maximum AC Continuous Power: 3.0 kW

INVERTER ASSEMBLY  
'5A'

DANGER

HIGH VOLTAGE  
RISK OF ELECTRIC SHOCK  
Authorized Service Personnel Only.

Interactive System Point of Interconnection:  
Rated AC Output Current: 25 A  
Nominal Operating AC Voltage: 240 V  
Maximum AC Continuous Power: 6.0 kW

INVERTER ASSEMBLY  
'6A'

DANGER

HIGH VOLTAGE  
RISK OF ELECTRIC SHOCK  
Authorized Service Personnel Only.

Interactive System Point of Interconnection:  
Rated AC Output Current: 13 A  
Nominal Operating AC Voltage: 240 V  
Maximum AC Continuous Power: 3.0 kW

INVERTER ASSEMBLY  
'6B'

DANGER

HIGH VOLTAGE  
RISK OF ELECTRIC SHOCK  
Authorized Service Personnel Only.

Interactive System Point of Interconnection:  
Rated AC Output Current: 31 A  
Nominal Operating AC Voltage: 240 V  
Maximum AC Continuous Power: 7.5 kW

INVERTER ASSEMBLY  
'7A'

DANGER

HIGH VOLTAGE  
RISK OF ELECTRIC SHOCK  
Authorized Service Personnel Only.

Interactive System Point of Interconnection:  
Rated AC Output Current: 25 A  
Nominal Operating AC Voltage: 240 V  
Maximum AC Continuous Power: 6.0 kW

INVERTER ASSEMBLY  
'7B'

DANGER

HIGH VOLTAGE  
RISK OF ELECTRIC SHOCK  
Authorized Service Personnel Only.

Interactive System Point of Interconnection:  
Rated AC Output Current: 13 A  
Nominal Operating AC Voltage: 240 V  
Maximum AC Continuous Power: 3.0 kW

INVERTER ASSEMBLY  
'9A'

DANGER

HIGH VOLTAGE  
RISK OF ELECTRIC SHOCK  
Authorized Service Personnel Only.

Interactive System Point of Interconnection:  
Rated AC Output Current: 31 A  
Nominal Operating AC Voltage: 240 V  
Maximum AC Continuous Power: 7.5 kW

INVERTER ASSEMBLY  
'10A'

DANGER

HIGH VOLTAGE  
RISK OF ELECTRIC SHOCK  
Authorized Service Personnel Only.

Interactive System Point of Interconnection:  
Rated AC Output Current: 42 A  
Nominal Operating AC Voltage: 240 V  
Maximum AC Continuous Power: 10.0 kW

INVERTER ASSEMBLY  
'10B'

DANGER

HIGH VOLTAGE  
RISK OF ELECTRIC SHOCK  
Authorized Service Personnel Only.

Interactive System Point of Interconnection:  
Rated AC Output Current: 42 A  
Nominal Operating AC Voltage: 240 V  
Maximum AC Continuous Power: 10.0 kW

PLACARD & 2011 NEC IDENTIFICATION NOTES:

- 1 - 19

4 - 6

7

8
- 9

10

11

12
- INSTALL ON CORRESPONDING COMBINER BOXES - NEC 690.17 & 690.53

INSTALL ON CORRESPONDING INVERTER ASSEMBLIES - NEC 690.17 & 690.53

MANUFACTURE THREE PLACARDS. INSTALL ONE ON EACH AC/UTILITY DISCONNECT SWITCH CORRESPONDING TO EACH INVERTER.

MANUFACTURE THREE PLACARDS. INSTALL NEXT TO GROUND FAULT INDICATOR - NEC 690.5 (C)

MANUFACTURE THREE PLACARDS. INSTALL ON MAIN LOAD PANEL ADJACENT TO INTERCONNECTION POINT - NEC 690.4 (B)4

MANUFACTURE THREE PLACARDS. INSTALL ON OUTSIDE OF BUILDING ADJACENT TO UTILITY OWNED EQUIPMENT OR INTERCONNECTION POINT - NEC 690.56

MANUFACTURE THREE PLACARDS. INSTALL ON VISIBLE BLADE DISCONNECT - NEC 690.4 (B)7

MANUFACTURE THREE PLACARDS. INSTALL ON INVERTER ASSEMBLY

GENERAL EQUIPMENT NOTES:

- THE PLACARDS SHALL BE METAL OR PLASTIC WITH ENGRAVED OR MACHINE PRINTED LETTERS OR ELECTRO-PHOTO PLATING IN A CONTRASTING COLOR TO THE PLAQUE.
- PLAQUES SHALL BE ATTACHED TO THE EXTERIOR OF THE EQUIPMENT ENCLOSURE WITH POP RIVETS, MACHINE SCREWS, OR OTHER FASTENERS ACCEPTABLE TO THE AHJ.

ENGINEER APPROVAL:



Roberto Rivera  
ROBERTO RIVERA, P.E. NO. 16743 DATE: 09/10/12

| REV. | DATE    | DESCRIPTION                |
|------|---------|----------------------------|
| 1    | 9/10/12 | 100% CONSTRUCTION DRAWINGS |

PREPARED BY:



6977 NAVAJO RD., SUITE 139  
SAN DIEGO, CA 92119  
PHONE: 858.270.9333  
FAX: 858.270.9334

THIS DOCUMENT IS CONSIDERED PROTECTED INTELLECTUAL PROPERTY. AND CONTAINS PROPRIETARY INFORMATION UNDER FEDERAL, STATE, AND LOCAL LAWS. NO PART OF THIS DOCUMENT MAY BE REPRODUCED OR TRANSMITTED IN ANY FORM OR BY ANY MEANS, WITHOUT THE WRITTEN PERMISSION OF SUSTINED CORP.

OWNER/CLIENT:

MADONNA ROAD APARTMENTS  
1550 MADONNA ROAD  
SAN LUIS OBISPO, CA 93405



EVERYDAY ENERGY  
5865 AVENIDA ENCINAS,  
SUITE 142A  
CARLSBAD, CA, 92008  
P: (760) 607-7200

PV IDENTIFICATION PLACARDS

PHOTOVOLTAIC SYSTEM

1550 MADONNA ROAD  
SAN LUIS OBISPO, CA 93405

|            |                        |
|------------|------------------------|
| TITLE:     | PROJECT NO.: 038 - 108 |
| APN:       | 140-040-003            |
| DATE:      | SEPTEMBER 10, 2012     |
| SHEET NO.: | P6.1<br>27 OF 30       |

100% CONSTRUCTION DRAWINGS

INVERTER ASSEMBLY IDENTIFICATION PLACARDS



INVERTER ASSEMBLY  
'11A'

**DANGER**

HIGH VOLTAGE  
RISK OF ELECTRIC SHOCK  
Authorized Service Personnel Only.

*Interactive System Point of Interconnection:*  
Rated AC Output Current: 31 A  
Nominal Operating AC Voltage: 240 V  
Maximum AC Continuous Power: 7.5 kW

INVERTER ASSEMBLY  
'12A'

**DANGER**

HIGH VOLTAGE  
RISK OF ELECTRIC SHOCK  
Authorized Service Personnel Only.

*Interactive System Point of Interconnection:*  
Rated AC Output Current: 25 A  
Nominal Operating AC Voltage: 240 V  
Maximum AC Continuous Power: 6.0 kW

INVERTER ASSEMBLY  
'12B'

**DANGER**

HIGH VOLTAGE  
RISK OF ELECTRIC SHOCK  
Authorized Service Personnel Only.

*Interactive System Point of Interconnection:*  
Rated AC Output Current: 25 A  
Nominal Operating AC Voltage: 240 V  
Maximum AC Continuous Power: 6.0 kW

INVERTER ASSEMBLY  
'13A'

**DANGER**

HIGH VOLTAGE  
RISK OF ELECTRIC SHOCK  
Authorized Service Personnel Only.

*Interactive System Point of Interconnection:*  
Rated AC Output Current: 25 A  
Nominal Operating AC Voltage: 240 V  
Maximum AC Continuous Power: 6.0 kW

INVERTER ASSEMBLY  
'14A'

**DANGER**

HIGH VOLTAGE  
RISK OF ELECTRIC SHOCK  
Authorized Service Personnel Only.

*Interactive System Point of Interconnection:*  
Rated AC Output Current: 25 A  
Nominal Operating AC Voltage: 240 V  
Maximum AC Continuous Power: 6.0 kW

INVERTER ASSEMBLY  
'15A'

**DANGER**

HIGH VOLTAGE  
RISK OF ELECTRIC SHOCK  
Authorized Service Personnel Only.

*Interactive System Point of Interconnection:*  
Rated AC Output Current: 13 A  
Nominal Operating AC Voltage: 240 V  
Maximum AC Continuous Power: 3.0 kW

INVERTER ASSEMBLY  
'16A'

**DANGER**

HIGH VOLTAGE  
RISK OF ELECTRIC SHOCK  
Authorized Service Personnel Only.

*Interactive System Point of Interconnection:*  
Rated AC Output Current: 31 A  
Nominal Operating AC Voltage: 240 V  
Maximum AC Continuous Power: 7.5 kW

INVERTER ASSEMBLY  
'16B'

**DANGER**

HIGH VOLTAGE  
RISK OF ELECTRIC SHOCK  
Authorized Service Personnel Only.

*Interactive System Point of Interconnection:*  
Rated AC Output Current: 31 A  
Nominal Operating AC Voltage: 240 V  
Maximum AC Continuous Power: 7.5 kW

INVERTER ASSEMBLY  
'17A'

**DANGER**

HIGH VOLTAGE  
RISK OF ELECTRIC SHOCK  
Authorized Service Personnel Only.

*Interactive System Point of Interconnection:*  
Rated AC Output Current: 42 A  
Nominal Operating AC Voltage: 240 V  
Maximum AC Continuous Power: 10.0 kW

INVERTER ASSEMBLY  
'17B'

**DANGER**

HIGH VOLTAGE  
RISK OF ELECTRIC SHOCK  
Authorized Service Personnel Only.

*Interactive System Point of Interconnection:*  
Rated AC Output Current: 42 A  
Nominal Operating AC Voltage: 240 V  
Maximum AC Continuous Power: 10.0 kW

INVERTER ASSEMBLY  
'18A'

**DANGER**

HIGH VOLTAGE  
RISK OF ELECTRIC SHOCK  
Authorized Service Personnel Only.

*Interactive System Point of Interconnection:*  
Rated AC Output Current: 25 A  
Nominal Operating AC Voltage: 240 V  
Maximum AC Continuous Power: 6.0 kW

INVERTER ASSEMBLY  
'18B'

**DANGER**

HIGH VOLTAGE  
RISK OF ELECTRIC SHOCK  
Authorized Service Personnel Only.

*Interactive System Point of Interconnection:*  
Rated AC Output Current: 13 A  
Nominal Operating AC Voltage: 240 V  
Maximum AC Continuous Power: 3.0 kW

INVERTER ASSEMBLY  
'19A'

**DANGER**

HIGH VOLTAGE  
RISK OF ELECTRIC SHOCK  
Authorized Service Personnel Only.

*Interactive System Point of Interconnection:*  
Rated AC Output Current: 45 A  
Nominal Operating AC Voltage: 240 V  
Maximum AC Continuous Power: 11.4 kW

INVERTER ASSEMBLY  
'19B'

**DANGER**

HIGH VOLTAGE  
RISK OF ELECTRIC SHOCK  
Authorized Service Personnel Only.

*Interactive System Point of Interconnection:*  
Rated AC Output Current: 25 A  
Nominal Operating AC Voltage: 240 V  
Maximum AC Continuous Power: 6.0 kW

GENERAL EQUIPMENT NOTES:

- THE PLACARDS SHALL BE METAL OR PLASTIC WITH ENGRAVED OR MACHINE PRINTED LETTERS OR ELECTRO-PHOTO PLATING IN A CONTRASTING COLOR TO THE PLAQUE.
- PLAQUES SHALL BE ATTACHED TO THE EXTERIOR OF THE EQUIPMENT ENCLOSURE WITH POP RIVETS, MACHINE SCREWS, OR OTHER FASTENERS ACCEPTABLE TO THE AHJ.

ENGINEER APPROVAL:



Roberto Rivera

ROBERTO RIVERA, P.E. NO. 16743

09/10/12

DATE:

| DESCRIPTION:               | DATE:   | REV. |
|----------------------------|---------|------|
| 100% CONSTRUCTION DRAWINGS | 9/10/12 | 1    |

PREPARED BY:



6977 NAVAJO RD., SUITE 139  
SAN DIEGO, CA 92119  
PHONE: 858.270.9333  
FAX: 858.270.9334

THIS DOCUMENT IS CONSIDERED PROTECTED  
INTELLECTUAL PROPERTY AND CONTAINS PROPRIETARY  
INFORMATION UNDER UNITED STATES LAW. NO PORTION OR  
PART OF THIS DOCUMENT MAY BE REPRODUCED OR FOR ANY  
PERSON WITHOUT THE EXPRESS WRITTEN PERMISSION OF  
SUSTINED CORP.

OWNER/CLIENT:

MADONNA ROAD APARTMENTS  
1550 MADONNA ROAD  
SAN LUIS OBISPO, CA 93405



EVERYDAY ENERGY  
5865 AVENIDA ENCINAS,  
SUITE 142A  
CARLSBAD, CA, 92008  
P: (760) 607-7200

INVERTER ASSEMBLY IDENTIFICATION PLACARDS

BLACK SIGNAGE  
W/ WHITE 3/8" FONT

RED SIGNAGE  
W/ WHITE 3/4" FONT

WHITE 5/16" FONT

WHITE 3/16" FONT

10"

6"

PV SYSTEM DISCONNECT SWITCH  
FOR UTILITY OPERATION  
BUILDING 1

**WARNING**

- RISK OF ELECTRIC SHOCK -

*Interactive System Point of Interconnection Ratings:*  
Rated AC Output Current: 75 A  
Nominal AC Operating Voltage: 240 V  
Maximum AC Continuous Power: 17.5 kW

PV SYSTEM DISCONNECT SWITCH  
FOR UTILITY OPERATION  
BUILDING 2

**WARNING**

- RISK OF ELECTRIC SHOCK -

*Interactive System Point of Interconnection Ratings:*  
Rated AC Output Current: 38 A  
Nominal AC Operating Voltage: 240 V  
Maximum AC Continuous Power: 9.0 kW

PV SYSTEM DISCONNECT SWITCH  
FOR UTILITY OPERATION  
BUILDING 3

**WARNING**

- RISK OF ELECTRIC SHOCK -

*Interactive System Point of Interconnection Ratings:*  
Rated AC Output Current: 62 A  
Nominal AC Operating Voltage: 240 V  
Maximum AC Continuous Power: 15.0 kW

PV SYSTEM DISCONNECT SWITCH  
FOR UTILITY OPERATION  
BUILDING 4

**WARNING**

- RISK OF ELECTRIC SHOCK -

*Interactive System Point of Interconnection Ratings:*  
Rated AC Output Current: 13 A  
Nominal AC Operating Voltage: 240 V  
Maximum AC Continuous Power: 3.0 kW

PLACARD & 2011 NEC IDENTIFICATION NOTES:

- 1 - 3 INSTALL ON CORRESPONDING COMBINER BOXES - NEC 690.17 & 690.53
- 4 - 6 INSTALL ON CORRESPONDING INVERTER ASSEMBLIES - NEC 690.17 & 690.53
- 7 MANUFACTURE THREE PLACARDS. INSTALL ONE ON EACH AC/UTILITY DISCONNECT SWITCH CORRESPONDING TO EACH INVERTER.
- 8 MANUFACTURE THREE PLACARDS. INSTALL NEXT TO GROUND FAULT INDICATOR - NEC 690.5 (C)
- 9 MANUFACTURE THREE PLACARDS. INSTALL ON MAIN LOAD PANEL ADJACENT TO INTERCONNECTION POINT - NEC 690.4 (B)4
- 10 MANUFACTURE THREE PLACARDS. INSTALL ON OUTSIDE OF BUILDING ADJACENT TO UTILITY OWNED EQUIPMENT OR INTERCONNECTION POINT - NEC 690.56
- 11 MANUFACTURE THREE PLACARDS. INSTALL ON VISIBLE BLADE DISCONNECT - NEC 690.4 (B)7
- 12 MANUFACTURE THREE PLACARDS. INSTALL ON INVERTER ASSEMBLY

PV SYSTEM DISCONNECT SWITCH  
FOR UTILITY OPERATION  
BUILDING 5

**WARNING**

- RISK OF ELECTRIC SHOCK -

*Interactive System Point of Interconnection Ratings:*  
Rated AC Output Current: 31 A  
Nominal AC Operating Voltage: 240 V  
Maximum AC Continuous Power: 7.5 kW

PV SYSTEM DISCONNECT SWITCH  
FOR UTILITY OPERATION  
BUILDING 6

**WARNING**

- RISK OF ELECTRIC SHOCK -

*Interactive System Point of Interconnection Ratings:*  
Rated AC Output Current: 50 A  
Nominal AC Operating Voltage: 240 V  
Maximum AC Continuous Power: 12.0 kW

PV SYSTEM DISCONNECT SWITCH  
FOR UTILITY OPERATION  
BUILDING 7

**WARNING**

- RISK OF ELECTRIC SHOCK -

*Interactive System Point of Interconnection Ratings:*  
Rated AC Output Current: 50 A  
Nominal AC Operating Voltage: 240 V  
Maximum AC Continuous Power: 12.0 kW

PV SYSTEM DISCONNECT SWITCH  
FOR UTILITY OPERATION  
BUILDING 9

**WARNING**

- RISK OF ELECTRIC SHOCK -

*Interactive System Point of Interconnection Ratings:*  
Rated AC Output Current: 25 A  
Nominal AC Operating Voltage: 240 V  
Maximum AC Continuous Power: 7.5 kW

PV SYSTEM DISCONNECT SWITCH  
FOR UTILITY OPERATION  
BUILDING 10

**WARNING**

- RISK OF ELECTRIC SHOCK -

*Interactive System Point of Interconnection Ratings:*  
Rated AC Output Current: 84 A  
Nominal AC Operating Voltage: 240 V  
Maximum AC Continuous Power: 20.0 kW

PV SYSTEM DISCONNECT SWITCH  
FOR UTILITY OPERATION  
BUILDING 11

**WARNING**

- RISK OF ELECTRIC SHOCK -

*Interactive System Point of Interconnection Ratings:*  
Rated AC Output Current: 31 A  
Nominal AC Operating Voltage: 240 V  
Maximum AC Continuous Power: 7.5 kW

PV SYSTEM DISCONNECT SWITCH  
FOR UTILITY OPERATION  
BUILDING 12

**WARNING**

- RISK OF ELECTRIC SHOCK -

*Interactive System Point of Interconnection Ratings:*  
Rated AC Output Current: 50 A  
Nominal AC Operating Voltage: 240 V  
Maximum AC Continuous Power: 12.0 kW

PV SYSTEM DISCONNECT SWITCH  
FOR UTILITY OPERATION  
BUILDING 13

**WARNING**

- RISK OF ELECTRIC SHOCK -

*Interactive System Point of Interconnection Ratings:*  
Rated AC Output Current: 25 A  
Nominal AC Operating Voltage: 240 V  
Maximum AC Continuous Power: 6.0 kW

UTILITY DISCONNECT PLACARDS

TITLE:  
PV IDENTIFICATION PLACARDS

PHOTOVOLTAIC SYSTEM

PROJECT LOCATION:  
1550 MADONNA ROAD  
SAN LUIS OBISPO, CA 93405

PROJECT NO.: 038 - 108

APN: 140-040-003

DATE: SEPTEMBER 10, 2012

SHEET NO.:

P6.2

28 OF 30

100% CONSTRUCTION DRAWINGS



PV SYSTEM DISCONNECT SWITCH  
FOR UTILITY OPERATION  
BUILDING 14

**WARNING**

- RISK OF ELECTRIC SHOCK -

Interactive System Point of Interconnection Ratings:

|                               |        |
|-------------------------------|--------|
| Rated AC Output Current:      | 25 A   |
| Nominal AC Operating Voltage: | 240 V  |
| Maximum AC Continuous Power:  | 6.0 kW |

**PV SYSTEM DISCONNECT SWITCH  
FOR UTILITY OPERATION  
BUILDING 15**

**WARNING**

**- RISK OF ELECTRIC SHOCK -**

Interactive System Point of Interconnection Ratings:

|                               |        |
|-------------------------------|--------|
| Rated AC Output Current:      | 13 A   |
| Nominal AC Operating Voltage: | 240 V  |
| Maximum AC Continuous Power:  | 3.0 kW |

**PV SYSTEM DISCONNECT SWITCH  
FOR UTILITY OPERATION  
BUILDING 16**

**WARNING**

**- RISK OF ELECTRIC SHOCK -**

Interactive System Point of Interconnection Ratings:

- Rated AC Output Current: 62 A
- Nominal AC Operating Voltage: 240 V
- Maximum AC Continuous Power: 15.0 kW

**PV SYSTEM DISCONNECT SWITCH  
FOR UTILITY OPERATION  
BUILDING 17**

**WARNING**

**- RISK OF ELECTRIC SHOCK -**

Interactive System Point of Interconnection Ratings:

- Rated AC Output Current: 85 A
- Nominal AC Operating Voltage: 240 V
- Maximum AC Continuous Power: 20.0 kW

**PV SYSTEM DISCONNECT SWITCH  
FOR UTILITY OPERATION**

**BUILDING 18**

**WARNING**

**- RISK OF ELECTRIC SHOCK -**

Interactive System Point of Interconnection Ratings:

|                               |        |
|-------------------------------|--------|
| Rated AC Output Current:      | 33 A   |
| Nominal AC Operating Voltage: | 240 V  |
| Maximum AC Continuous Power:  | 9.0 kW |

**PV SYSTEM DISCONNECT SWITCH  
FOR UTILITY OPERATION  
BUILDING 19**


**WARNING**

**- RISK OF ELECTRIC SHOCK -**

Interactive System Point of Interconnection Ratings:

|                               |         |
|-------------------------------|---------|
| Rated AC Output Current:      | 73 A    |
| Nominal AC Operating Voltage: | 240 V   |
| Maximum AC Continuous Power:  | 17.4 kW |

ENGINEER APPROVAL:



*Roberto Rivera* 09/10/12

ROBERTO RIVERA, P.E. NO. 16743 DATE:

[illegible]

PREPARED BY:



6977 NAVAJO RD., SUITE 139  
SAN DIEGO, CA 92121  
PHONE: 858.270.9333  
FAX: 858.270.9334

THIS DOCUMENT IS CONSIDERED PROPRIETARY  
INTELLECTUAL PROPERTY AND CONTAINS PROPRIETARY  
INFORMATION UNDER UNITED STATES LAW. NO PORTION OR  
PART OF THIS DOCUMENT MAY BE REPRODUCED OR DIS-  
CLOSED WITHOUT THE EXPRESS WRITTEN PERMISSION OF  
SUSTINEO LLC.

OWNER/CIENT:

MADONNA ROAD APARTMENTS  
1550 MADONNA ROAD  
SAN LUIS OBISPO, CA 93405

 **Everyday Energy**  
SAVE MONEY SAVE THE PLANET

EVERYDAY ENERGY  
5865 AVENIDA ENCINAS,  
SUITE 142A  
CARLSBAD, CA, 92008  
P: (760) 607-7200

TITLE: PV IDENTIFICATION PLACARDS

PROJECT LOCATION: 1550 MADONNA ROAD  
SAN LUIS OBISPO, CA 93405

PHOTOVOLTAIC SYSTEM

|              |                         |
|--------------|-------------------------|
| PROJECT NO.: | 038 - 108               |
| APN:         | 140-040-003             |
| DATE:        | SEPTEMBER 10, 2012      |
| SHEET NO.:   | <b>P6.3</b><br>29 OF 30 |

## UTILITY DISCONNECT PLACARDS

Diagram of a rectangular warning label with dimensions and text specifications:

- Overall width: 7"
- Overall height: 4"
- Top section (red background):
  - Text: **WARNING** (white, 3/4" font)
  - Text: **- ELECTRIC SHOCK HAZARD -** (white, 1/4" font)
- Bottom section (white background):
  - Text: **IF A GROUND FAULT IS INDICATED, NORMALLY GROUNDING CONDUCTORS MAY BE UNDERGROUND AND ENERGIZED.** (black, 3/16" font)

|    |                              |
|----|------------------------------|
| 11 | GROUND FAULT WARNING PLACARD |
|----|------------------------------|

7"

4"

4"

RED SIGNAGE W/  
WHITE 3/4" FONT

WHITE 1/4" FONT

WHITE 3/16" FONT

**WARNING**

SECONDARY POWER SOURCE  
CUSTOMER OWNED PV SYSTEM  
PARALLEL GENERATION

Diagram of a blue sign with white text. The sign is 6 inches wide and 4 inches high. The text on the sign is:

- FOR WARRANTY OR SERVICE  
PLEASE CONTACT
- EVERDAY ENERGY  
(760) 607-7200
- 804 PIER VIEW WAY, SUITE 201  
OCEANSIDE, CA 92054  
[www.everydayenergy.us](http://www.everydayenergy.us)

Annotations:

- BLUE SIGNAGE W/ WHITE 1/4" FONT
- WHITE 3/16" FONT

BLACK SIGNAGE  
W/ WHITE 1/4" FONT

PV SYSTEM BREAKER 'A'

4"

BLACK SIGNAGE  
W/ WHITE 1/4" FONT

PV SYSTEM BREAKER 'B'

4"

## 10 PV SYSTEM BREAKER PLACARD

## 12 PARALLEL GENERATION WARNING PLACARD



















15 WARRANTY PLACARD

PLACARD & 2011 NEC IDENTIFICATION NOTES:

- |       |   |
|-------|---|
| 1 - 3 | INSTALL ON CORRESPONDING COMBINER BOXES - NEC 690.17 & 690.53   |
| 4 - 6 | INSTALL ON CORRESPONDING INVERTER ASSEMBLIES - NEC 690.17 & 690.53  |
| 7     | MANUFACTURE THREE PLACARDS. INSTALL ONE ON EACH AC/UTILITY DISCONNECT SWITCH CORRESPONDING TO EACH INVERTER.                            |
| 8     | MANUFACTURE THREE PLACARDS.<br>INSTALL NEXT TO GROUND FAULT INDICATOR - NEC 690.5 (C)   |
| 9     | MANUFACTURE THREE PLACARDS.<br>INSTALL ON MAIN LOAD PANEL ADJACENT TO INTERCONNECTION POINT - NEC 690.4 (B)4                            |
| 10    | MANUFACTURE THREE PLACARDS.<br>INSTALL ON OUTSIDE OF BUILDING ADJACENT TO UTILITY OWNED EQUIPMENT OR INTERCONNECTION POINT - NEC 690.56 |
| 11    | MANUFACTURE THREE PLACARDS.<br>INSTALL ON VISIBLE BLADE DISCONNECT - NEC 690.4 (B)7   |
| 12    | MANUFACTURE THREE PLACARDS.<br>INSTALL ON INVERTER ASSEMBLY   |

## UTILITY DISCONNECT PLACARDS



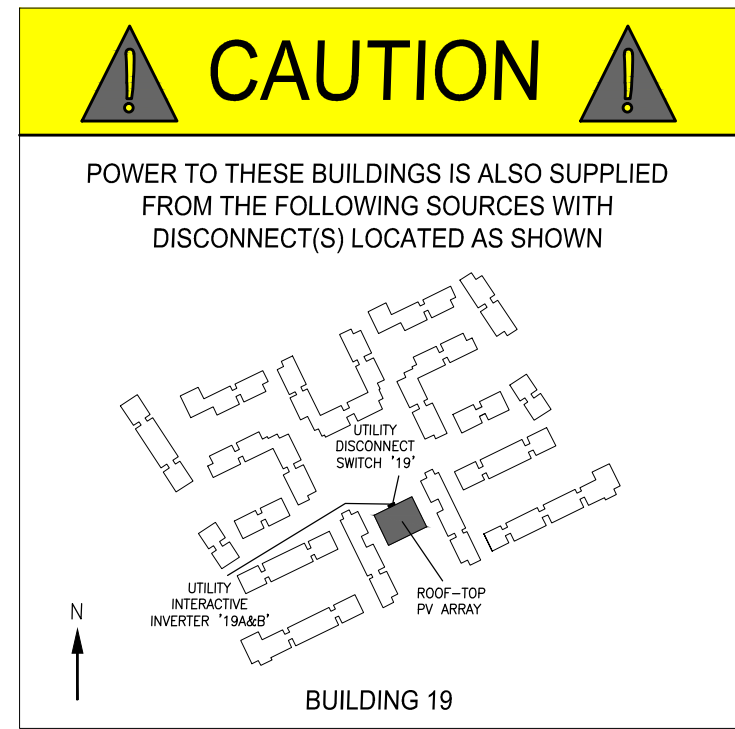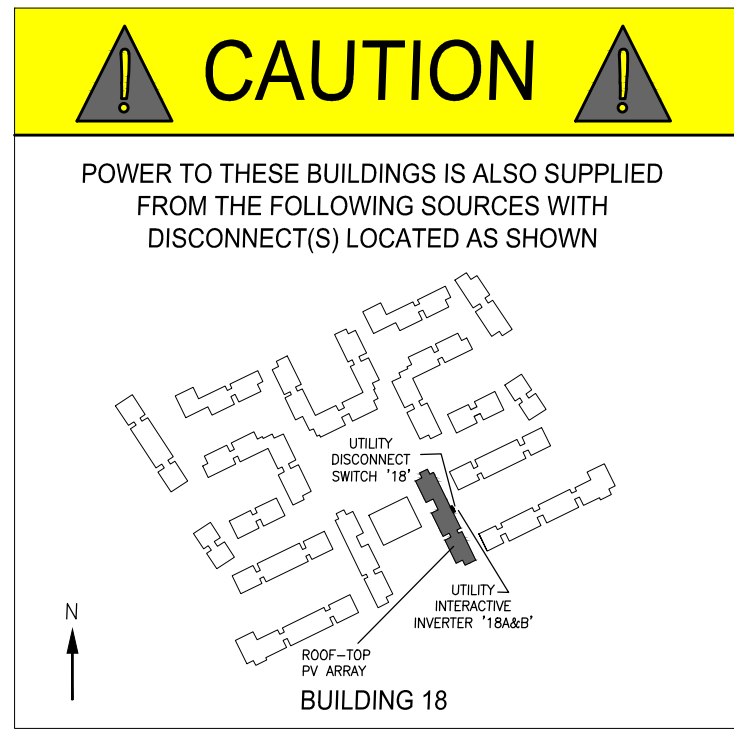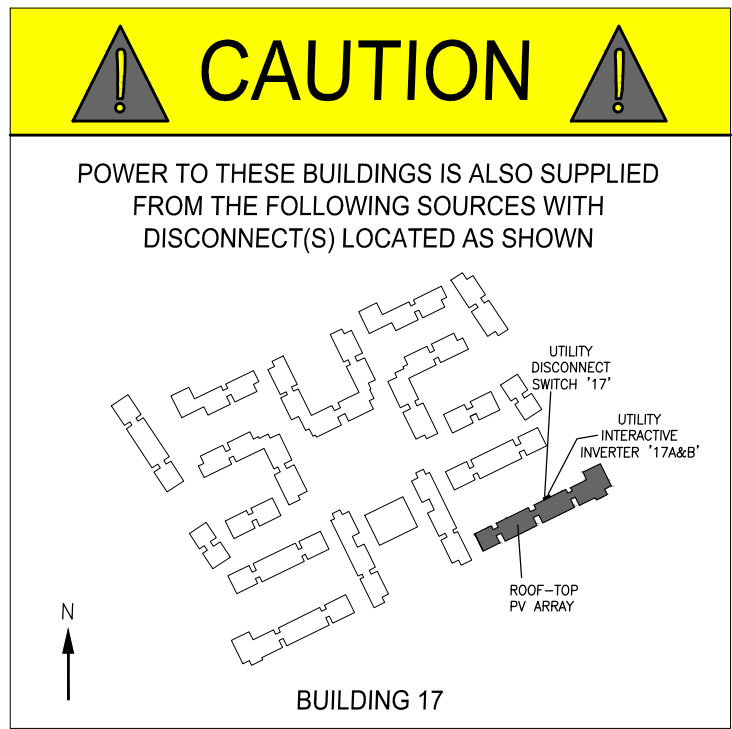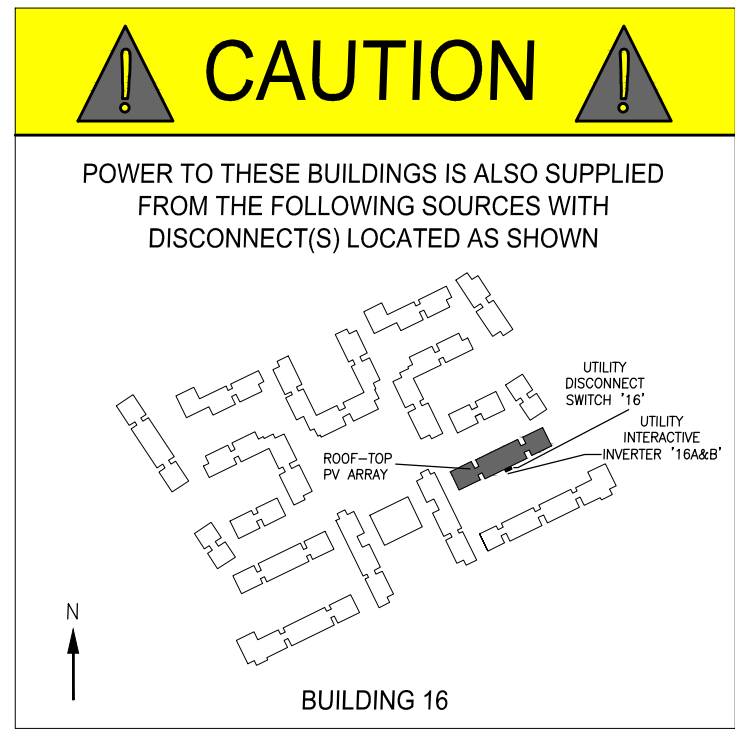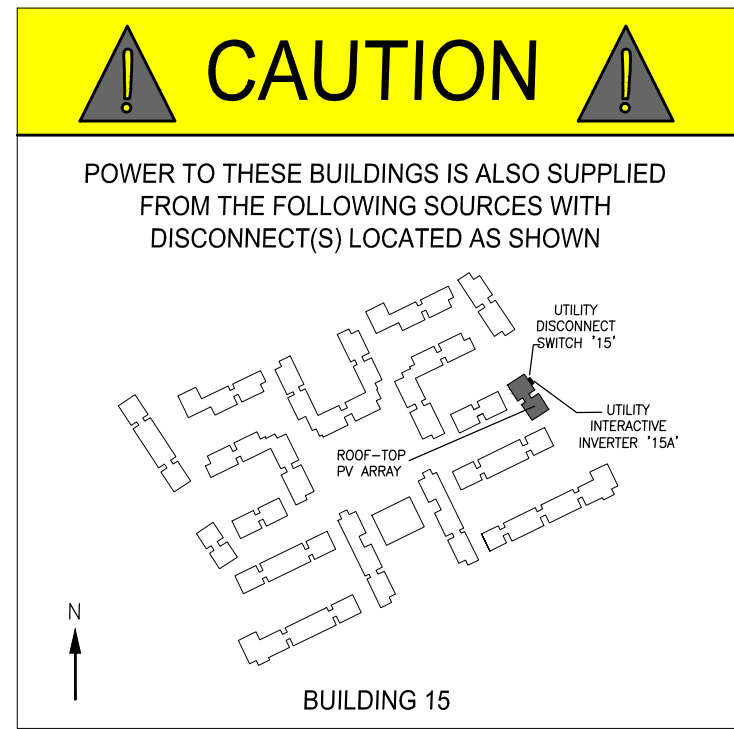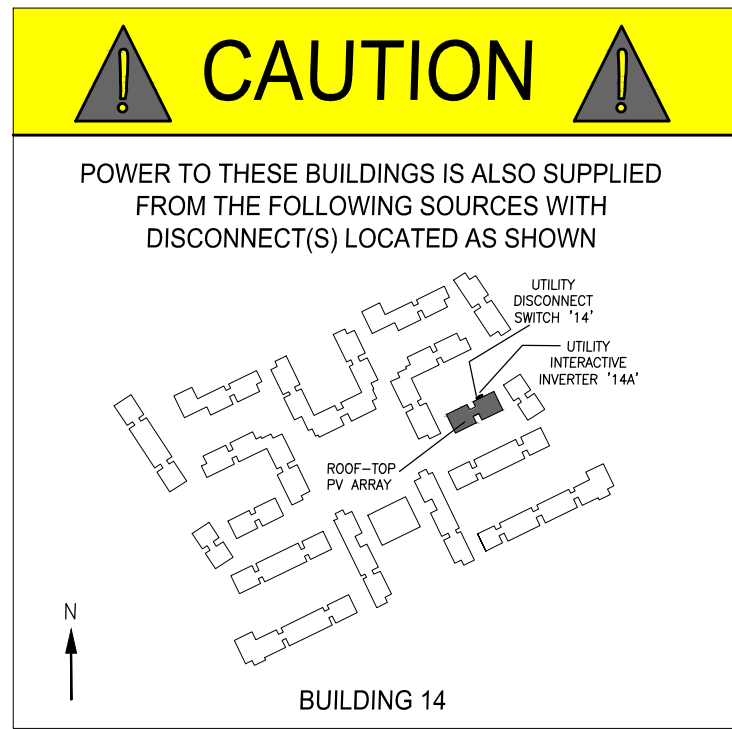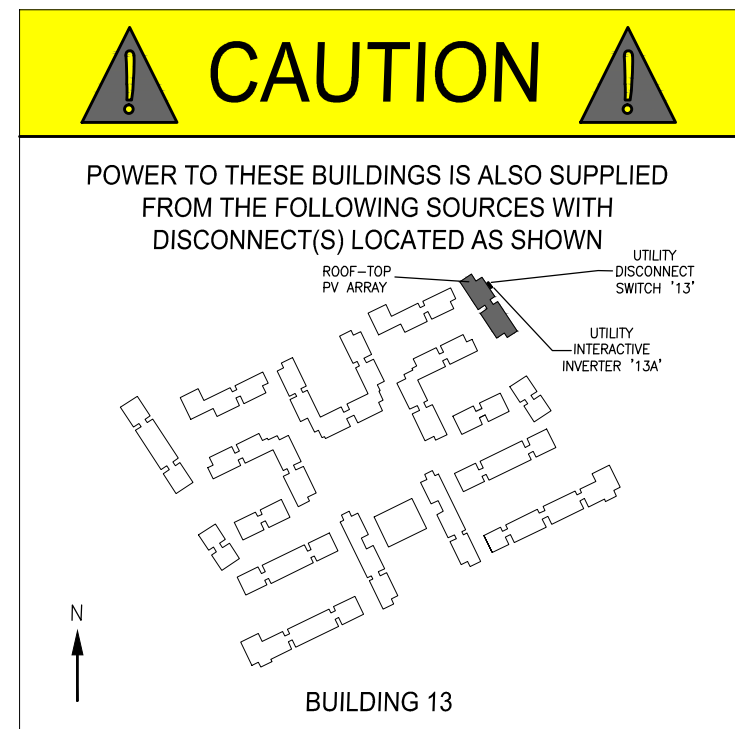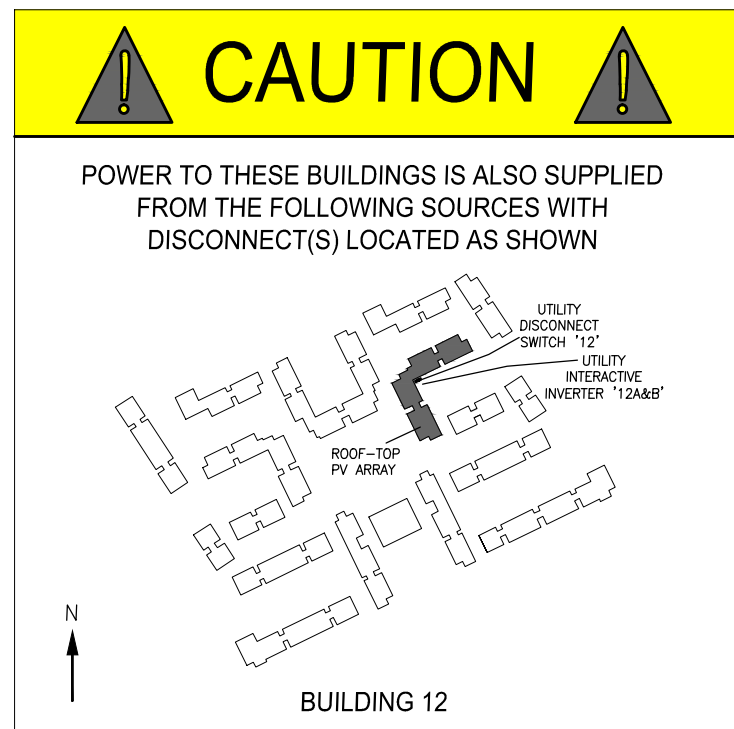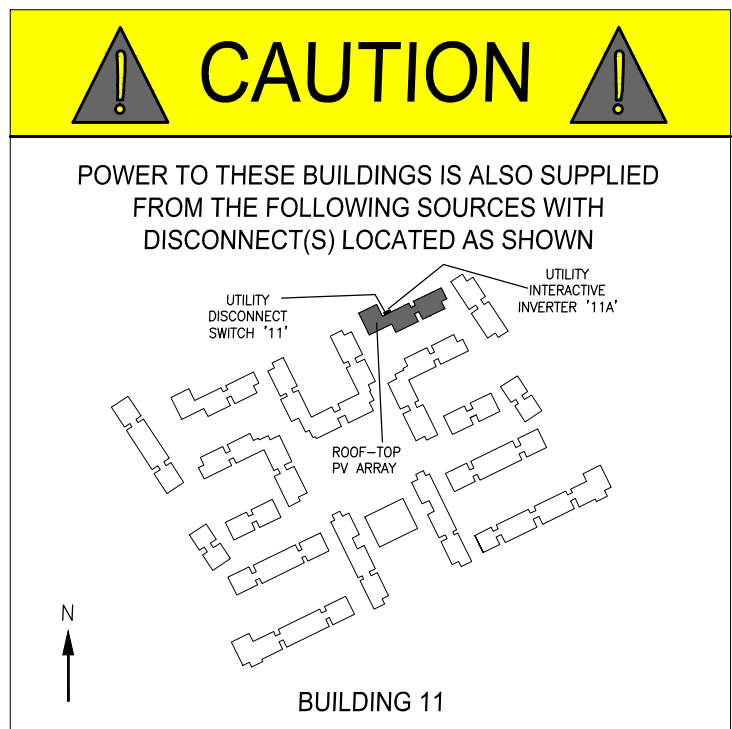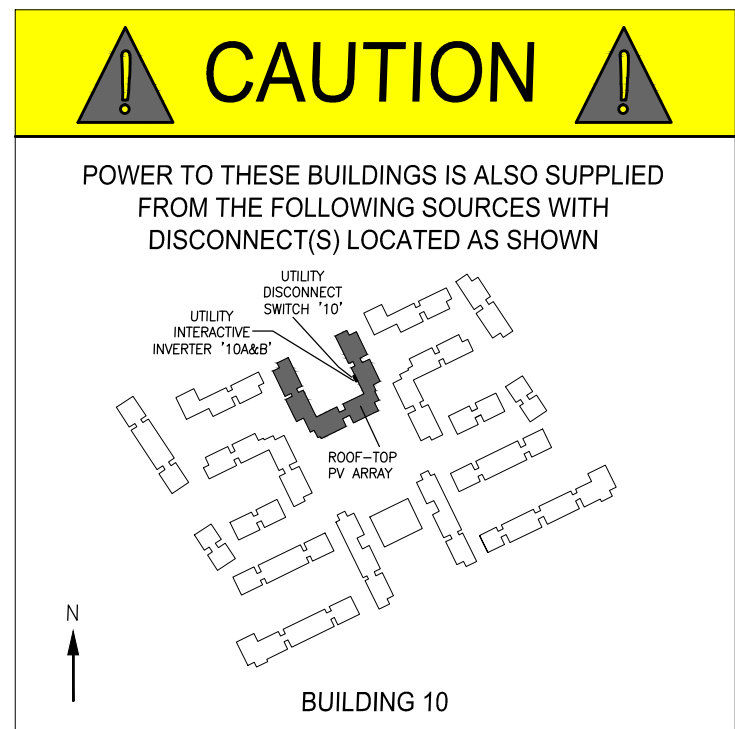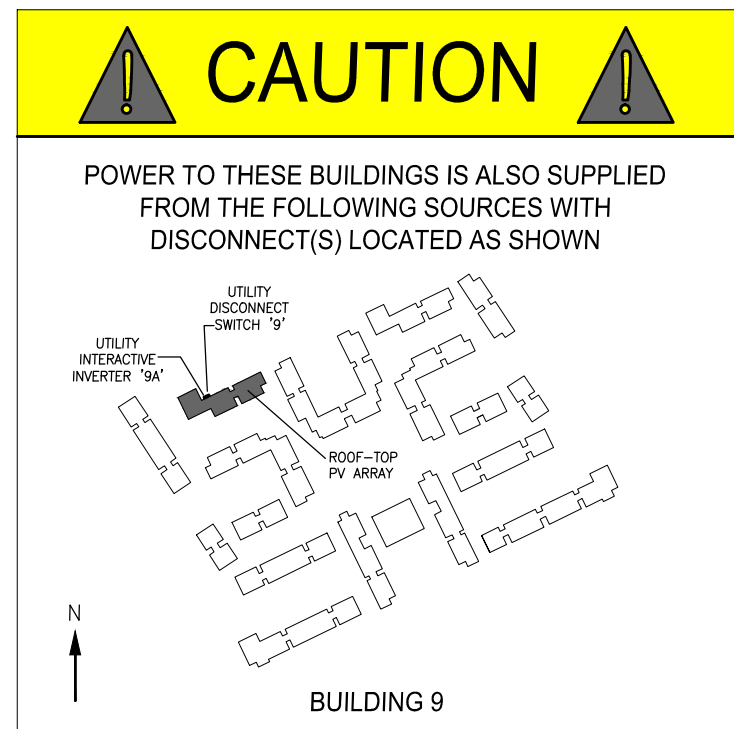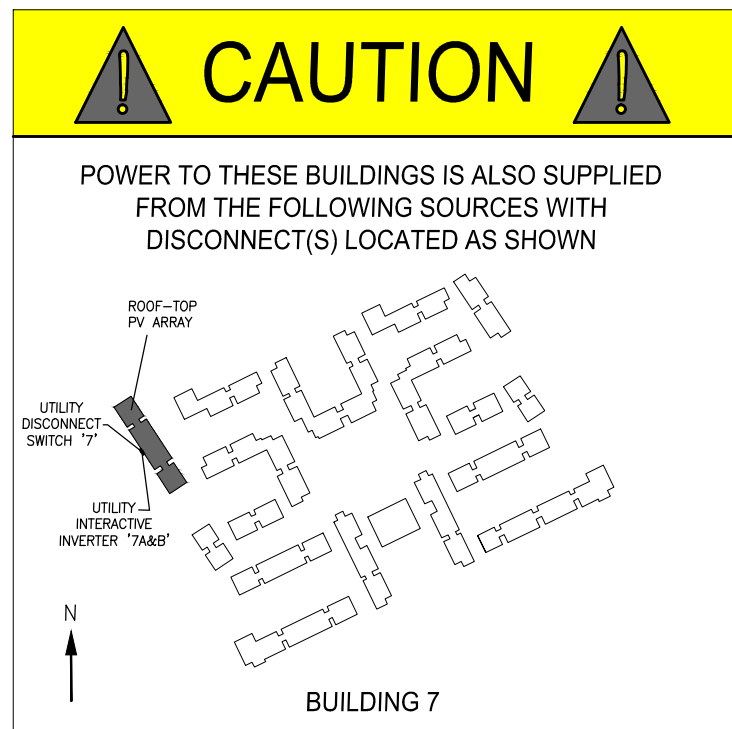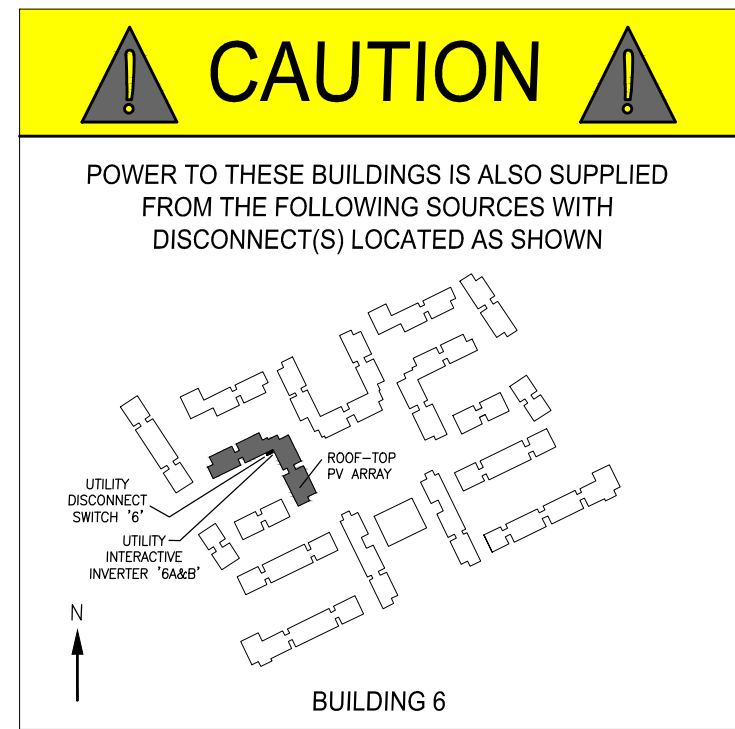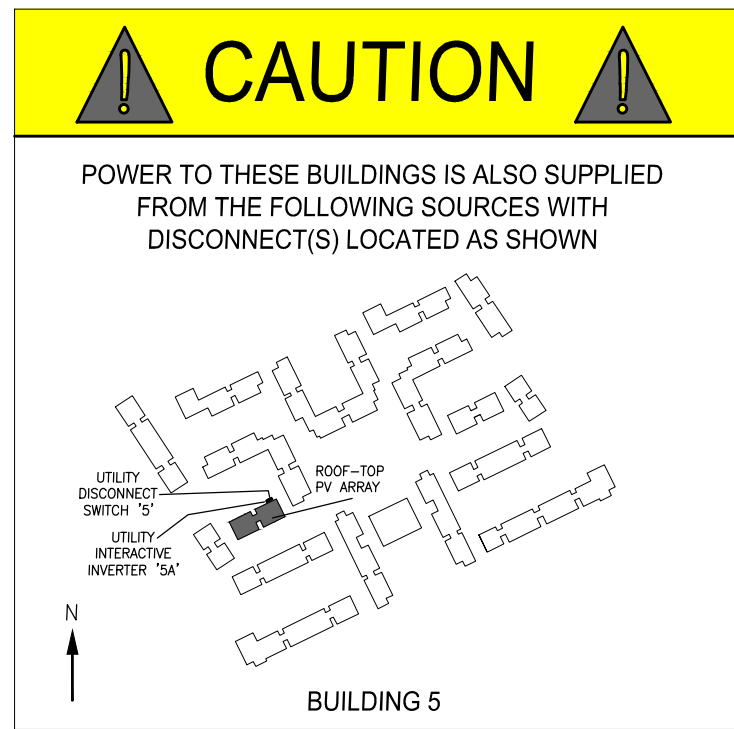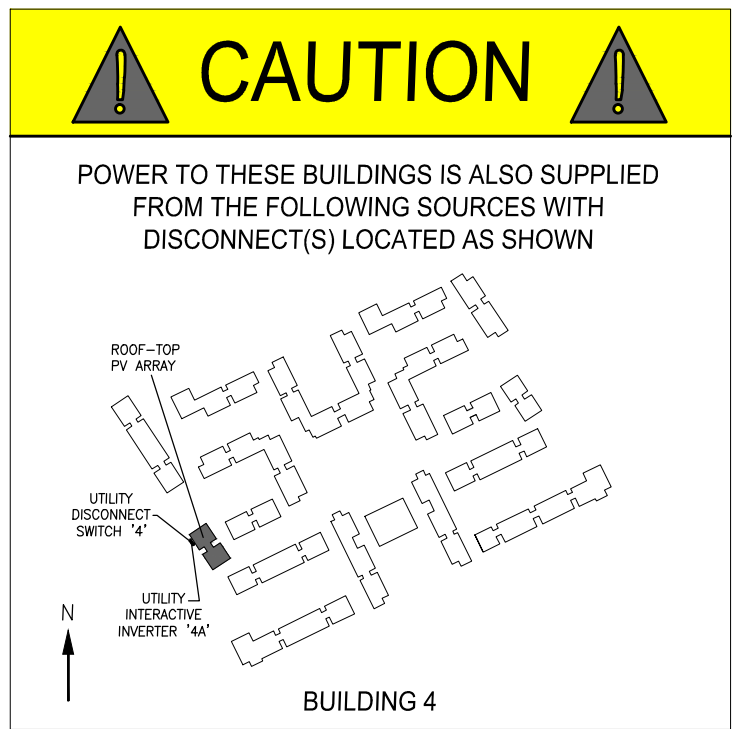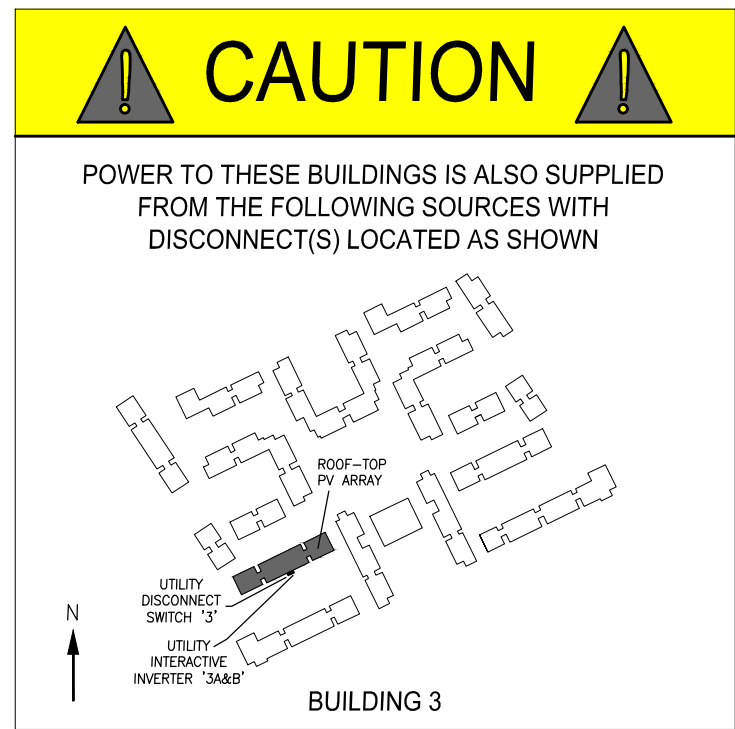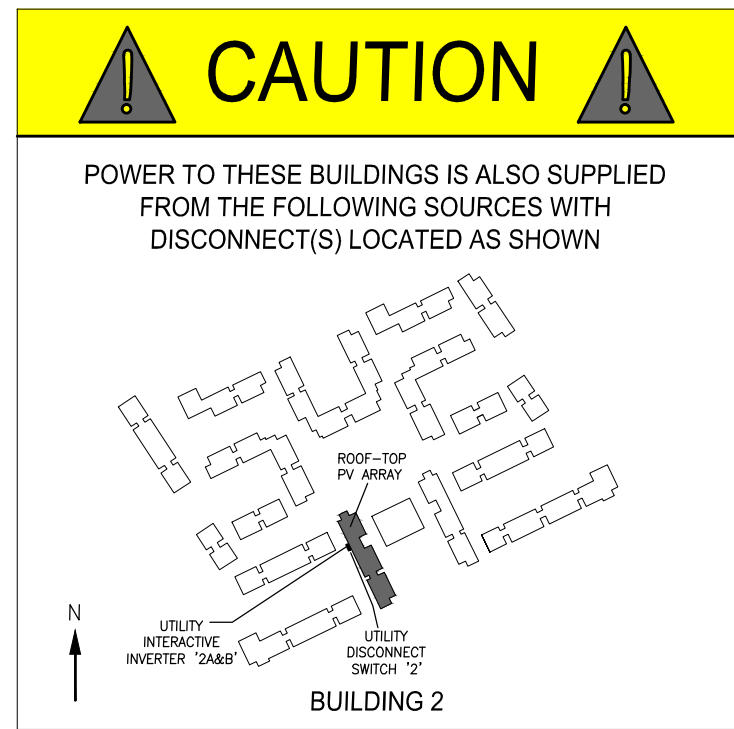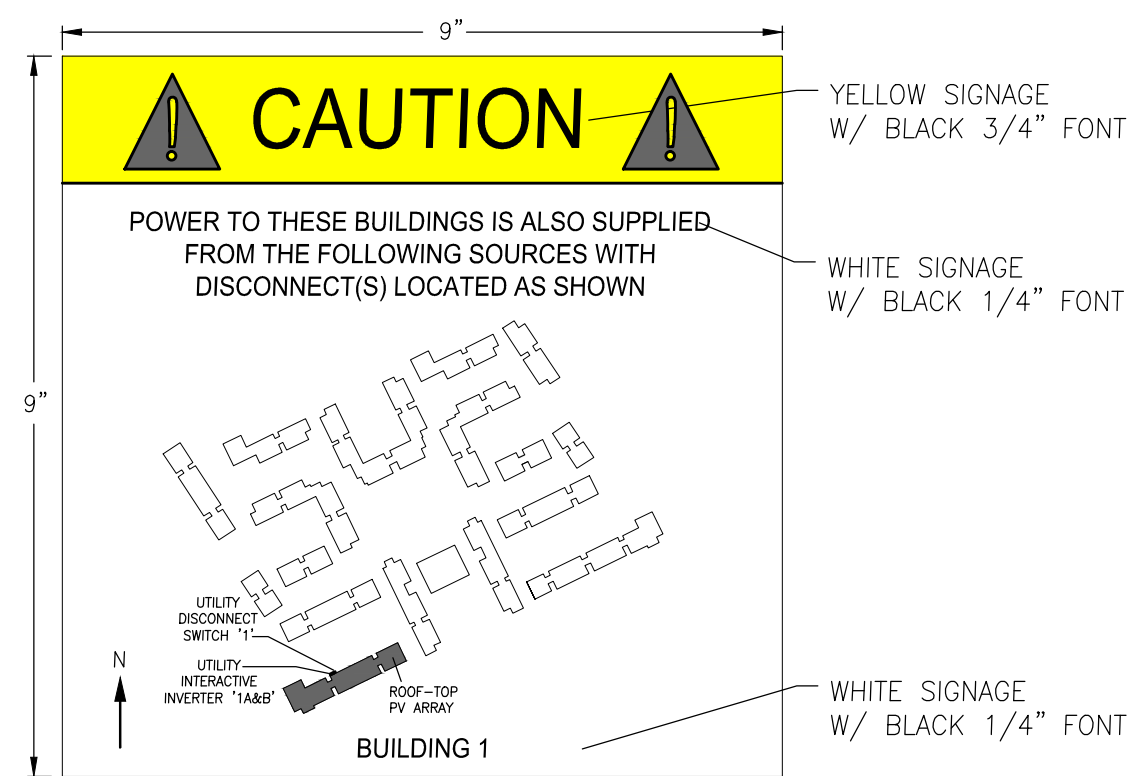

PLACARD & 2011 NEC IDENTIFICATION NOTES:


- 1 - 3 INSTALL ON CORRESPONDING COMBINER BOXES - NEC 690.17 & 690.53
- 4 - 6 INSTALL ON CORRESPONDING INVERTER ASSEMBLIES - NEC 690.17 & 690.53
- 7 MANUFACTURE THREE PLACARDS. INSTALL ONE ON EACH AC/UTILITY DISCONNECT SWITCH CORRESPONDING TO EACH INVERTER.
- 8 MANUFACTURE THREE PLACARDS. INSTALL NEXT TO GROUND FAULT INDICATOR - NEC 690.5 (C)
- 9
- 10
- 11
- 12

- MANUFACTURE THREE PLACARDS. INSTALL ON MAIN LOAD PANEL ADJACENT TO INTERCONNECTION POINT - NEC 690.4 (B)4
- MANUFACTURE THREE PLACARDS. INSTALL ON OUTSIDE OF BUILDING ADJACENT TO UTILITY OWNED EQUIPMENT OR INTERCONNECTION POINT - NEC 690.56
- MANUFACTURE THREE PLACARDS. INSTALL ON VISIBLE BLADE DISCONNECT - NEC 690.4 (B)7
- MANUFACTURE THREE PLACARDS. INSTALL ON INVERTER ASSEMBLY

GENERAL EQUIPMENT NOTES:

1. THE PLACARDS SHALL BE METAL OR PLASTIC WITH ENGRAVED OR MACHINE PRINTED LETTERS OR ELECTRO-PHOTO PLATING IN A CONTRASTING COLOR TO THE PLAQUE.
2. PLAQUES SHALL BE ATTACHED TO THE EXTERIOR OF THE EQUIPMENT ENCLOSURE WITH POP RIVETS, MACHINE SCREWS, OR OTHER FASTENERS ACCEPTABLE TO THE AHJ.


ENGINEER APPROVAL:

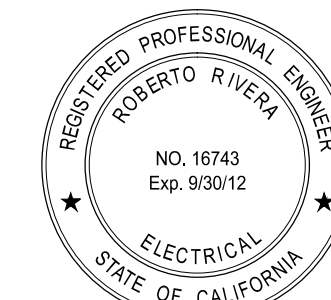

Roberto Rivera 09/10/12  
ROBERTO RIVERA, P.E. NO. 16743 DATE:

| REV. | DATE    | DESCRIPTION                |
|------|---------|----------------------------|
| 1    | 9/10/12 | 100% CONSTRUCTION DRAWINGS |

PREPARED BY:

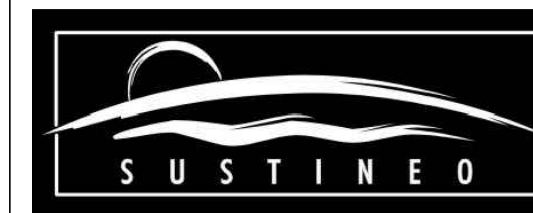

6977 NAVAJO RD., SUITE 139  
SAN DIEGO, CA 92119  
PHONE: 858.270.9333  
FAX: 858.270.9334

THIS DOCUMENT IS CONSIDERED PROTECTED INTELLECTUAL PROPERTY AND CONTAINS PROPRIETARY INFORMATION UNDER UNITED STATES LAW. NO PORTION OR PART OF THIS DOCUMENT MAY BE REPRODUCED FOR ANY PURPOSE WITHOUT THE EXPRESS WRITTEN PERMISSION OF SUSTINED CORP.

OWNER/CLIENT:

MADONNA ROAD APARTMENTS  
1550 MADONNA ROAD  
SAN LUIS OBISPO, CA 93405



EVERYDAY ENERGY  
5865 AVENIDA ENCINAS,  
SUITE 142A  
CARLSBAD, CA, 92008  
P: (760) 607-7200

PV IDENTIFICATION PLACARDS

PHOTOVOLTAIC SYSTEM

1550 MADONNA ROAD  
SAN LUIS OBISPO, CA 93405

PROJECT NO.: 038 - 108  
APN: 140-040-003  
DATE: SEPTEMBER 10, 2012  
SHEET NO.:

P6.4  
30 OF 30